


Note: Bearings shown are based on The Ohio State Plane but are used to describe angles only.


Being known as Part of Original Lot 21 of the Township of Amherst Now in the City of Amherst, County of Lorain and the State of Ohio, and known as Lorain County Parcel Number 05-00-021-102-014.

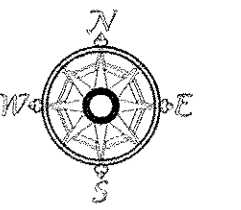

0 100'
Scale 1" = 100'
July 15, 2017

Cooper Foster Park Road 60'

Cooper Foster Park Road 60'

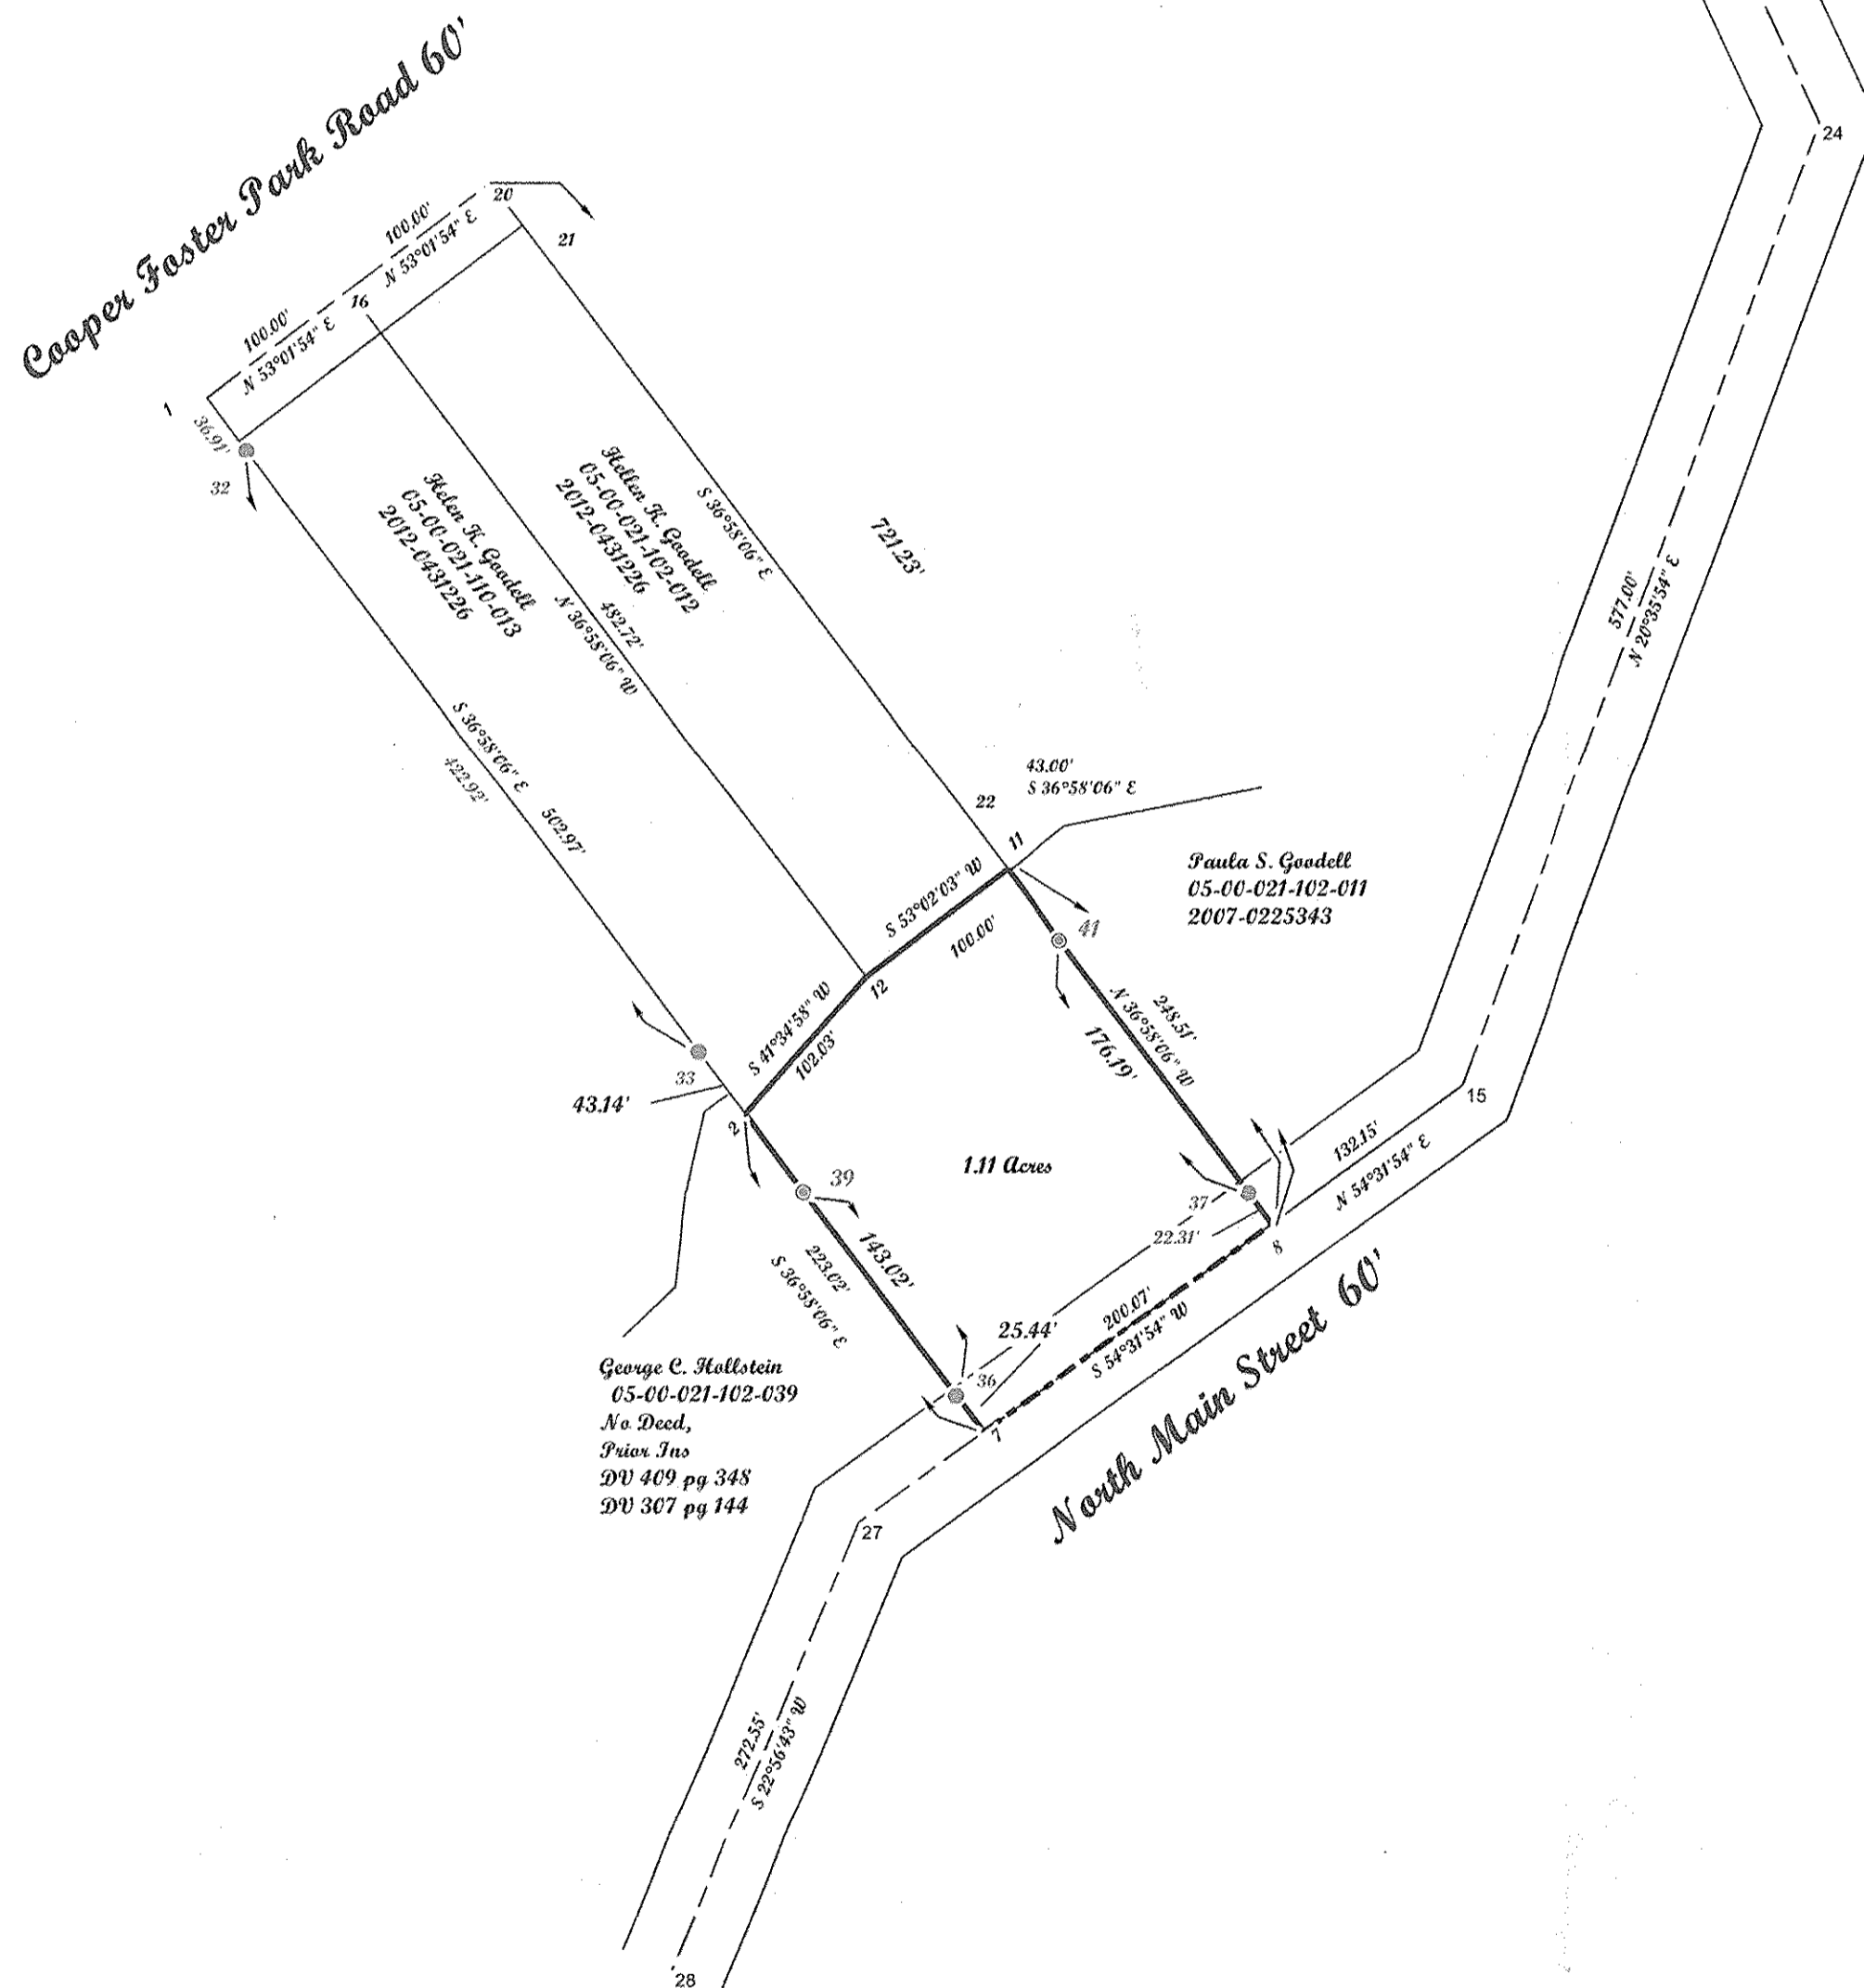

APPROVED
LORAIN CO.
MAY 17 2017
DATE 8-7-17
PAGE 5 00-021
BY R. MAINES
#17-03722A

05-00-021-102-014

Point Table

POINTS	NORTHING	EASTING	DESE
1	637490.03	2043467.88	
2	637088.17	2043770.35	
7	636909.99	2043904.47	
8	637026.08	2044067.42	
11	637224.63	2043917.97	
12	637164.49	2043838.07	
14	632576.43	2038382.95	
15	637102.76	2044175.05	
16	637350.17	2043547.78	
20	637610.31	2043627.68	
21	637580.82	2043649.87	
22	637258.98	2043892.11	
24	637642.87	2044378.04	
25	638307.36	2044063.68	
26	638307.05	2044935.98	
27	636859.52	2043833.63	
28	636608.53	2043727.38	
32	637460.54	2043490.08	TRON PIN FOUND 4
33	637122.64	2043744.41	TRON PIN FOUND 5
36	636930.15	2043888.95	TRON PIN FOUND
37	637043.50	2044053.91	TRON PIN FOUND
39	637044.46	2043802.99	REBAR SET
41	637184.32	2043948.02	REBAR SET

McGannon Surveying, LLC
Boundary Survey
Patrick A. McGannon
Registered Professional Surveyor
1731 Gettysburg Drive, Lorain, Ohio 44053 (440) 282-2712
www.mcgannonsurveying.com

Note: Only copies signed with Red ink shall be considered Valid.

Patrick A. McGannon
Patrick A. McGannon P.S. 7154

Prepared for Jim Goodell of
3670 Brownhelm Station Road
Vermilion, Ohio 44089.



P.S.C.

Note: Dimensions shown in Blue are record values and those shown in red are field observed values.

Goodell, Inc.

S.N. 1540