

APPROVED
LOPICK CO.
MUNICIPALITY


DATE 10-30-17

PAGE 5-00-039

BY R. MAINES

#17-03796 D

05-00-039-105-024

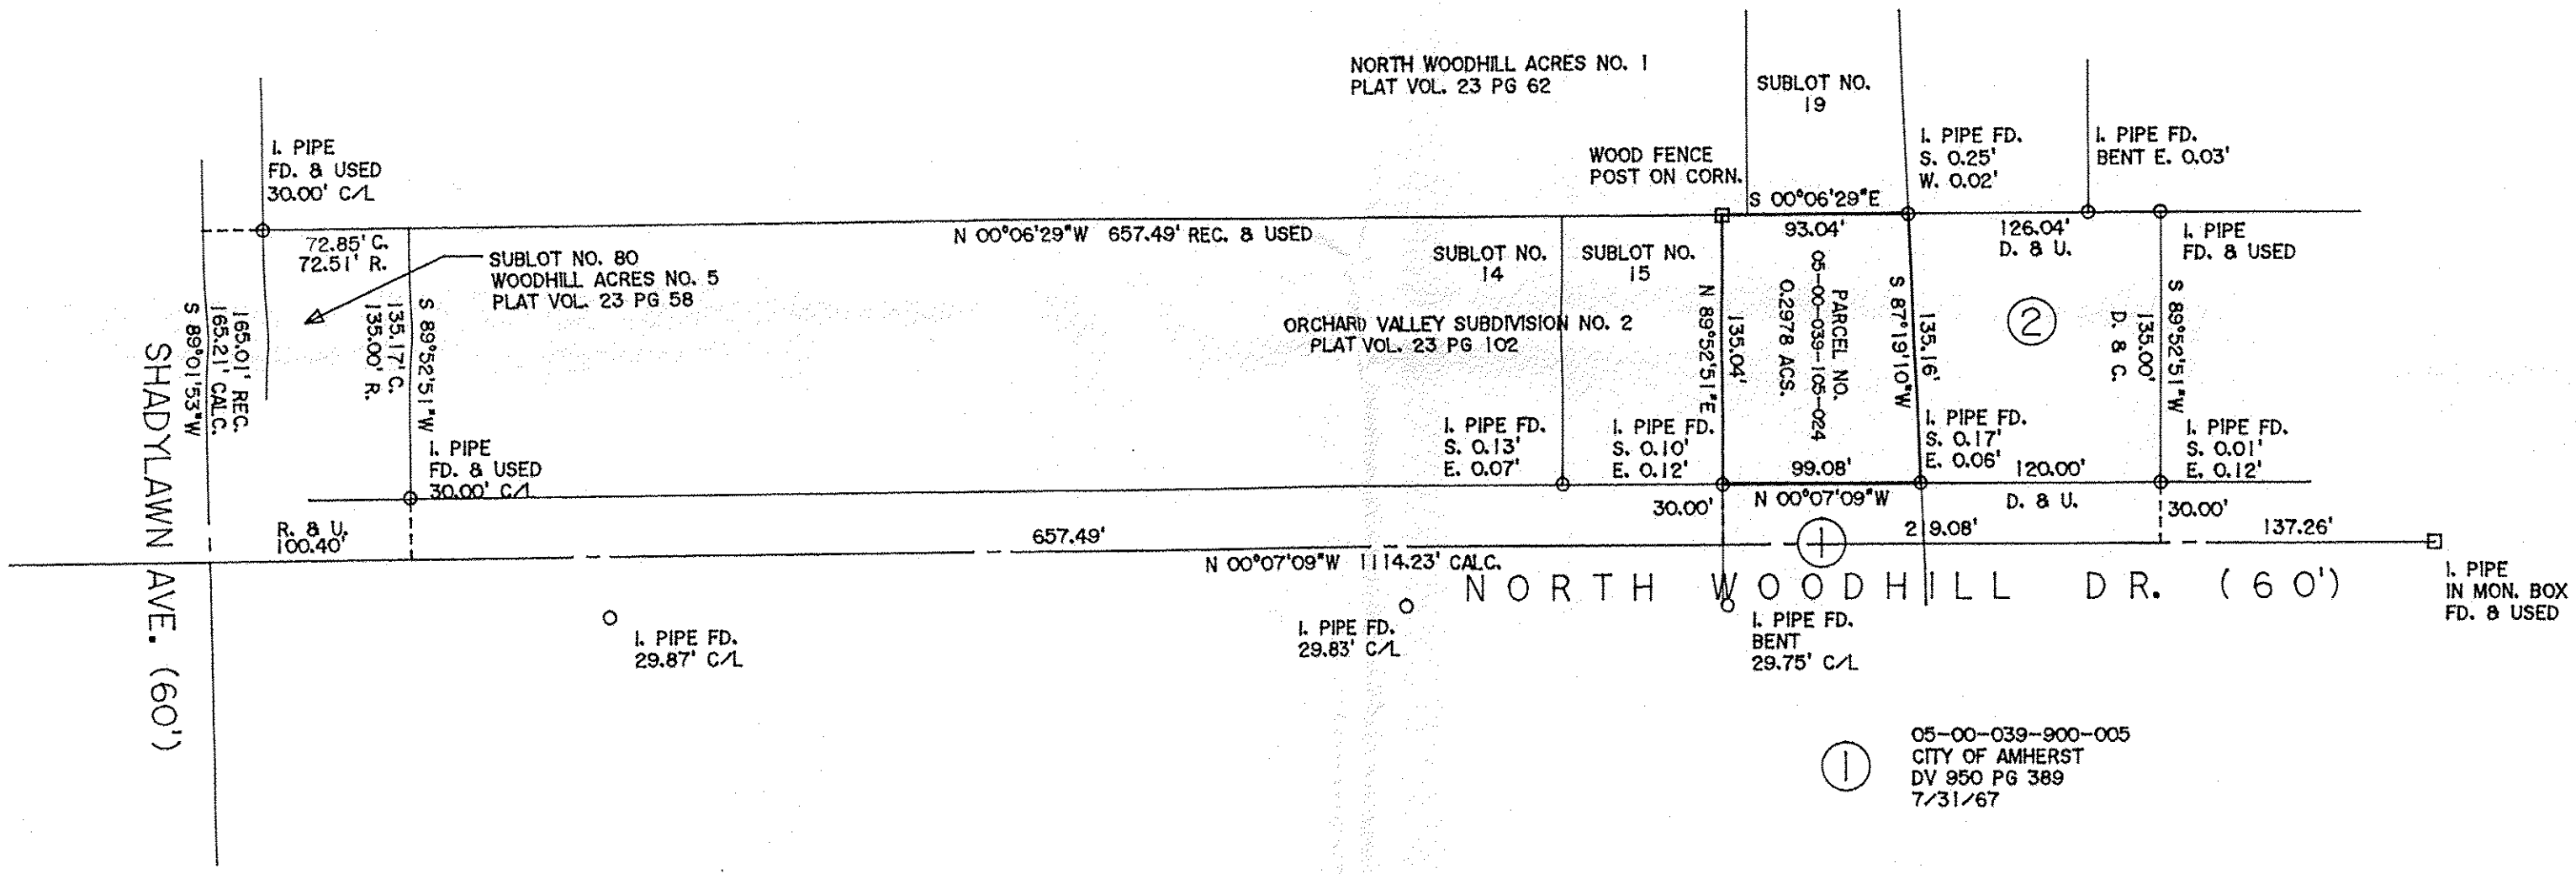

- ① 05-00-039-900-005
CITY OF AMHERST
DV 950 PG 389
7/31/67
- ② 05-00-039-105-030
DENNIS A. & GAIL K. BODZASH
ORV 1401 PG. 574
7/21/86

DIMENSIONS SHOWN ON THIS PLAT ARE EXPRESSED IN FEET AND DECIMAL PARTS THEREOF. ALL BEARINGS ARE TO AN ASSUMED MERIDIAN AND ARE USED TO INDICATE ANGLES ONLY. PERMANENT MONUMENTS WERE FOUND OR SET AT ALL POINTS INDICATED HEREON, ALL OF WHICH I CERTIFY TO BE CORRECT.

PLAT OF BOUNDARY SURVEY FOR MILLER HOME TITLE

BEING KNOWN AS PART OF AMHERST TOWNSHIP ORIGINAL LOT NO. 39
CITY OF AMHERST COUNTY OF LORAIN
STATE OF OHIO

OCTOBER, 2017 SCALE: 1" = 80'

THOMAS SIMON & ASSOCIATES, INC.
PROFESSIONAL LAND SURVEYORS

150 SOUTH OLIVE STREET
ELYRIA, OHIO 44035

(440) 327-2925
FAX 327-2964

BASIS OF BEARINGS IS THE CENTERLINE OF NORTH WOODHILL DRIVE (NORTH 00°07'09" WEST).

THOMAS A. SIMON
S-7775

Thomas A. Simon

THOMAS A. SIMON
REG. PROFESSIONAL SURVEYOR
NO. S-7775