


REFERENCE LORAIN COUNTY MONUMENTS 9-15-17

MON REF 1/4" PIN FD E GRIGGS @ ORIGINAL LOT

○ - INDICATES MAGNAIL SET APPROX. 2' FROM MON.

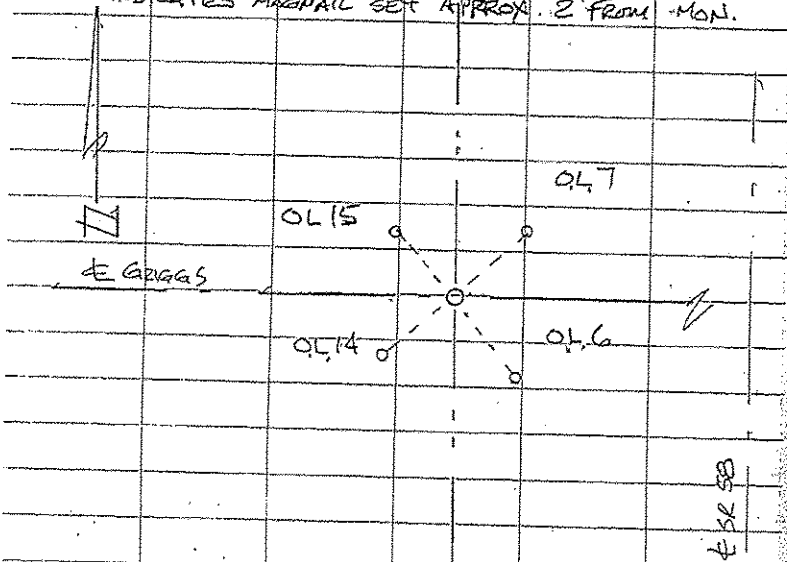


Pin was not disturbed
during Mon Box Installation by GDA

MON REF RRS FOUND w/ CHIS +

CARR & GRIGGS

○ - INDICATES MAGNAIL SET APPROX 2' FROM MON

E GRIGGS

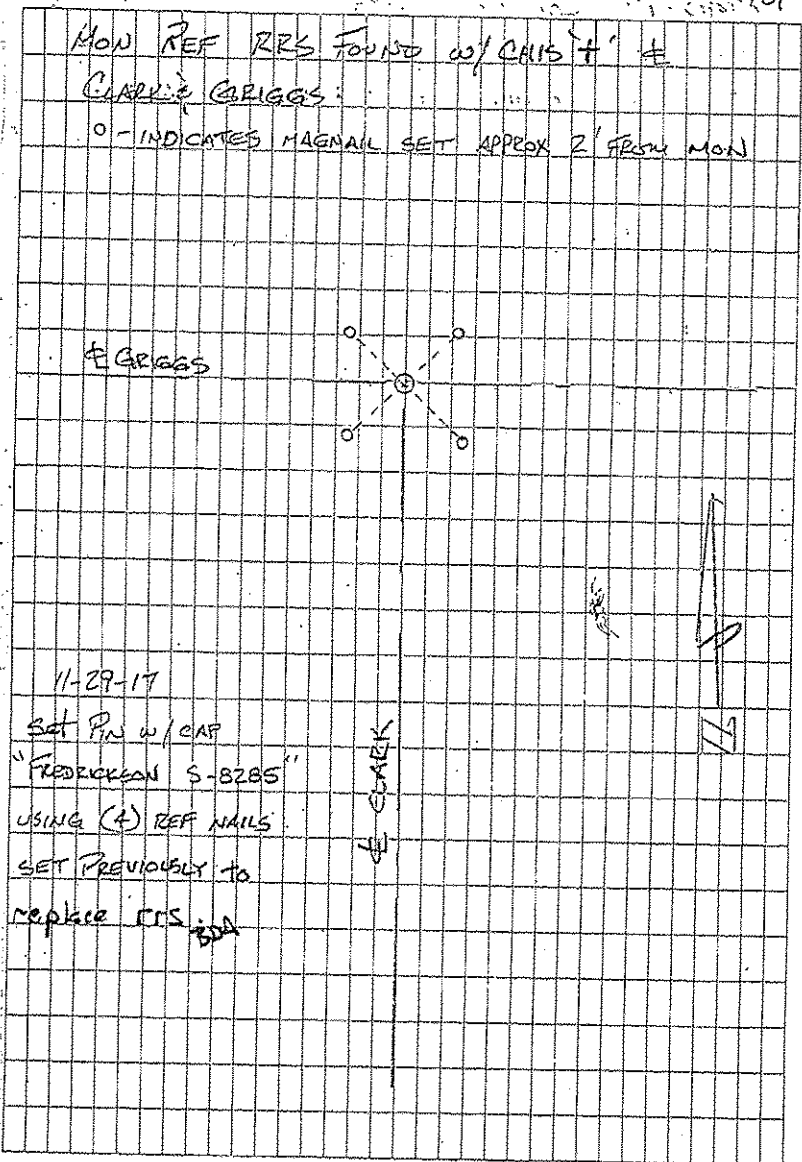

11-29-17

Set Pin w/ CAP
"FREDRICKSON S-8285"
USING (+) REF NAILS
SET PREVIOUSLY TO
replace CRS by GDA