

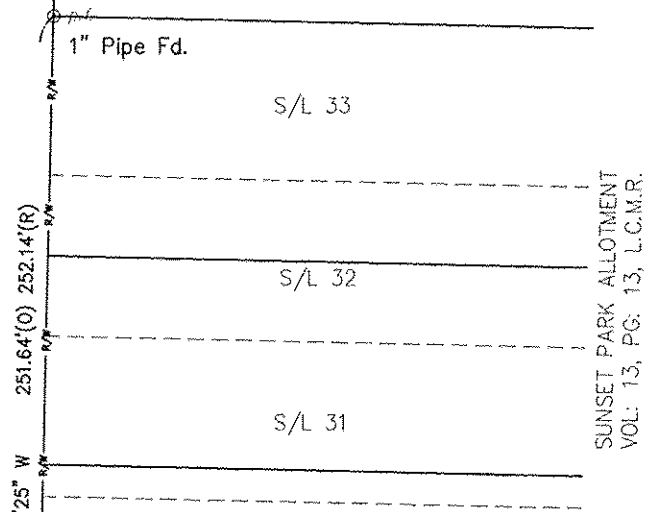
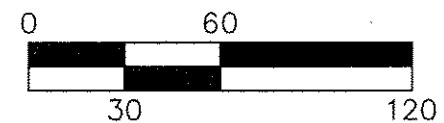


EXHIBIT OF LORAIN COUNTY
 PARCEL NO: 04-00-019-112-055

JAYCOX RD ~ 60'

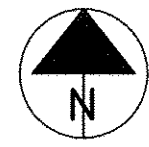


EZT of OHIO, LLC
 Parcel No: 04-00-019-112-045
 Inst. No: 2006-0161925

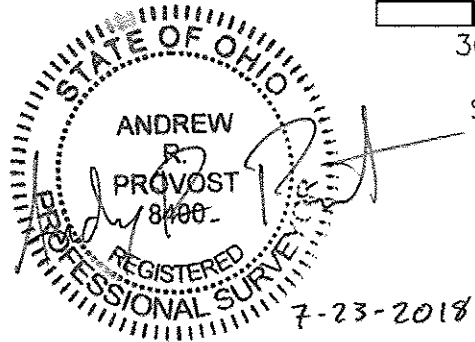

Horizontal Scale in Feet

APPROVED
 LORAIN CO.
 7-26-18
 PAGE 4-00-019
 BY R. MAINES
 #18-03932-C

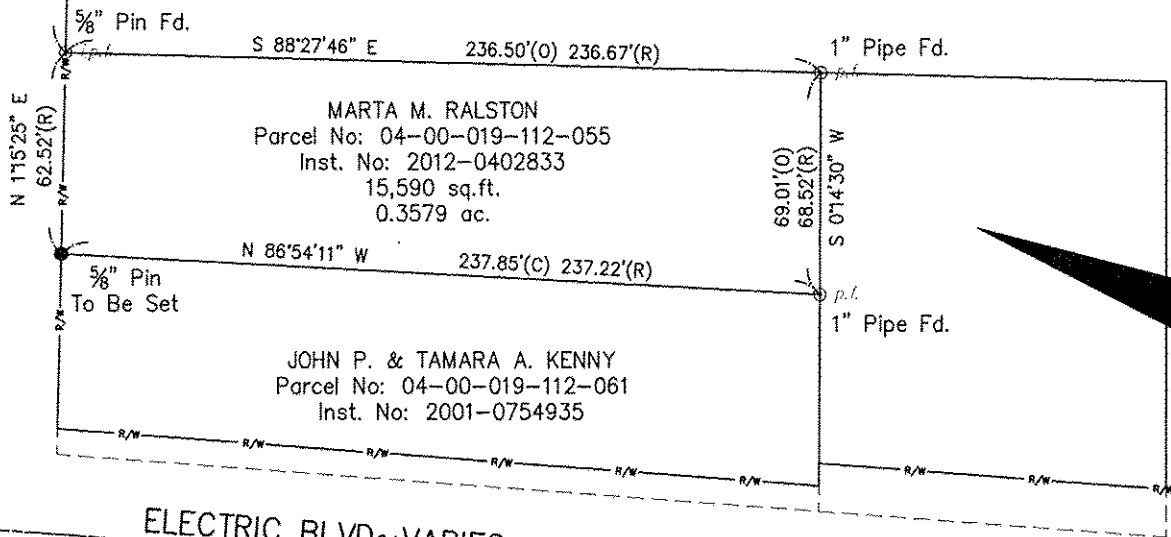

LEGEND:

- (O) OBSERVED
- (R) RECORD
- o *i.p.f.* MONUMENT FOUND
- MONUMENT SET

AMY TURLEY &
 PAUL GREENWELL
 Parcel No: 04-00-019-112-054
 Parcel No: 04-00-019-112-062
 Inst. No: 2004-0045631

04-00-019-112-055