


Timothy D. Hozański, P.S.
 Date: 5-17-18
 REVISED 6-01-18
 REVISED 7-16-18

Lake Shore Railway Assoc., Inc.
 Official Record Vol. 1467, Pg. 651
 Parcel # 05-00-064-000-069

Dr. M. Yu & F. Shu-Eng Yu &
 Dr. Yun-Lai Sun & Feng-Wu Sun
 Instrument # 2003-0970019
 Parcel # 05-00-064-000-080

5/8" IRON PIN WITH
 "KELSER" CAP
 FOUND & USED FOR LINE
 FLUSH W/ GROUND

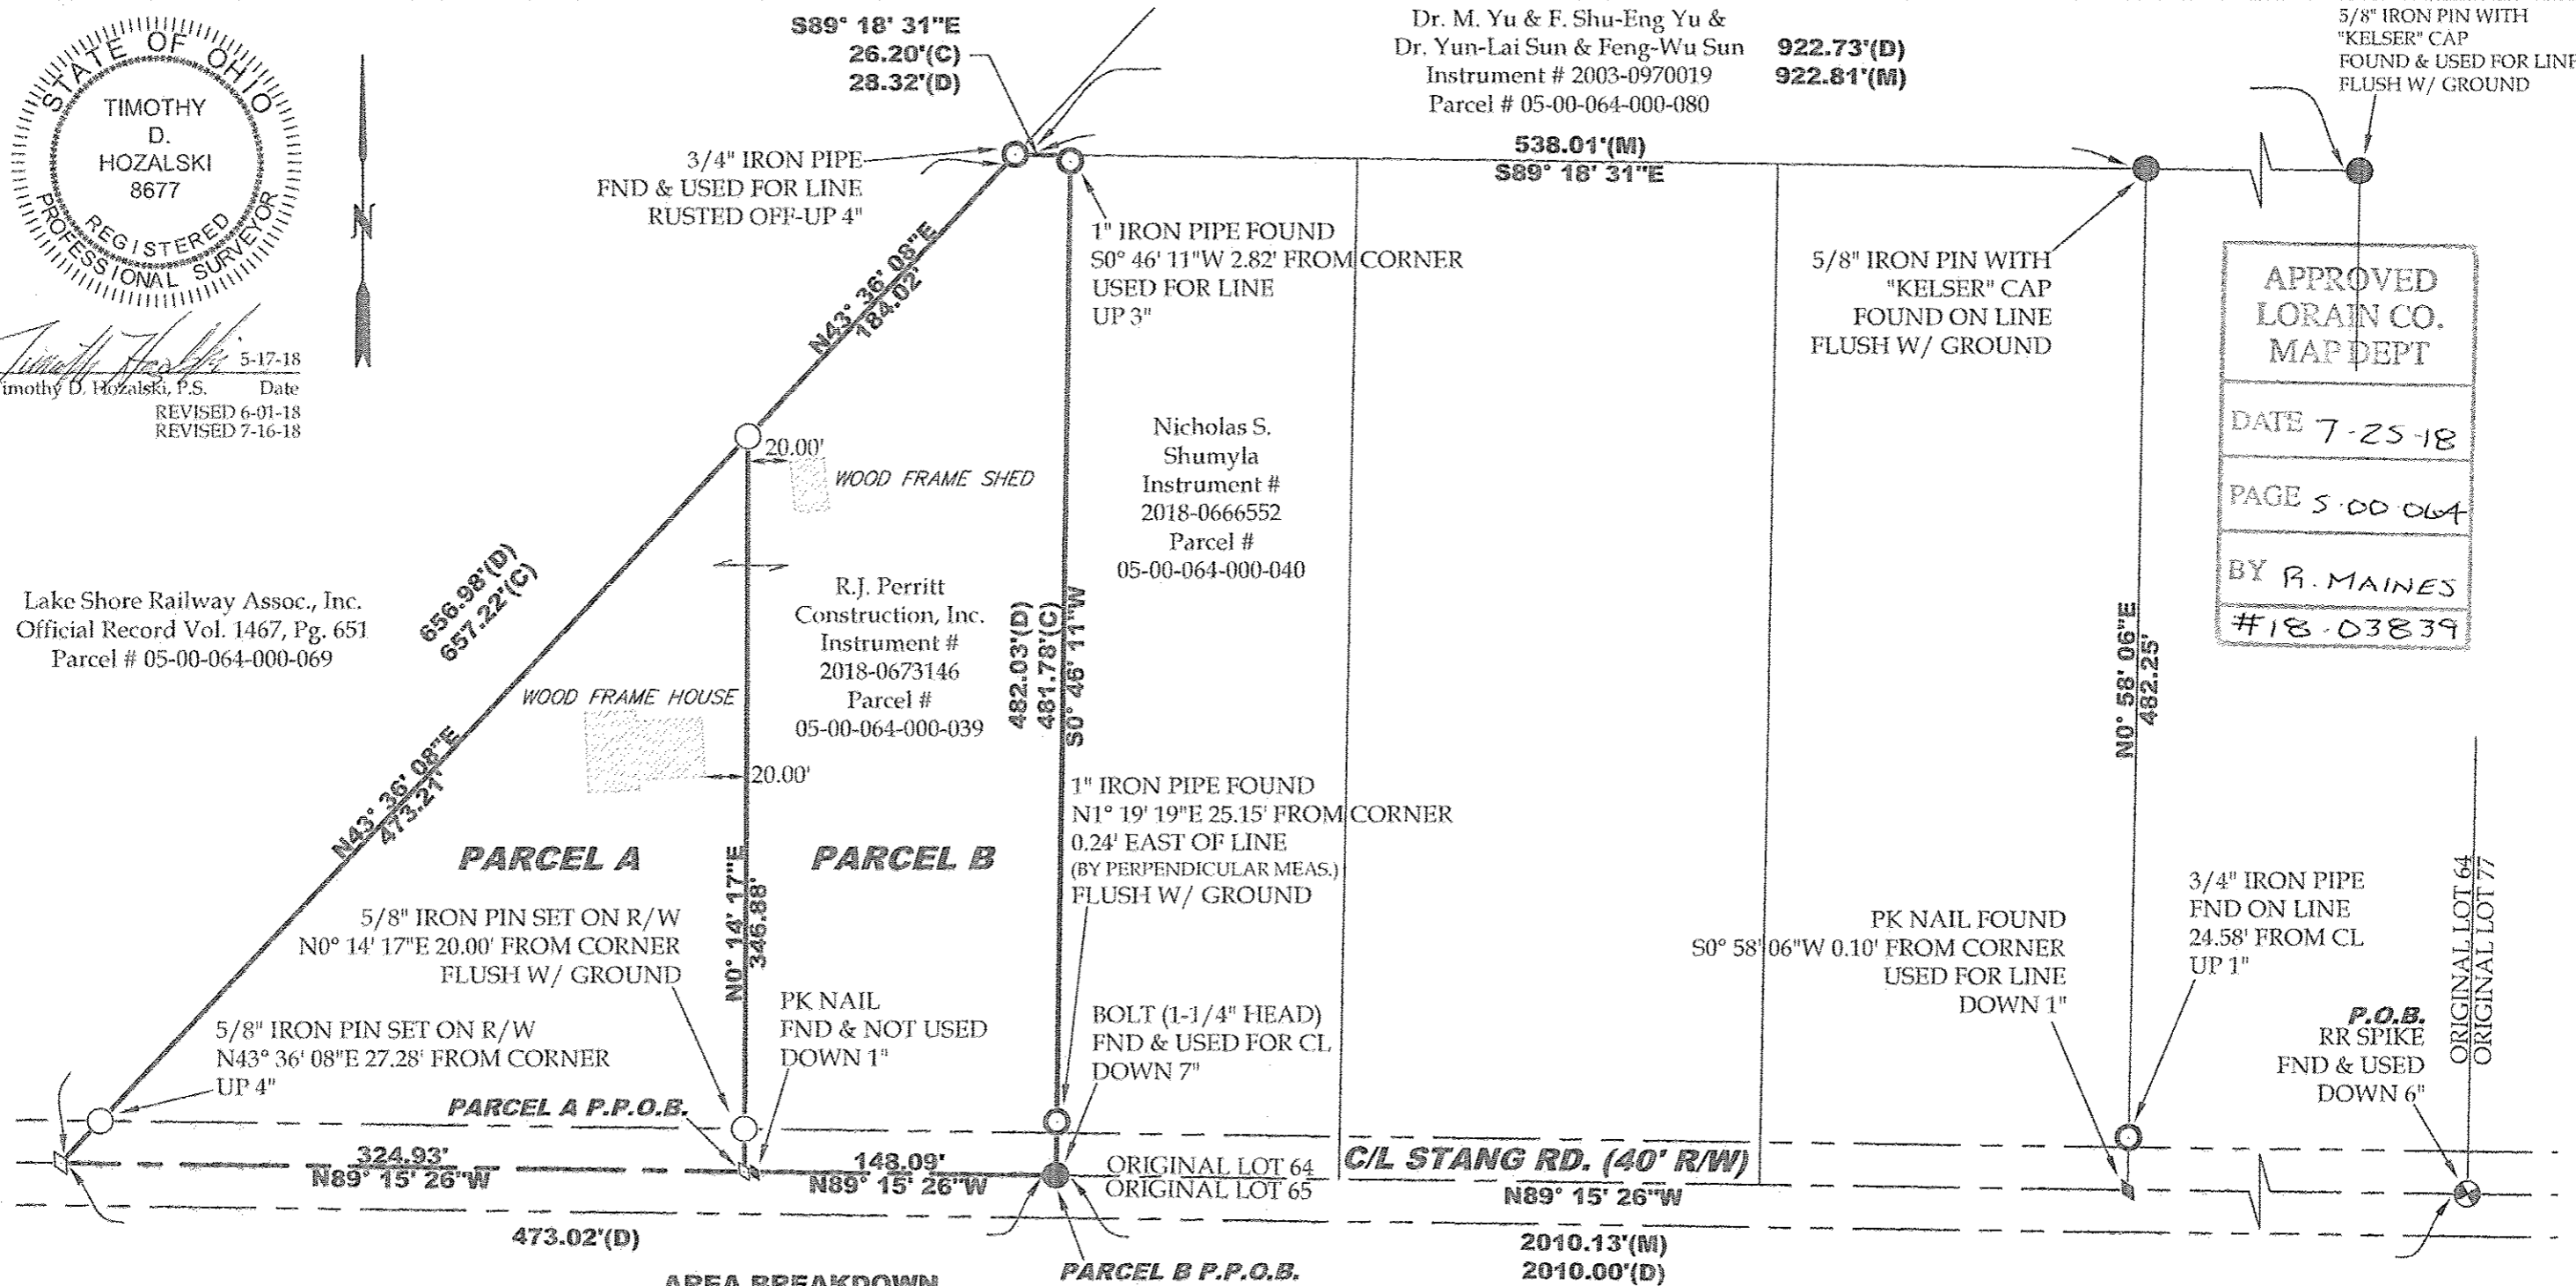

APPROVED
 LORAIN CO.
 MAP DEPT
 DATE 7-25-18
 PAGE 5.00.064
 BY R. MAINES
 #18-03839

File Name: E:\Documents\Surveying files\Jobs\2018\18-040-RJ Perritt-44710 Stang Road Lot Split-Amherst Twp\18-040-stang rd.dwg