



Note: Bearings shown are to an assumed Meridian and are used to describe angles only.

Being known as Part of Original Lots 44 and 45 of Amherst Township and Parcel Number 05-00-044-000-035 and 05-00-045-000-052 in the County of Lorain and the State of Ohio.

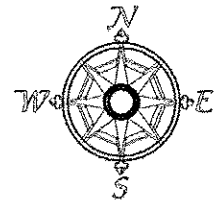

Scale 1" = 50'
January 23, 2016

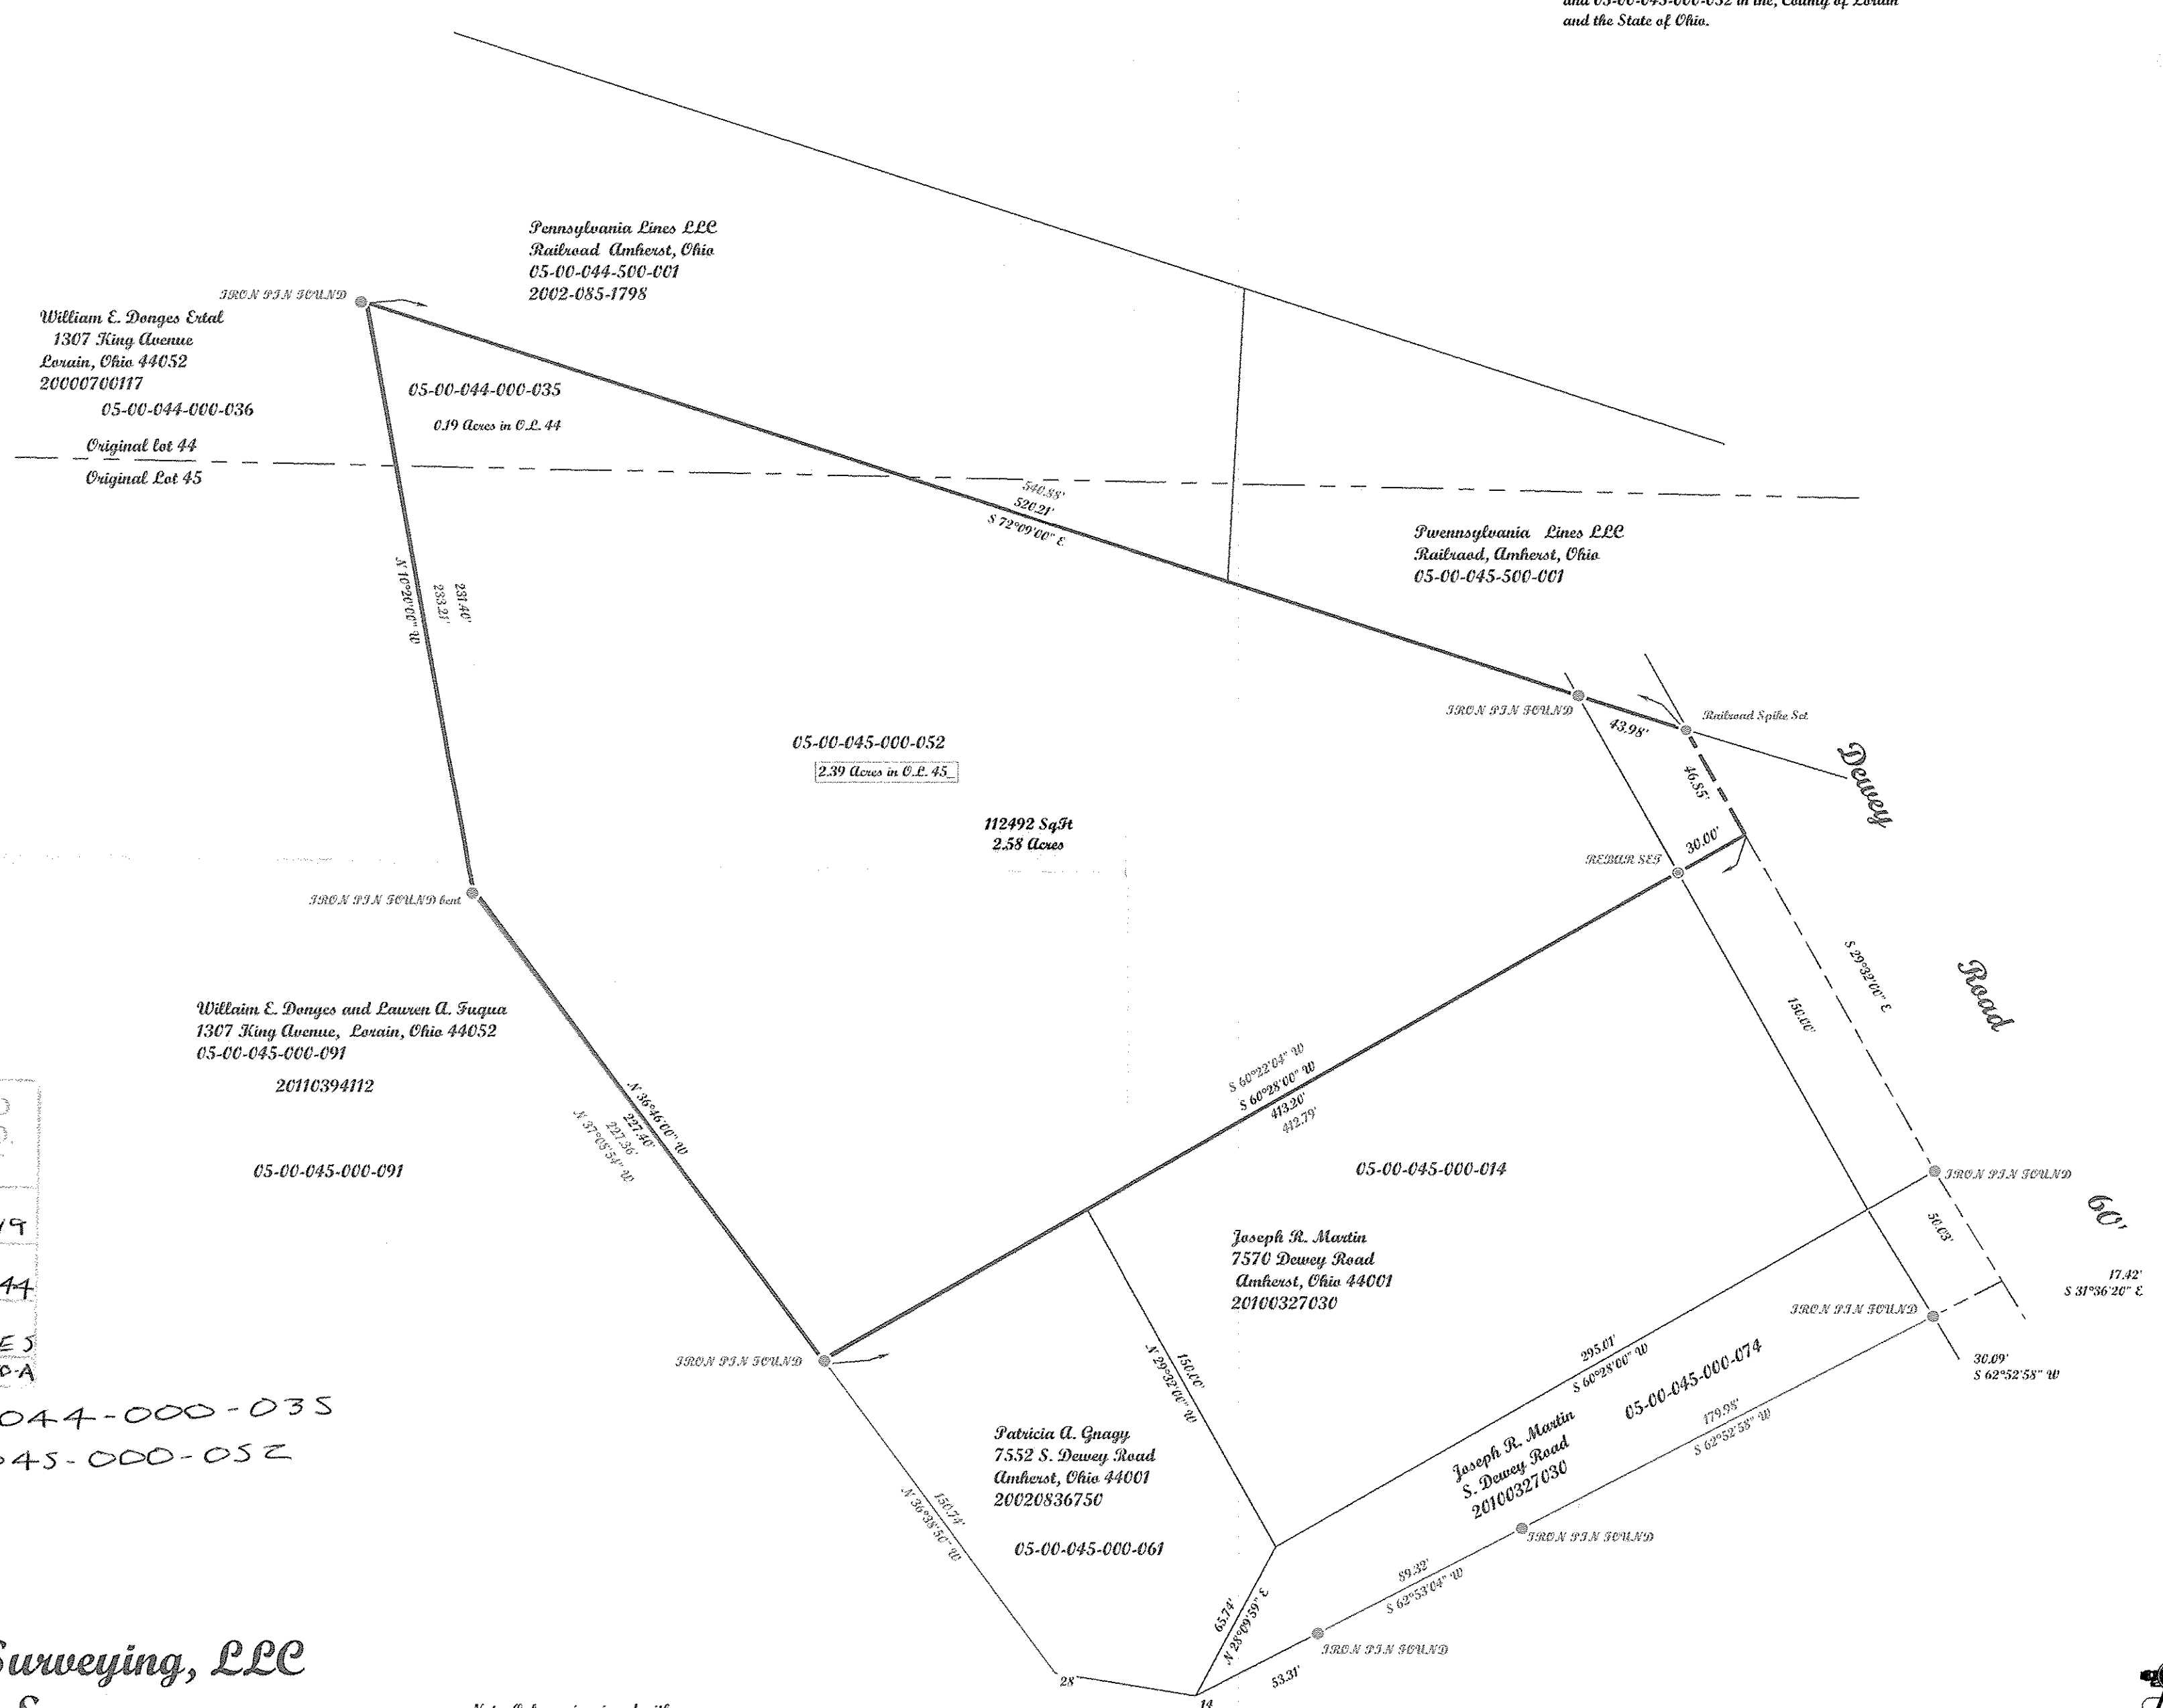

APPROVED
LORAIN CO.
RECORDS
DATE 4-30-19
PAGE 5-00-044
BY R. MAINES
#19-04080-A

05-00-044-000-035
05-00-045-000-052

McGannon Surveying, LLC
Boundary Survey
Patrick A. McGannon
Registered Professional Surveyor
1731 Gettysburg Drive, Lorain, Ohio 44053 (440) 282-2712
www.mcannonssurveying.com

Note: Only copies signed with Red ink shall be considered Valid.
Patrick A. McGannon
Patrick A. McGannon P.S. 7154

Prepared for the Estate of Patricia A. Gnagy AKA Patricia Ann Gnagy.



Note: Dimensions shown in Blue are record values and those shown in red are field observed values.