



Note: Bearings and Coordinates Shown are based on the Ohio State Plane (Grid North) but are used to describe angles only.

Being known as subplot being part of Original lot 17 and 24 of Amherst Township now in the City of Amherst, and known as Lorain County Tax Parcels 05-00-017-000-091 and 05-00-024-116-022, County of Lorain and the State of Ohio.

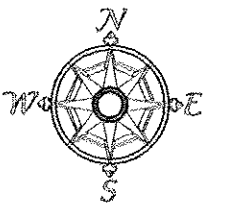

Scale 1" = 50'
March 19 2019

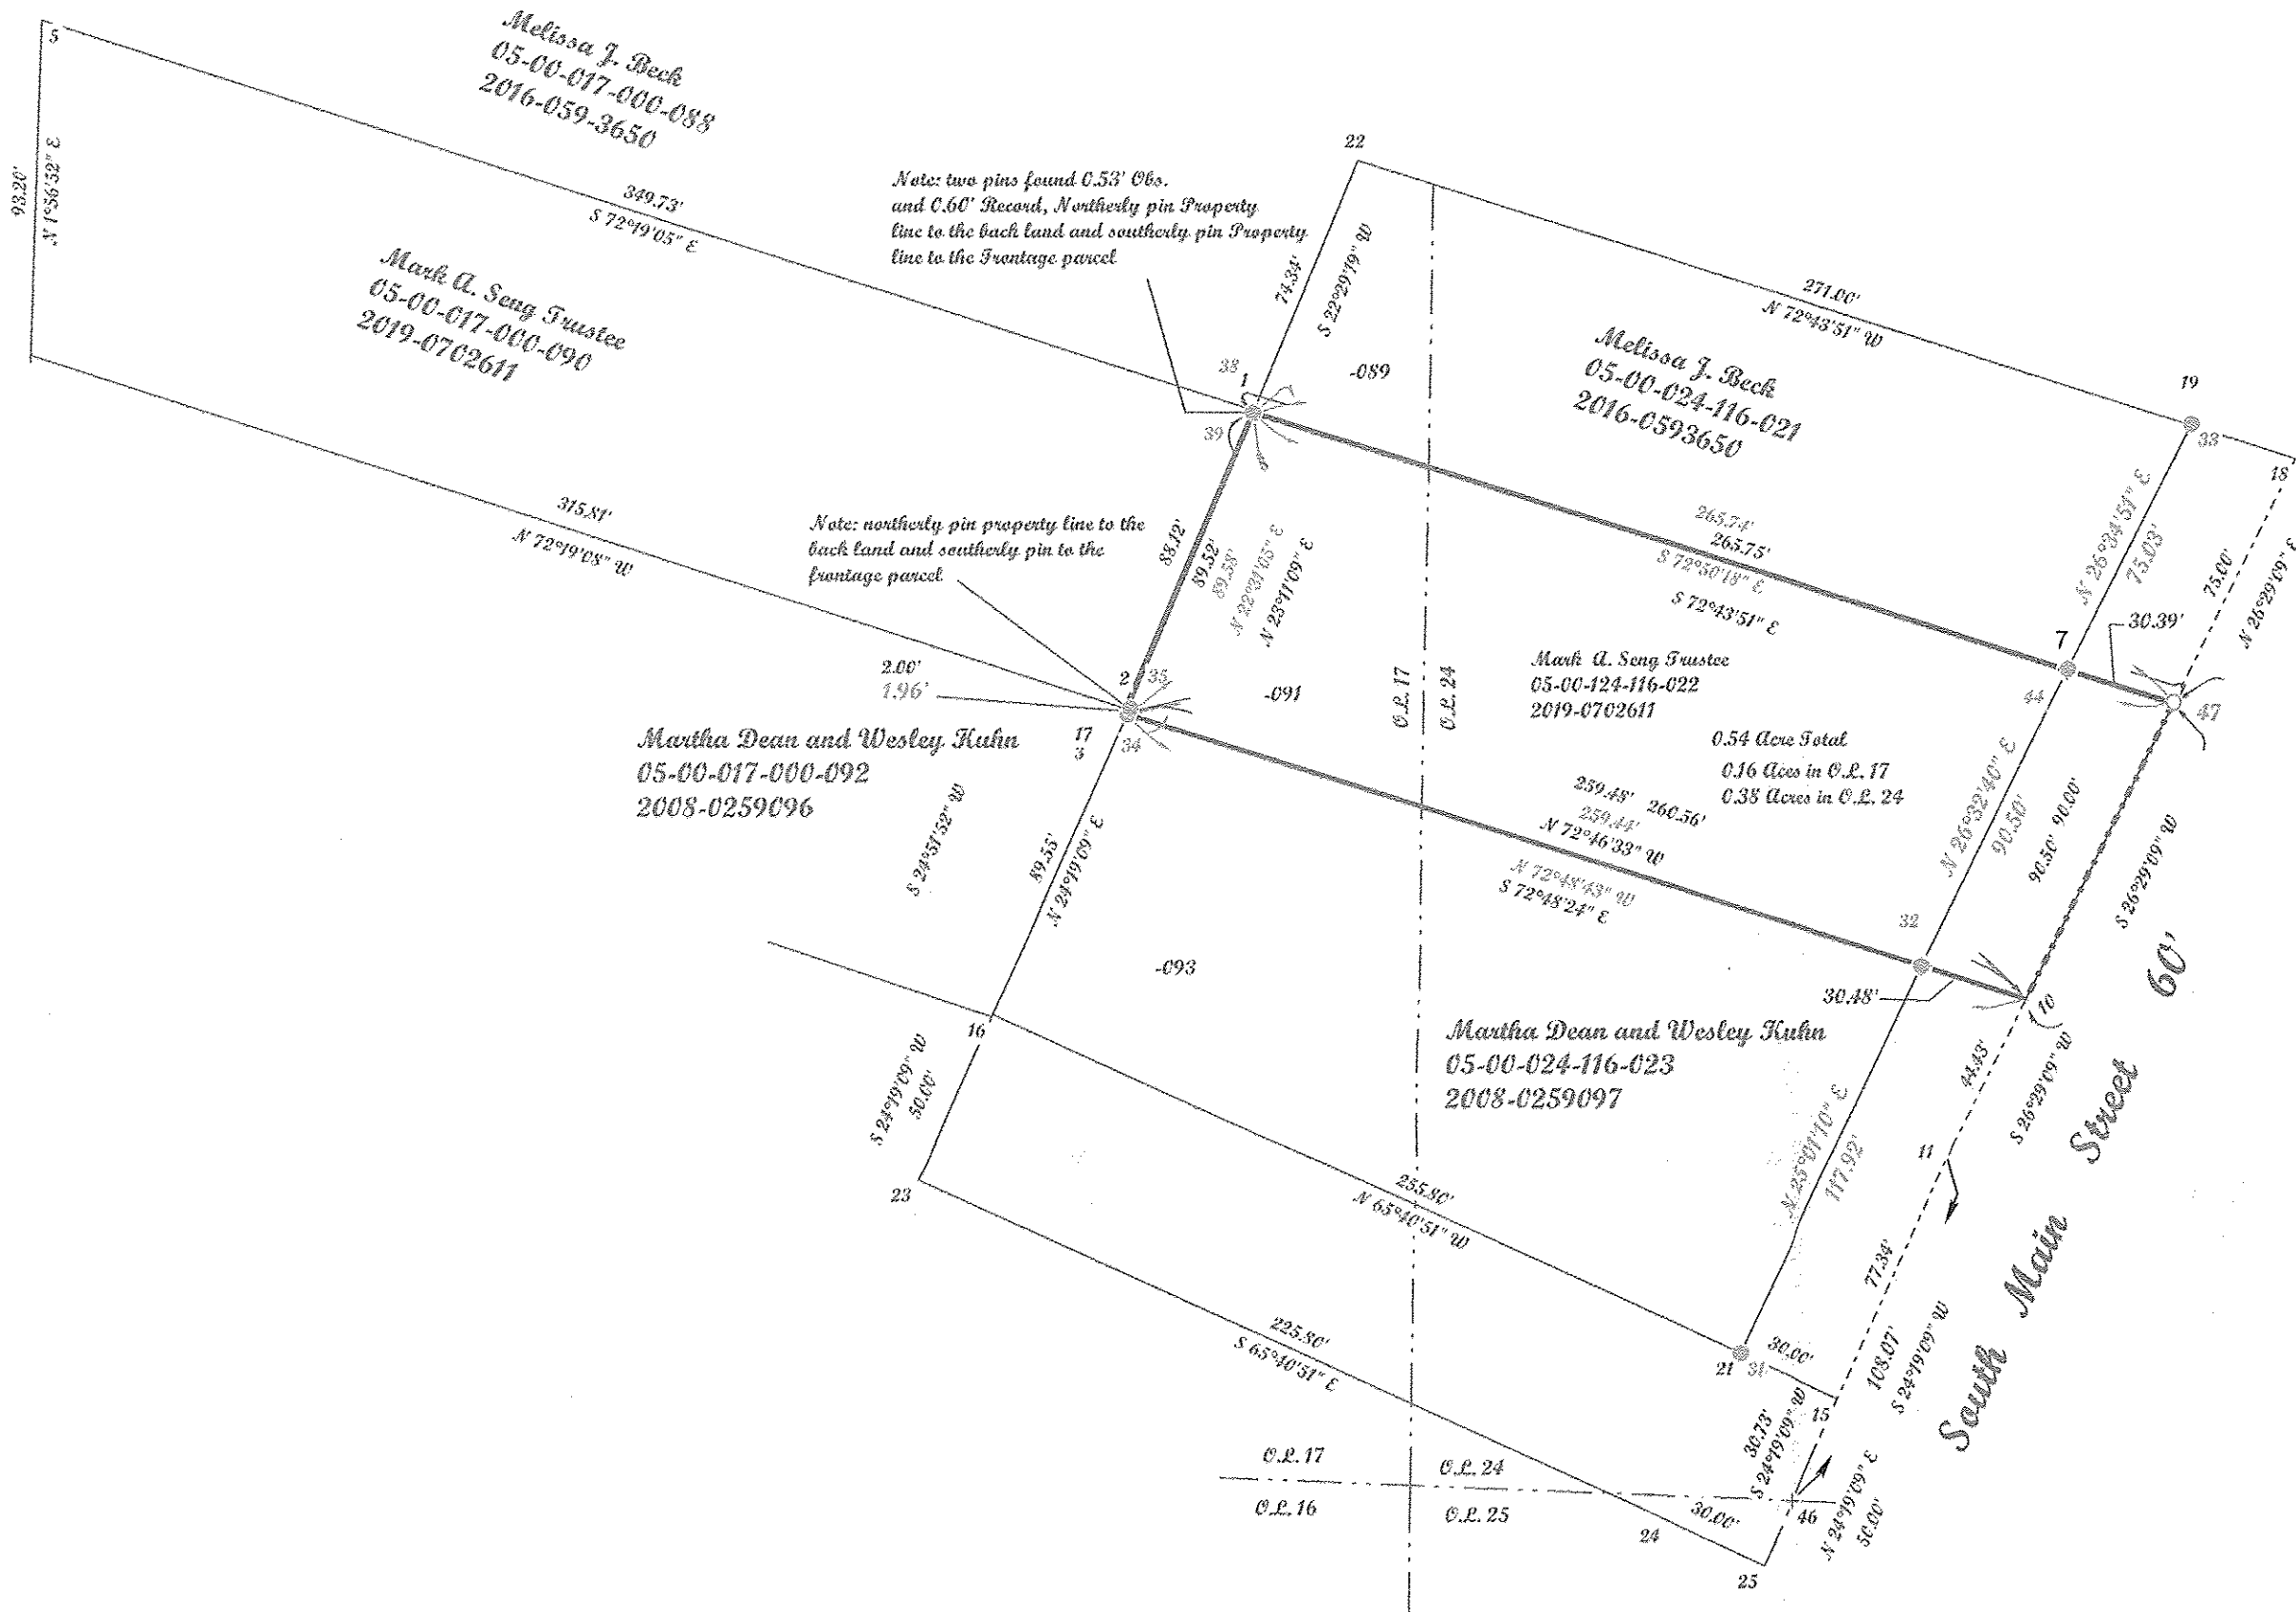

Point Table	
POINTS	DESE
1	
2	
3	
5	
7	
8	
10	
11	
15	
16	
17	
18	
19	
21	
22	
23	
24	
25	
31	IRON PIN FOUND
32	IRON PIN FOUND
33	IRON PIN FOUND
34	IRON PIN FOUND
35	IRON PIN FOUND
38	IRON PIN FOUND
39	IRON PIN FOUND
44	IRON PIN FOUND
46	
47	

APPROVED
LORAIN CO.
MAP DEPT
DATE 8-8-19
PAGE 5-00-024
BY R. MAINES
#19-04167-C

05-00-017-000-091
05-00-024-116-022



McGannon Surveying, LLC
Boundary Survey
Patrick A. McGannon
Registered Professional Surveyor
1731 Gettysburg Drive, Lorain, Ohio 44053 (440) 282-2712
www.mcgannonsurveying.com

Note: Only copies signed with Red ink shall be considered Valid.

Patrick A. McGannon P.S. 7154

Prepared for Mark Song Trustee of
852 Shadow Creek Trail
Amherst, Ohio 44001.



P.L.S.C.
Member Number 2433

Note: Dimensions shown in Blue are record values and those shown in red are field observed values.

Song - Shaved.tw S.N. 1654