

18-00-012-000-014
Israel Rodriguez &
Nancy Kasicki
Doc. 2014-0506779
23.64 ac.

5/8" Re-bar
Fd. & Used
18-00-012-000-015
Toby J. & Laure M. Keller
Doc. 2001-0790358
8.74 ac.

18-00-012-000-023
William R. & Valerie Matter
Doc. 2014-0516613
5.29 ac.

18-00-012-000-018
William R. & Valerie A. Mat
Doc. 2000-0688701
5.67 ac.

18-00-012-000-007
Jason J. & Jennifer N. Cobb
Doc. 2018-0673195
5.00 ac.

Parcel 1
7.7485 Ac.
0.14 Ac. R/W

Parcel 2
7.7439 Ac.
0.14 Ac. R/W

Remainder
18-00-012-000-005
24.83 acres
By Auditor

Deering & Lake Erie Railway

Jones Rd. 60'

R.R Spike
Fd. & Used

3/8" re-bar
Fd. & Used

Smith Rd. 50'

Smith Rd.

Plat of Survey

**for
Gordon Farms Land Company, LLC**


Wellington Twp. O.L. 12
Township 3 North, Range 18 West Ohio
Lorain County

Carlson Surveys April 2019


LEGEND

- ✕ = Iron Pin Set 1" pipe w/cap stamped Carlson
- = Iron Pin Found as noted
- ▲ = Railroad Spike Found
- N.T.S. = Not To Scale

APPROVED
LORAIN CO.
MAP DEPT
DATE 10-2-19
PAGE 18-00-012
BY R. MAINES
#19-04026

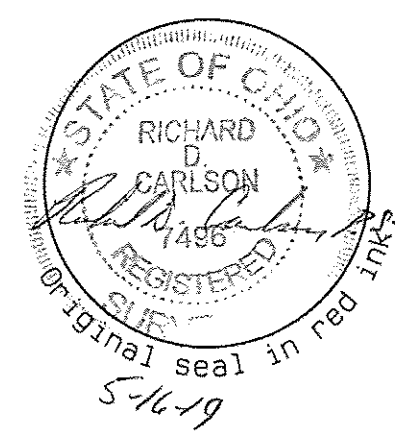

Job: 1802-24R
GRAPHIC SCALE 1"=100'

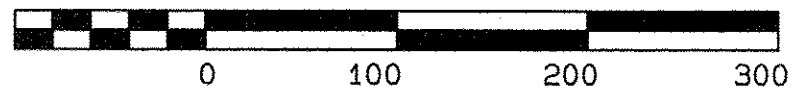

18-00-012-000-024 thru -027