


Grafton-Eastern Rd. 60'

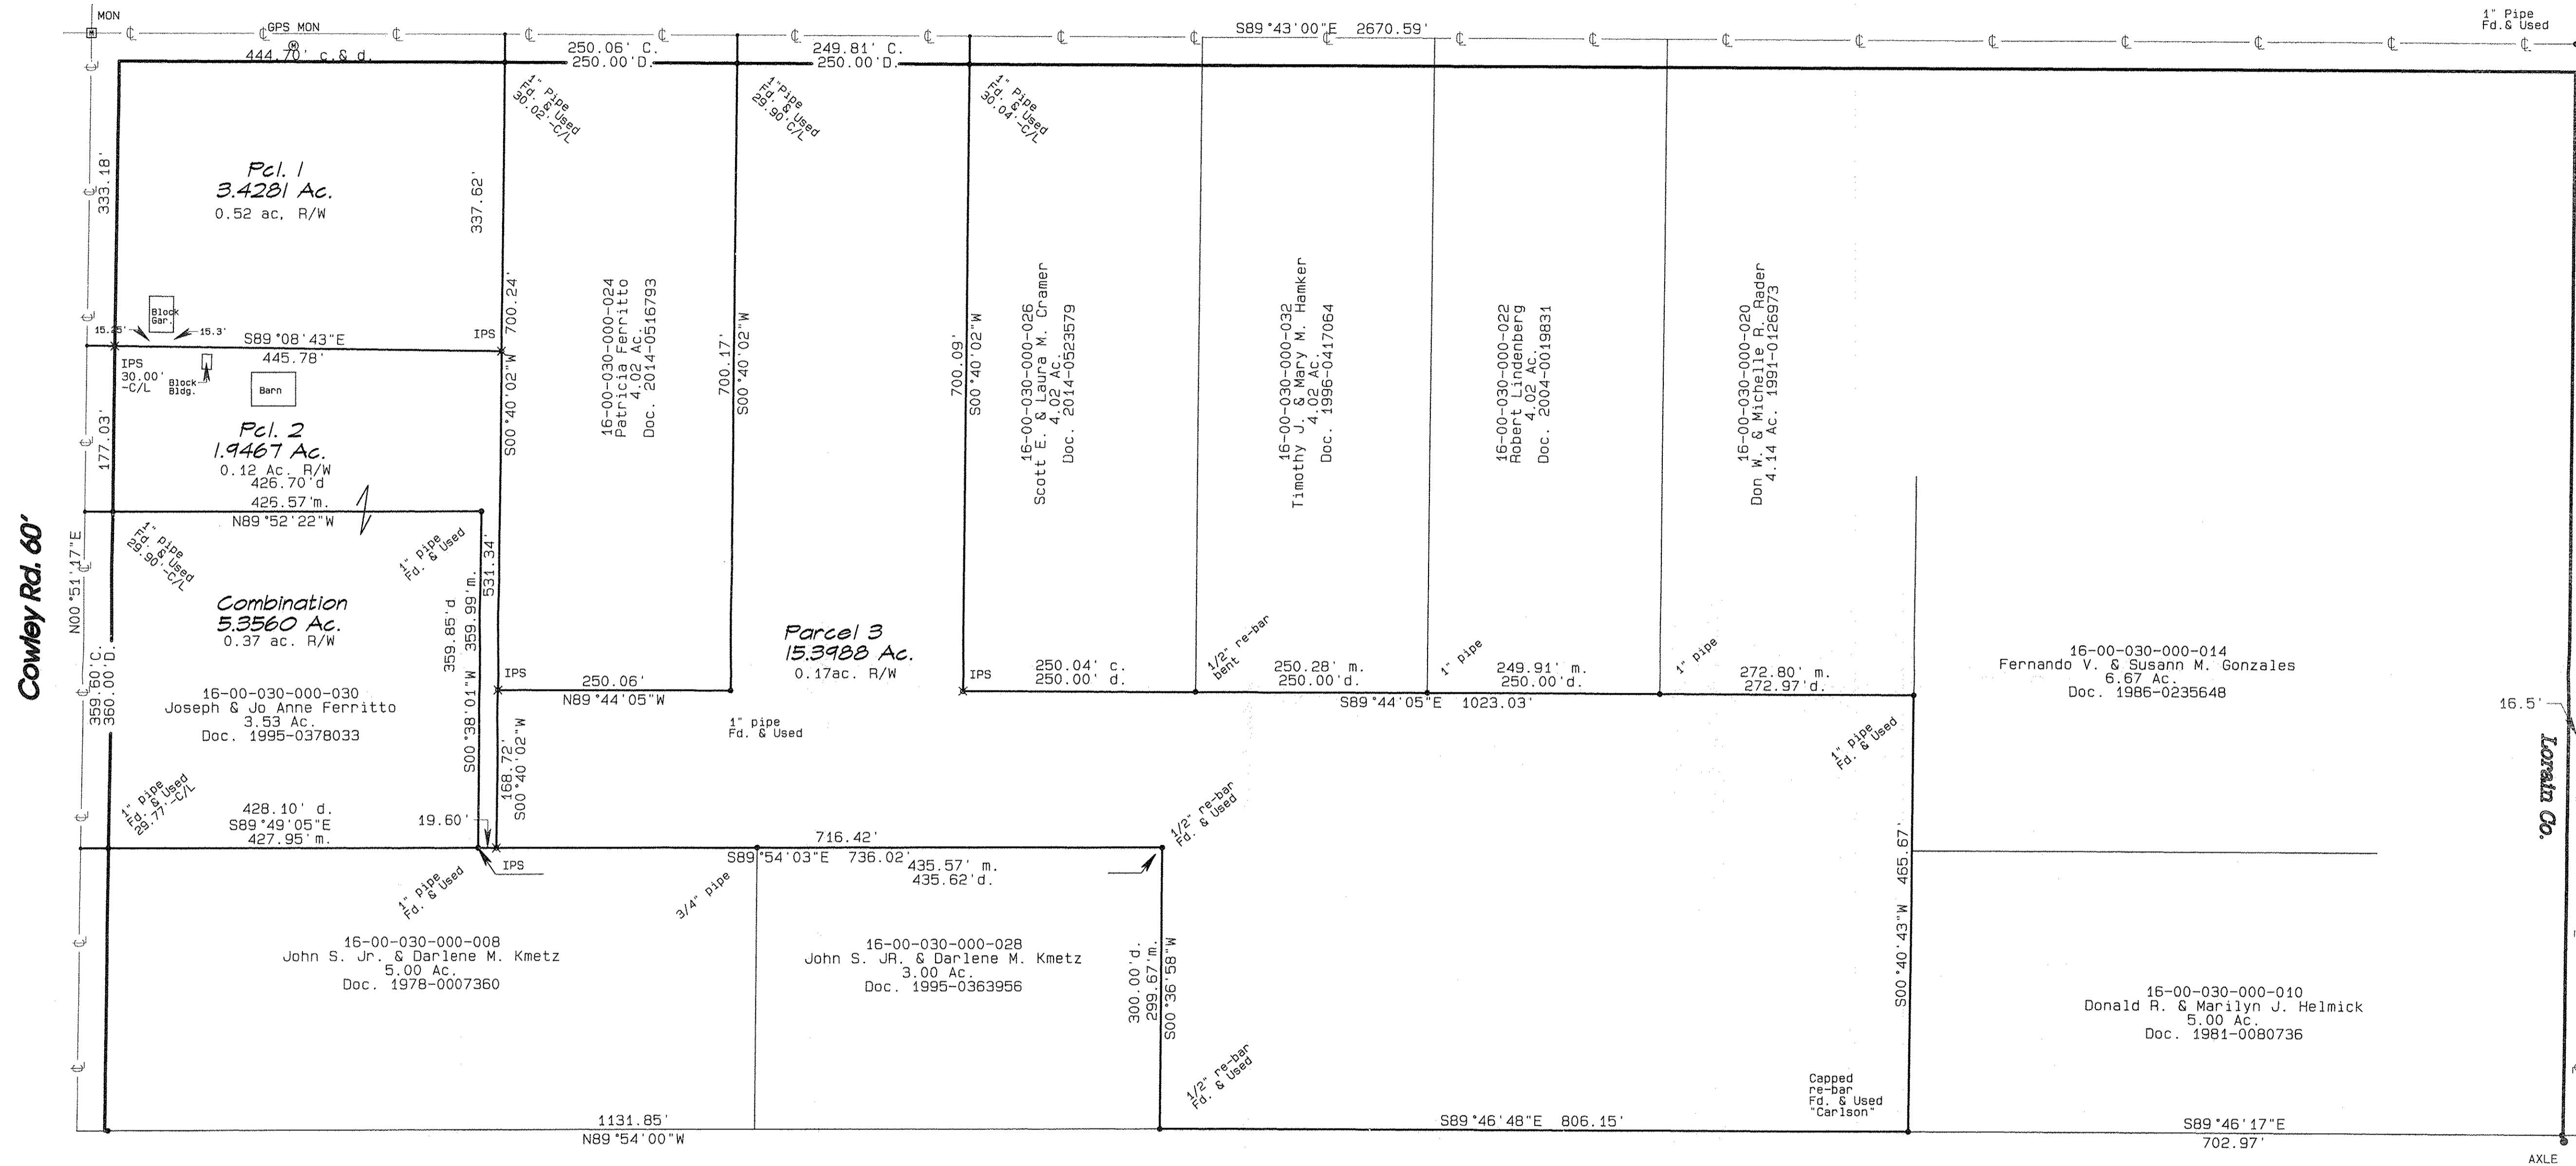


Ehrhart Rd. 46.5'
Medina Co.

Lorain Co.

AXLE

11-2-19
16-00-030
R. MAINES
#19-04046
16-00-030-000-042
thru
-045

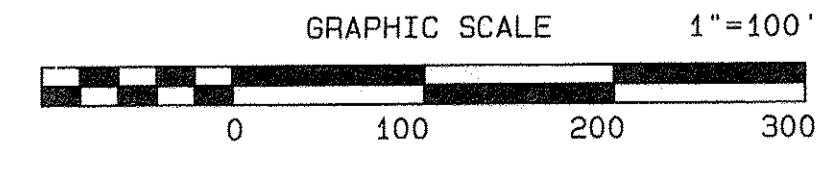

Job: 1602-34R

Plat of Survey
for
Ann Ferritto

Grafton Township O.L. 30
Township 4 North Ohio
Range 16 West
Lorain Co. August 2019
Carlson Surveys

16-00-030-000-040
Joyce A. Eilenberger
20.66 Ac.
Doc. 2018-0680416

