


RECORD OF SURVEYS. REGISTERED LANDS.

Registered Number 2063 Registrant William H. Upham and Mary Upham,  
Subsequent Owners Titus Street et al.

Survey for Maurer, Bolton, & McGiffin, Attorneys  
Original Lot 78 Russia Twp. Lorain Co. Ohio.  
Scale 1"=100' Dec. 7 1927. Warden & Laundon C.E.  
Courses shown are referred to true meridian.  
←E.A. Sherrill→

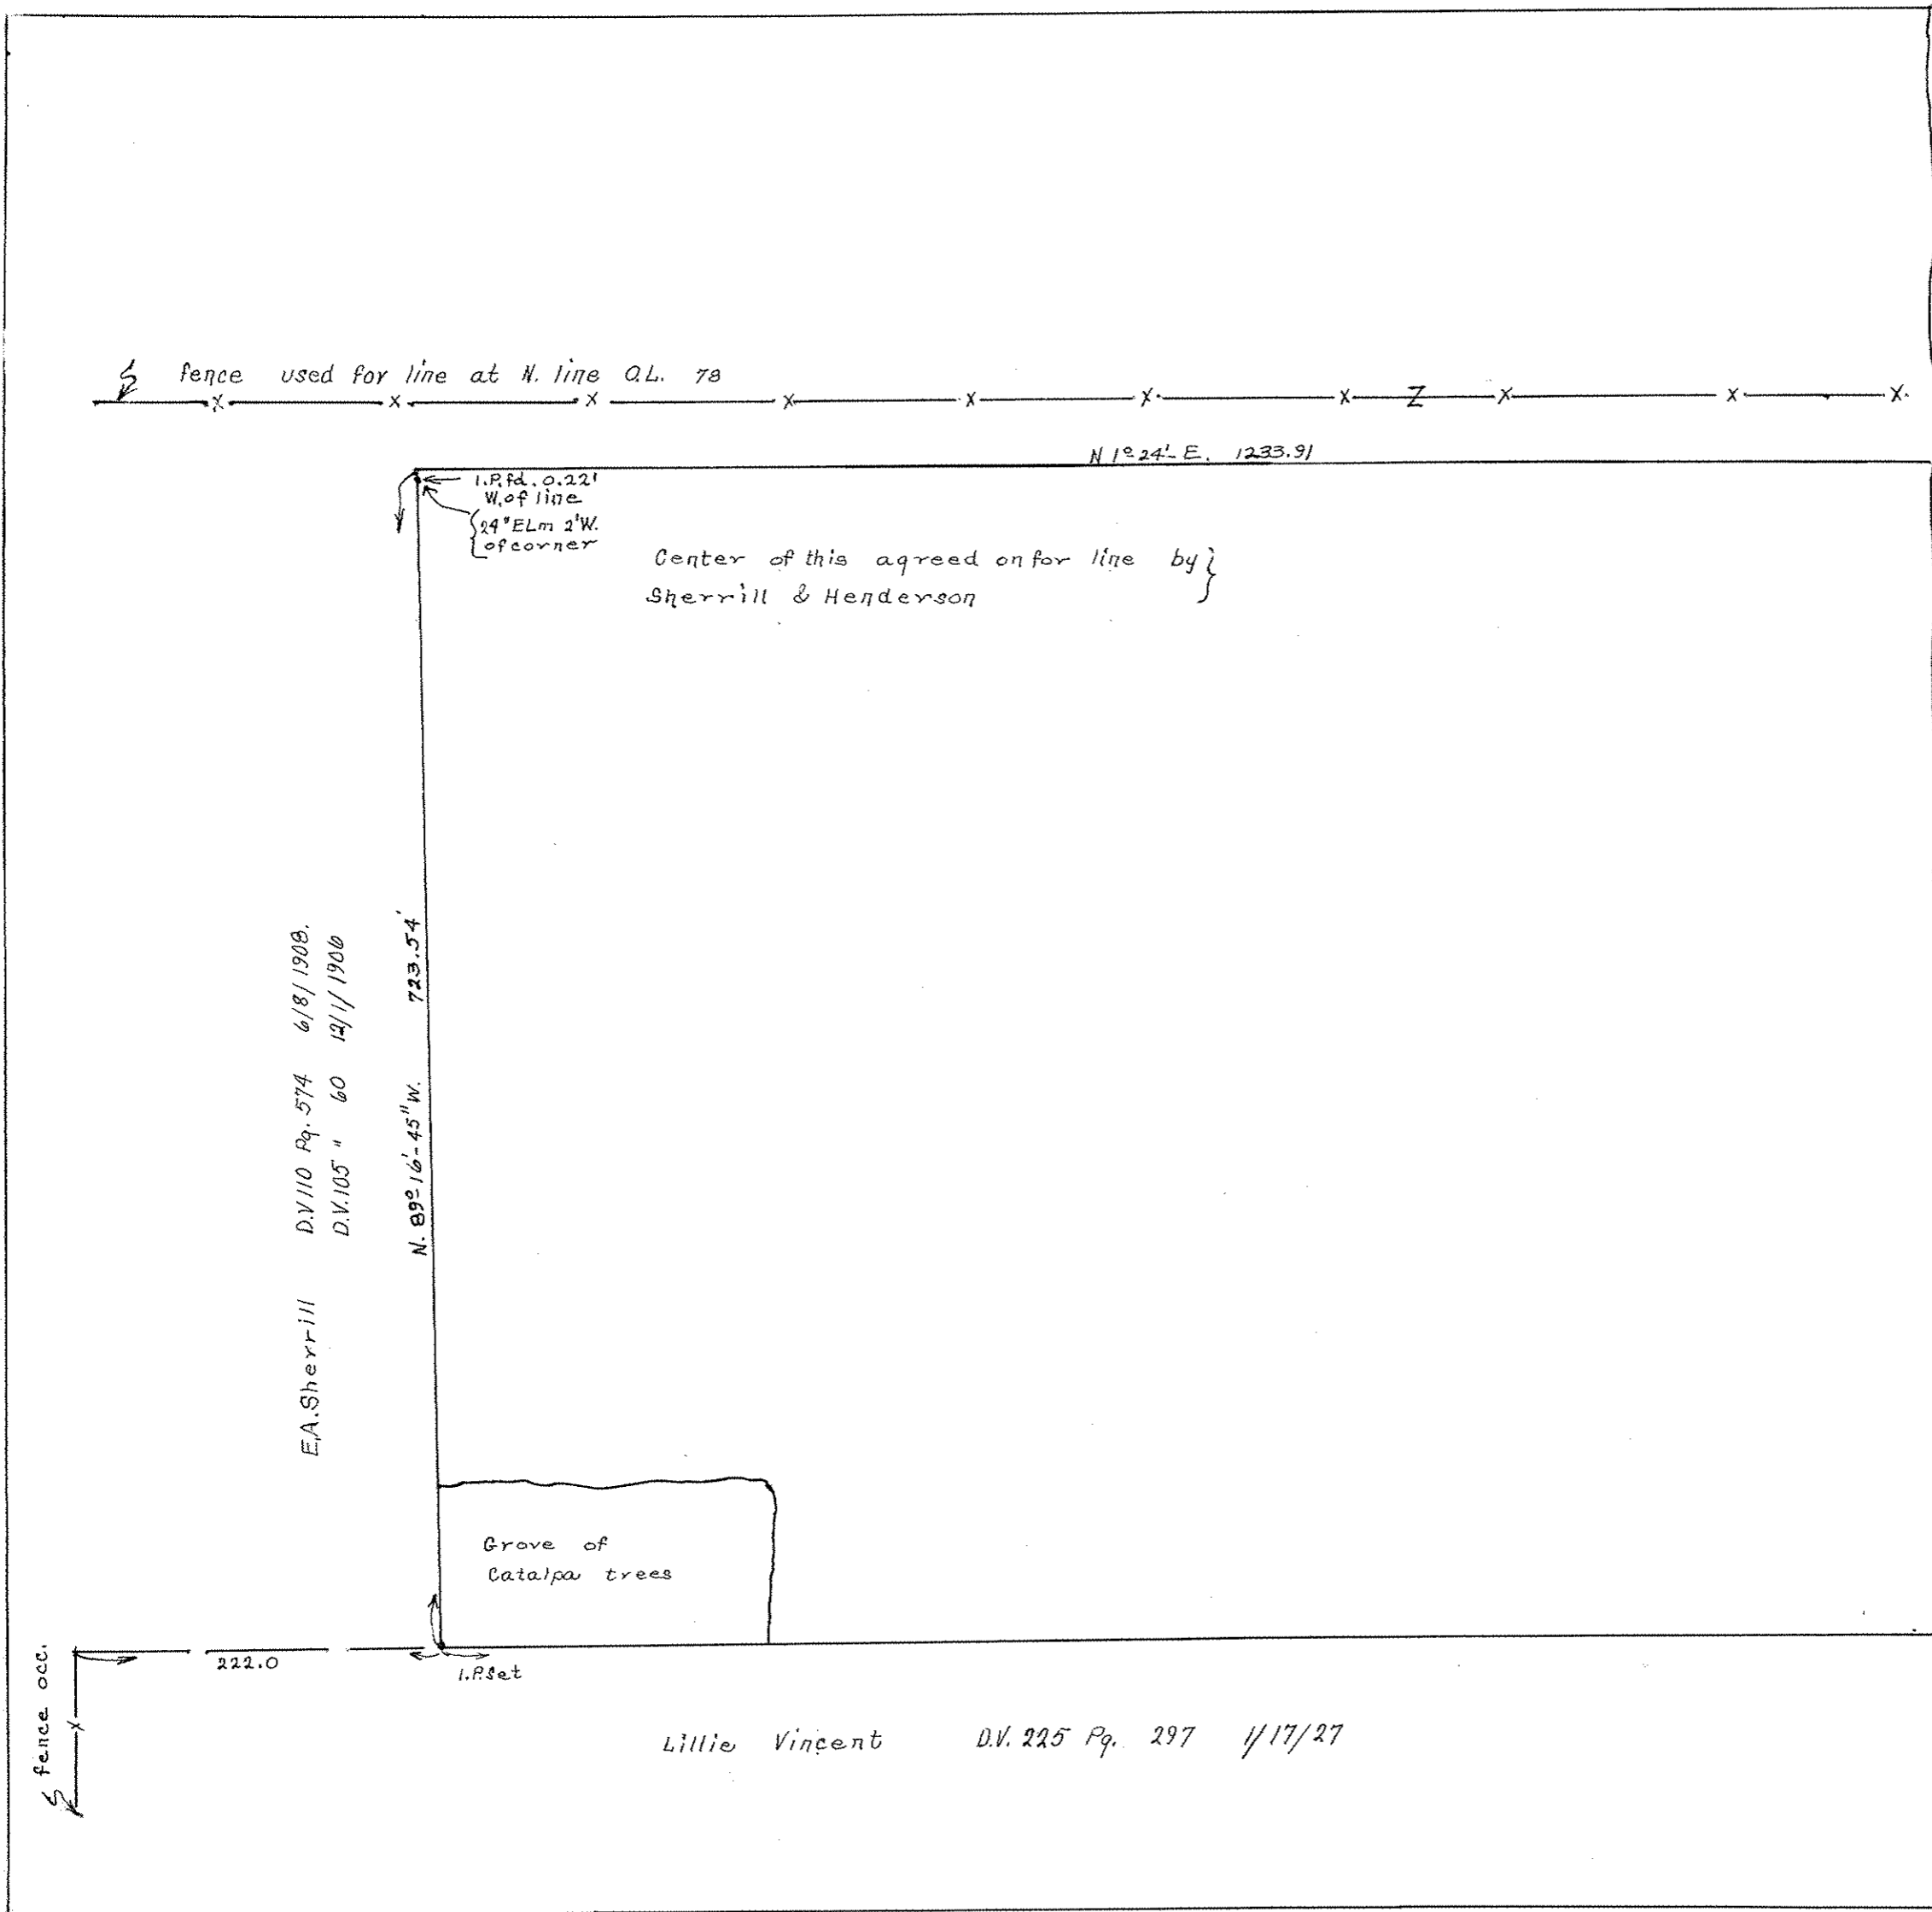

For continuation of plat see page 15.