


RECORD OF SURVEYS. REGISTERED LANDS.

Registered Number
Subsequent Owners

Registrant

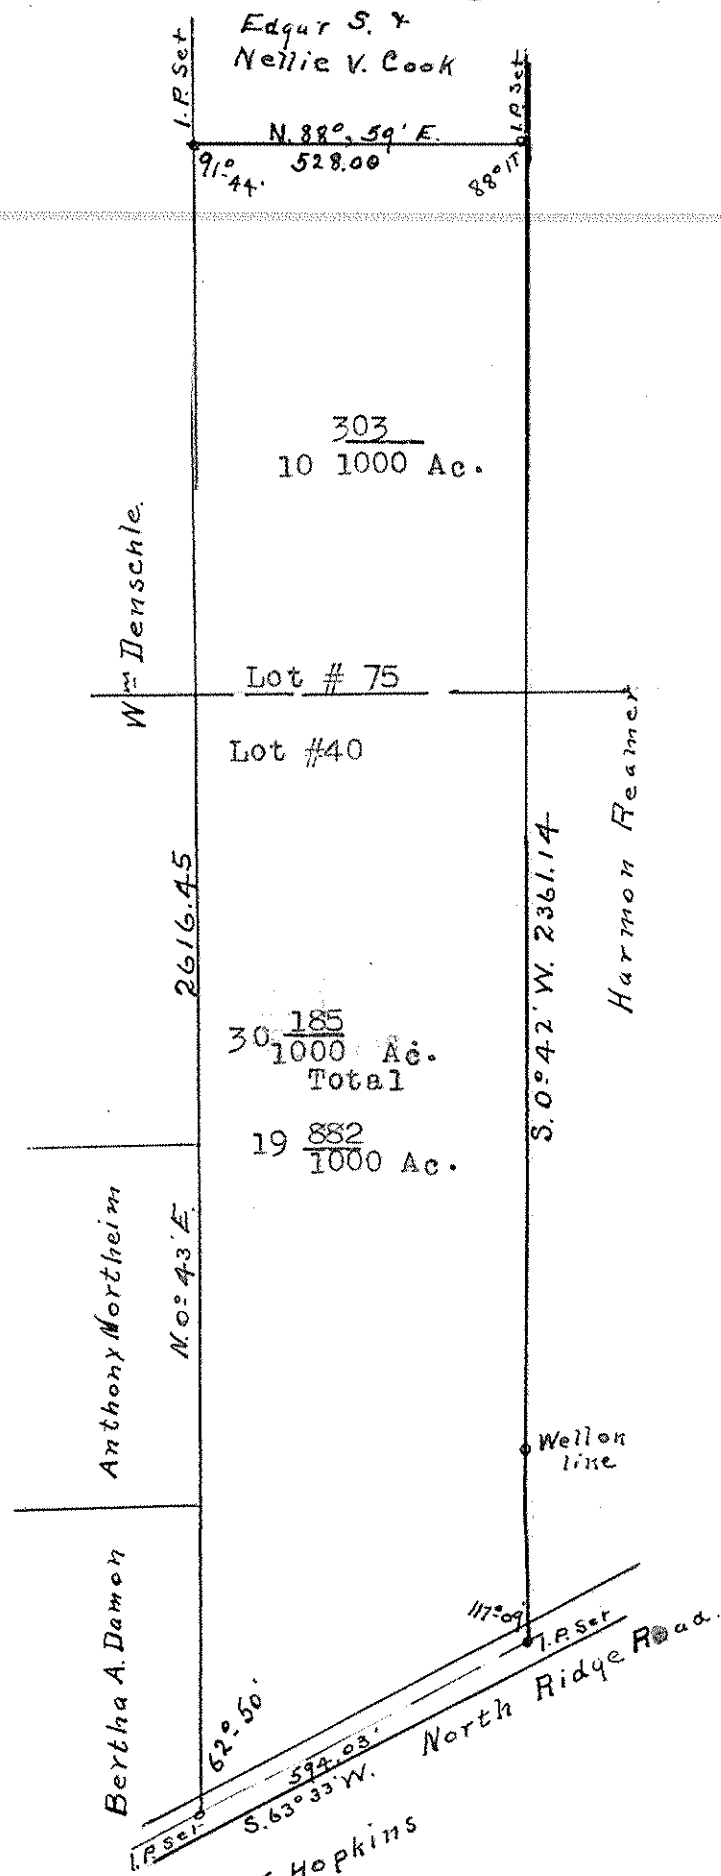

Survey of Henry Linderman Farm
O.L.#25-40 Brownhelm Tp.,
Lorain Co. Ohio
Jan. 8, 1915 T.L. Gibson C.E
Scale 1" - 300'
Made at the request of Hamlin Humphrey Admr

Detail of Buildings
Scale 1" - 30 feet

- 1- Hay & wagon barn - frame
- 2- Horse " "
- 3- Granary " "
- 4- " "
- 5- Out house " "
- 6- Pig pen & chicken coop " "
- 7- " " "
- 8- Smoke house " "
- 9- One story dwelling " "
- 10- Two " "
- 11- Well

