


AREA BREAKDOWN

Parcel 1: 1.5977 acres

Parcel 2: 1.4058 acres
 1.2735 acres within O.L. 63
 0.1323 acres (5,762.6622 ft) within O.L. 62

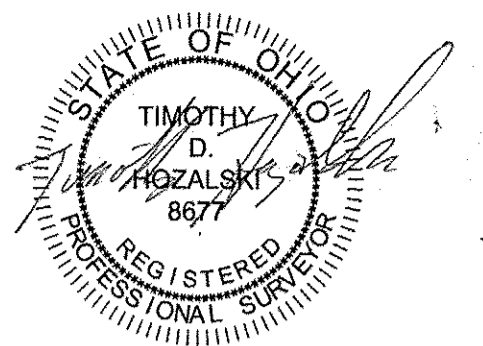

Curve Table

Curve #	Length	Radius	Delta	Chord Direction	Chord Length
C1	693.12	5779.65	6° 52' 16"	S54° 39' 29"E	692.70
C2	698.94	5679.65	7° 03' 03"	N53° 56' 44"W	698.50
C3	70.14	5779.65	0° 41' 43"	N58° 26' 29"W	70.14
C4	613.54	5679.65	6° 11' 22"	N61° 16' 43"W	613.24
C5	610.90	5779.65	6° 03' 22"	S61° 49' 02"E	610.62

- REFERENCES**
- Lorain County Survey Records
 - Survey by Michael Hura (Oct, 1981)
 - Survey by Michael Hura (Oct, 1988)
 - Survey by Michael Hura (Oct, 2001)
 - Lorain County Deed Records
 - Volume and Pages as indicated



- LEGEND**
- | SET | FOUND | DESCRIPTION |
|-----|-------|-------------------|
| ○ | ● | IRON PIN/ROD |
| ◇ | ◆ | SURVEY NAIL |
| ⊙ | ⊗ | MAG SPIKE |
| ⊗ | ⊗ | DRILL HOLE |
| ⊕ | ⊕ | RAILROAD SPIKE |
| ⊠ | ⊠ | MONUMENT BOX |
| ⊙ | ⊙ | CONCRETE MONUMENT |
| ○ | ○ | IRON PIPE |
| ▲ | ▲ | STONE |
| ■ | ■ | WOOD POST |

ABBREVIATIONS

(D) PER DEED (M) MEASURED (P) PER PLAT
 (C) CALCULATED (HS) PER HURA SURVEY

ALL IRON PINS SET ARE 5/8"x30" REBAR WITH YELLOW PLASTIC CAPS STAMPED "HOZALSKI P.S. 8677/ VECTOR SURVEYING"
 ALL DRILL HOLES ARE 1/2" IN DIAMETER

Retracement Survey for Roy Kudrin
 Being a parcel of land located in part of Original Lots 62 & 63, Sheffield Township, Twp 7 North, Range 17 West, Connecticut Western Reserve, Lorain County, Ohio

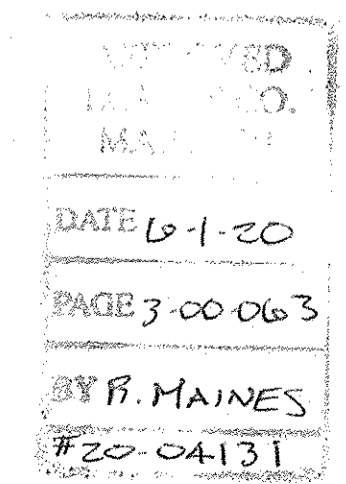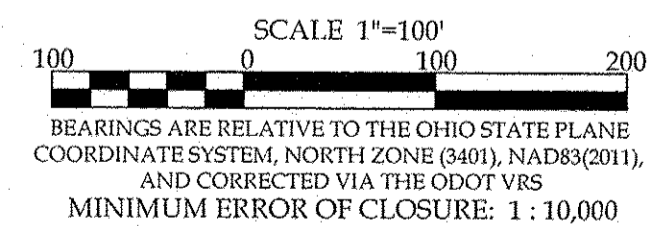

03-00-062-000-008
 03-00-063-000-076, -077



OFFICE: 440-865-8445 WAKEMAN, OH
 VECTORSURVEYING@YAHOO.COM

Job No. 15-011	Drawn By: CAD
Date: Aug, 2015	Checked By: TDH