


Being known as subplot Original Lot 45 of Amherst Township, and being known as Lorain County tax Parcel Number 05-00-045-000-016, County of Lorain and the State of Ohio.

Note: Bearings and Coordinates shown are based on the Ohio State Plane (Grid North) But are used to describe angles only.

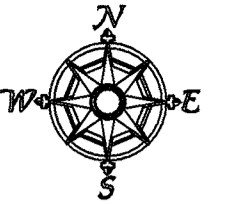


Scale 1" = 30'
February 27, 2021

Judith Ann Woods
05-00-045-000-015
2020-0768471

Judith A Woods
05-00-045-000-016
2020-0768471

Point Table			
POINTS	NORTHING	EASTING	DESC
1	628002.88	2050446.63	IRON PIN FOUND IN A MON BOX
2	628109.91	2050384.02	REBAR SET
13	627938.48	2050388.01	IRON PIN FOUND IN A MON/MEN'S BOX
15	628040.24	2050265.62	IRON PIN FOUND bent straightened
17	628030.04	2050430.74	REBAR SET

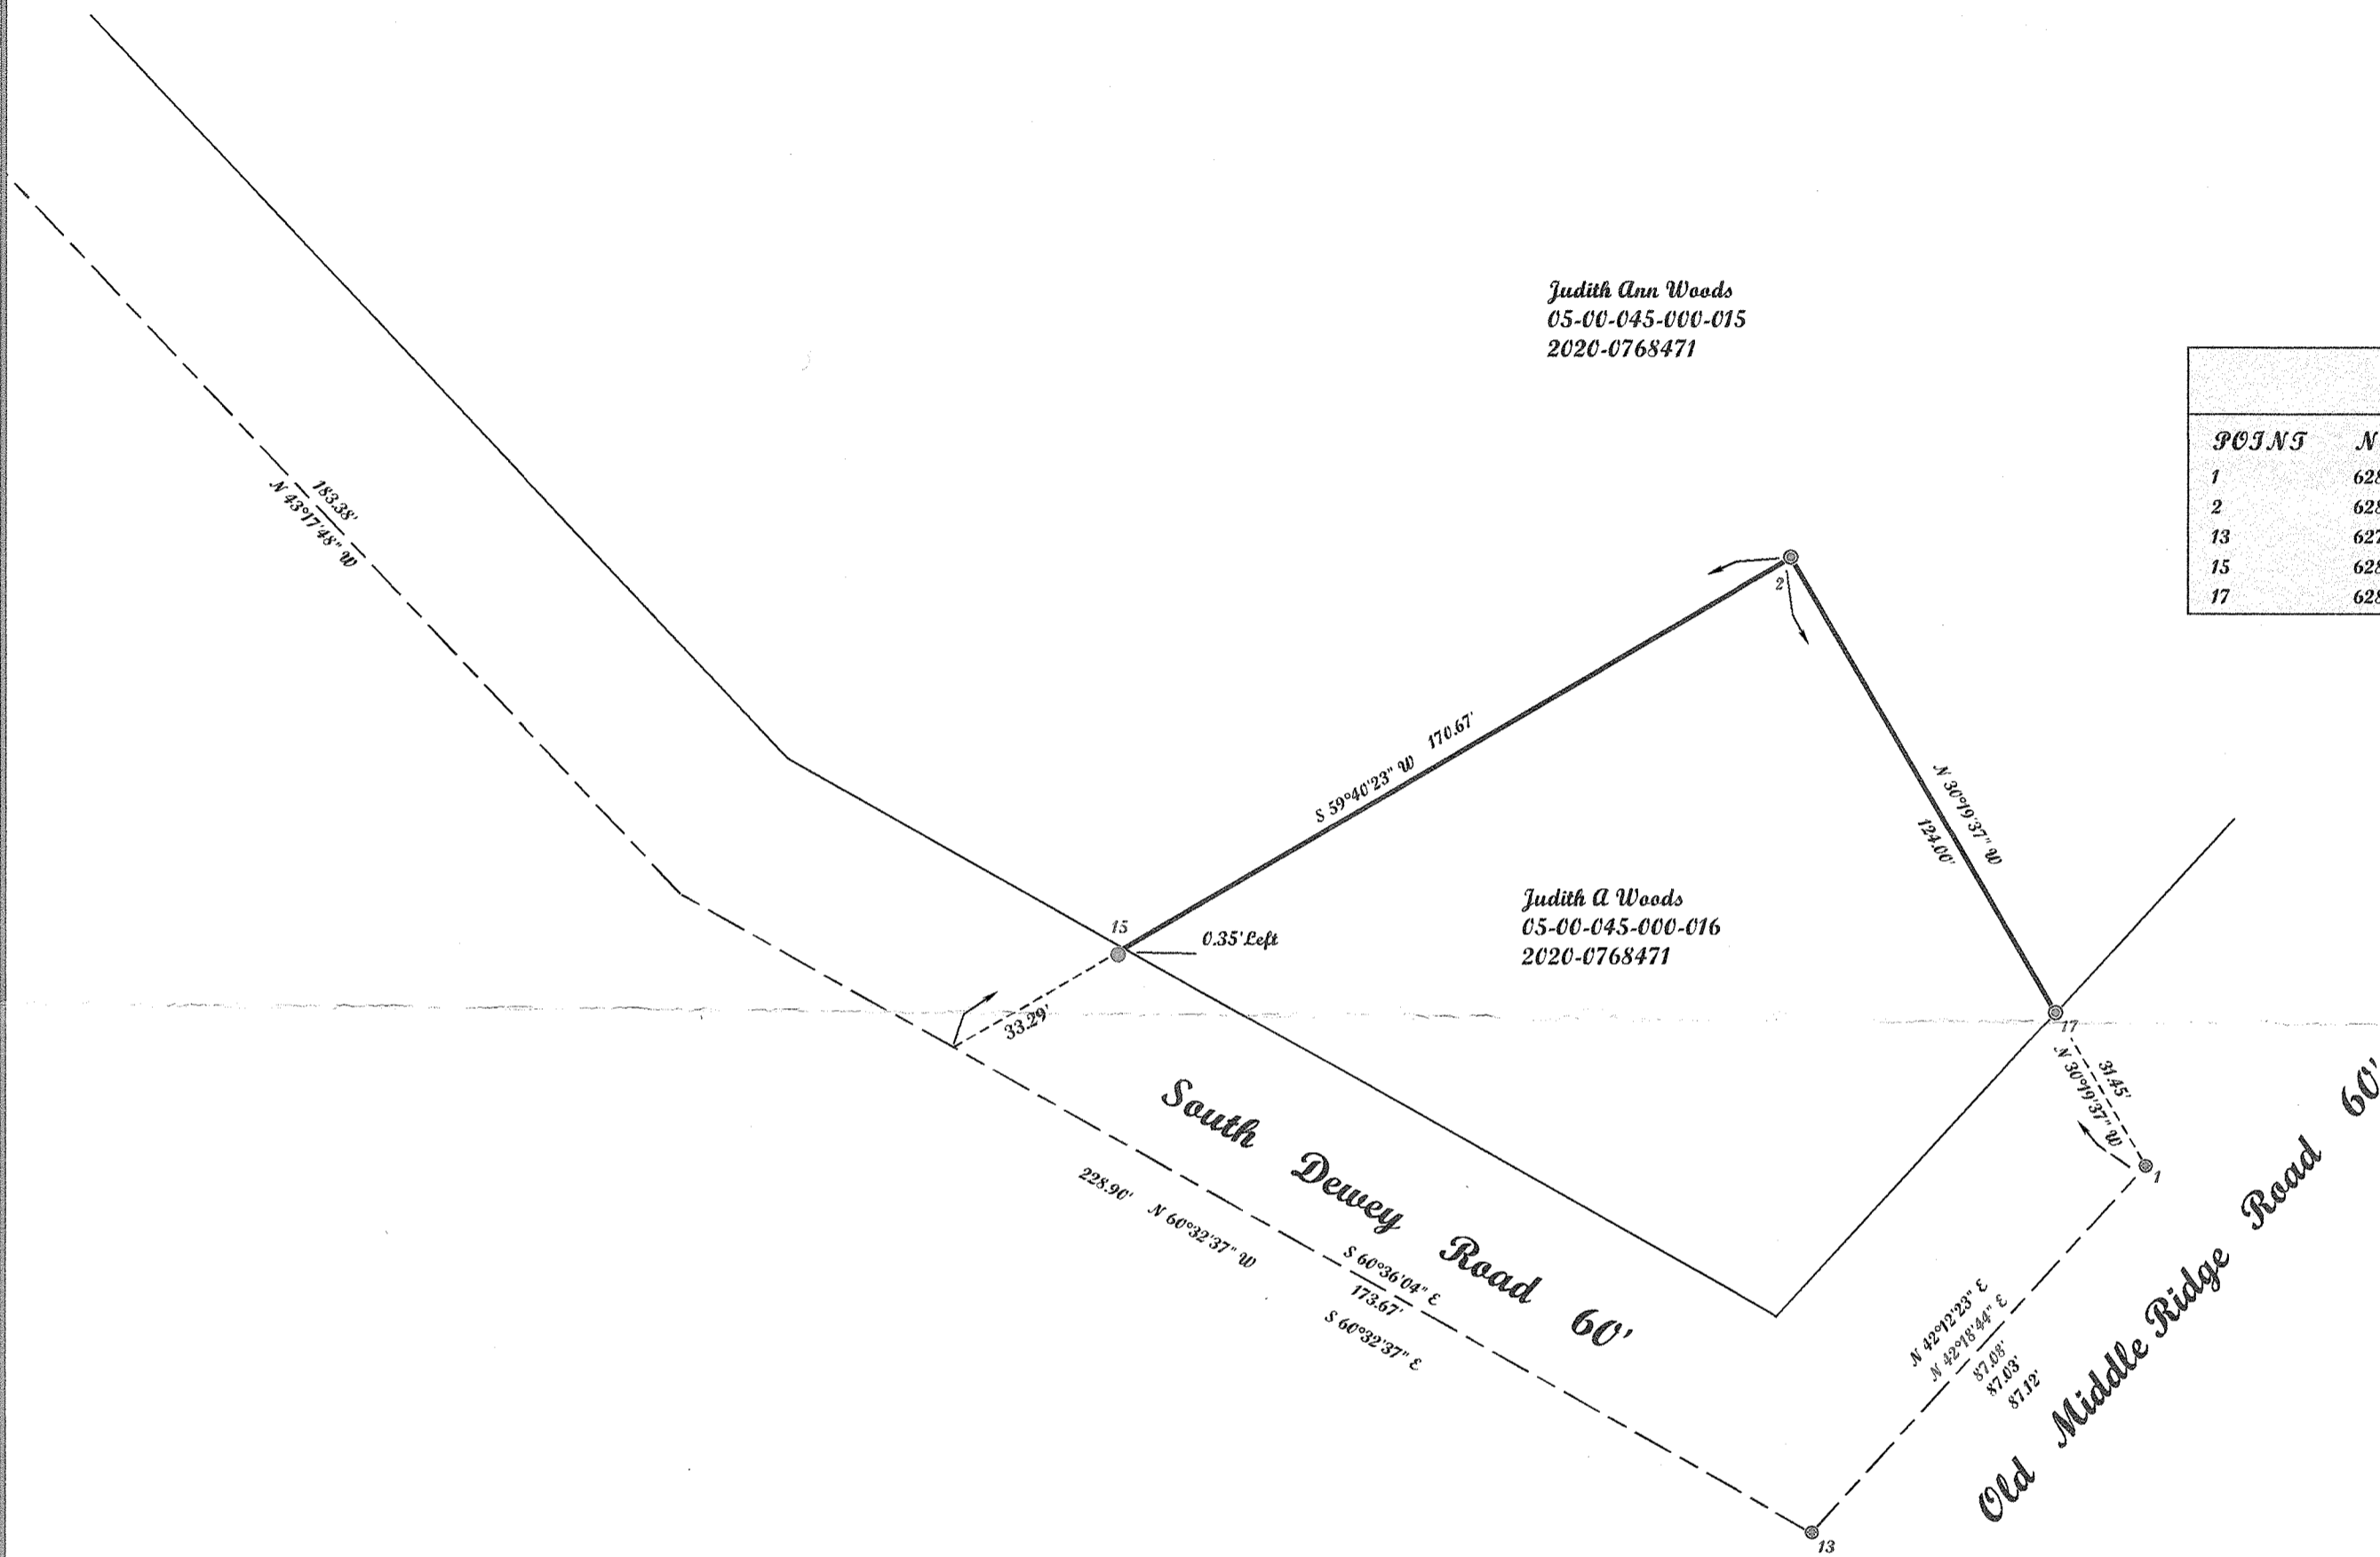

50311
 APPROVED
 LORAIN CO.
 MAP DEPT
 DATE 6/24/21
 PAGE 6/23/21
 BY ACorden
 #21-04590-C

McGannon Surveying, LLC
 Boundary Survey
 Patrick A. McGannon
 Registered Professional Surveyor
 1731 Gettysburg Drive, Lorain, Ohio 44053 (440) 282-2712
 www.mcgannonsurveying.com

Note: Only copies signed with Red ink shall be considered Valid.

 Patrick A. McGannon P.S. 7154

Prepared exclusively for Judith Woods of 8160 Pyle South Amherst Road Amherst, Ohio 44001 under the term of the work order as if incorporated herewith.

P.L.S.C.
 Member Number 2433



Note: Dimensions shown in Blue are record values and those shown in Red are field observed values.