


MAYFIELD STREET (50')

I. PIPE
FD. & USED


DIMENSIONS SHOWN ON THIS PLAT ARE EXPRESSED IN FEET AND DECIMAL PARTS THEREOF, ALL BEARINGS ARE TO AN ASSUMED MERIDIAN AND ARE USED TO INDICATE ANGLES ONLY. PERMANENT MONUMENTS HEREON, OR SET AT ALL POINTS INDICATED HEREON, ALL OF WHICH I CERTIFY TO BE CORRECT.

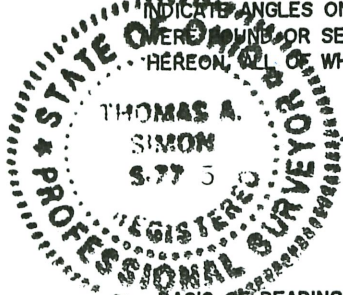

TS

THOMAS A. SIMON
REG. PROFESSIONAL SURVEYOR
NO. S-7775

BASES OF BEARINGS IS THE WESTERLY LINE OF RIDGEWOOD STREET (NORTH 00°19'24" EAST).

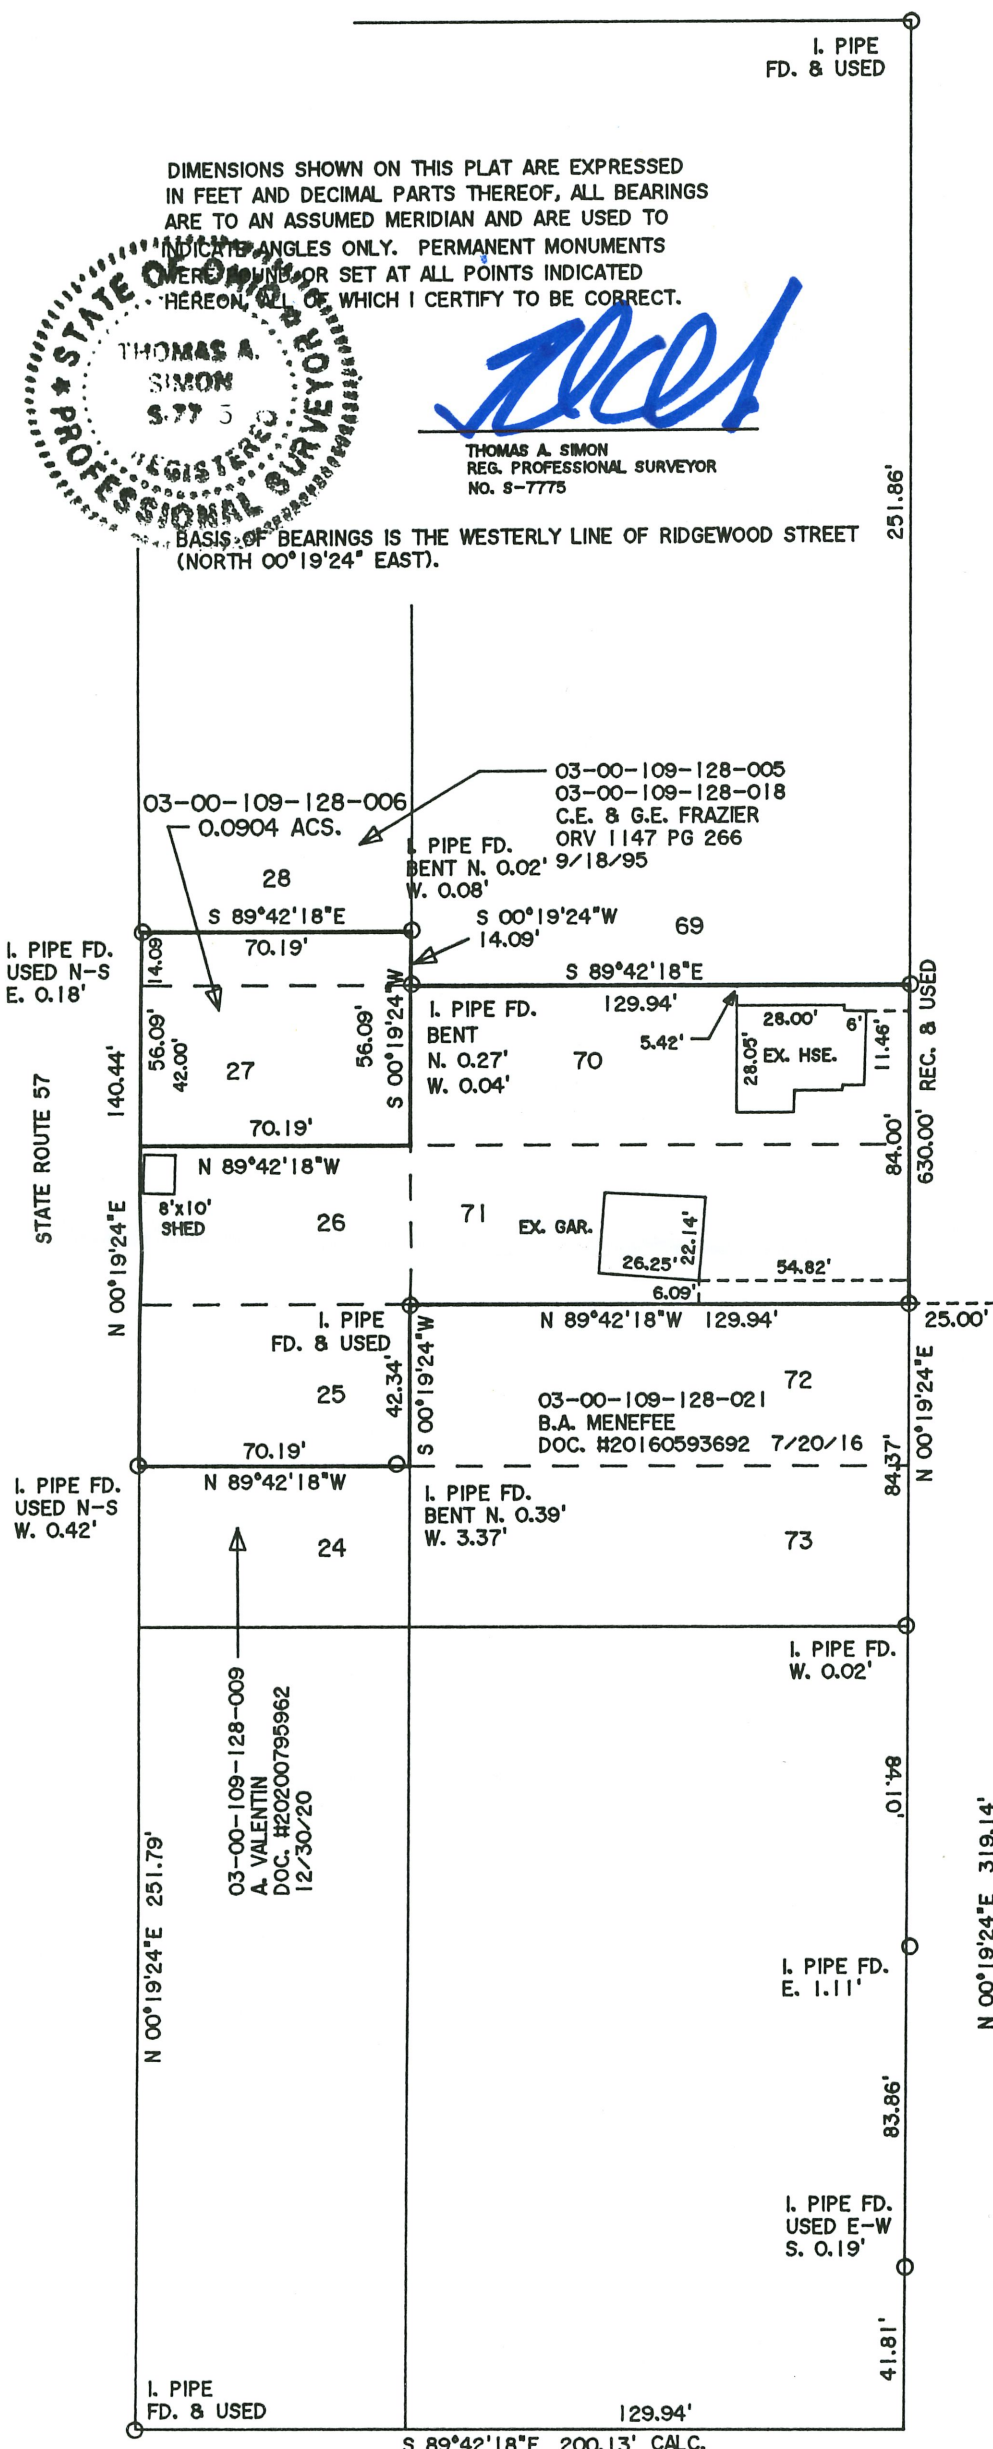

Survey # 50421

APPROVED
LORAIN CO.
MAP DEPT

DATE 10-18-21

PAGE 03-00-109

BY D. Adelsberg

03-00-109-128-006

RIDGEWOOD STREET (50')

PLAT OF BOUNDARY SURVEY FOR MIKLE & LORETTA FRAZIER BEING KNOWN AS PARTS OF SUBLOT NOS. 25, 26, 27 70 AND 71 IN COULTER & SANFORD'S RIDGEWOOD ALLOTMENT AS RECORDED IN PLAT VOLUME 7 PAGE 5 OF LORAIN COUNTY MAP RECORDS AND PART OF ORIGINAL SHEFFIELD TOWNSHIP LOT NO. 109

COUNTY OF LORAIN STATE OF OHIO OCTOBER, 2021 SCALE: 1" = 50'

THOMAS SIMON & ASSOCIATES, INC. PROFESSIONAL LAND SURVEYORS

150 SOUTH OLIVE STREET ELYRIA, OHIO 44035 (440) 327-2925 FAX 327-2964

WILSON STREET (50')