


SITUATED IN A PORTION OF ORIGINAL
EATON TOWNSHIP LOT 63 AND LOT 78 IN
THE TOWNSHIP OF EATON, COUNTY OF
LORAIN AND STATE OF OHIO

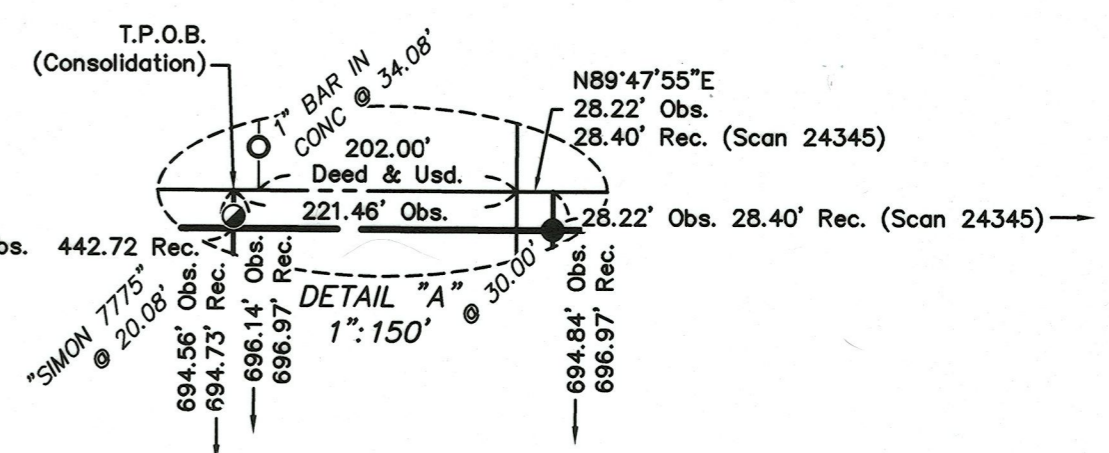

LEGEND:

- Fnd. - FOUND
- Msd. - MEASURED
- Obs. - OBSERVED
- Rec. - RECORD
- Usd. - USED
- - IRON PIN FOUND W/CAP
- - 5/8" IRON PIN SET W/CAP CUNNINGHAM
- - IRON PIN FOUND (NO CAP)
- ⊗ - IRON PIPE FOUND
- - MONUMENT BOX

REFERENCE:


- LORAIN COUNTY RECORDER'S RECORDS
- COUNTRY PLACE SUBDIVISION NO. ONE VOL. 31, PG. 1
 - COUNTRY PLACE SUBDIVISION NUMBER TWO VOL. 31, PG. 17
 - SCAN # 24345
 - SCAN # 24346
 - SCAN # 24349
 - SCAN # 24351
 - SCAN # 32523
 - SCAN # 38729
 - SCAN # 47981
 - SCAN # 47982
 - SCAN # 49083
 - SCAN # 49917
 - SCAN # 50084
- DEEDS AS LISTED HEREON

50507
APPROVED
LORAIN CO. MAPDEPT
DATE 2/14/22
PAGE 11-00-078
BY A. Cariden
#22-04439

CERTIFICATION:

I HEREBY CERTIFY THIS DRAWING TO BE OF A SURVEY MADE BY ME AND/OR UNDER MY DIRECT SUPERVISION AND TO BE TRUE AND ACCURATE TO THE BEST OF MY KNOWLEDGE.

DISTANCES ARE GIVEN IN FEET AND DECIMAL PARTS THEREOF. BEARINGS ARE REFERENCED TO AN ASSUMED MERIDIAN AND ARE USED TO INDICATE ANGLES ONLY.

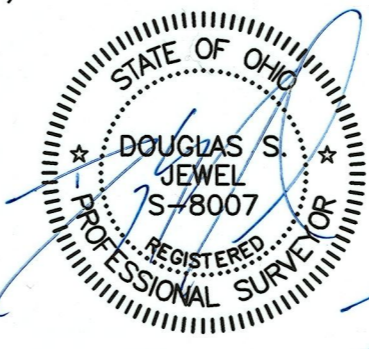

DOUGLAS S. JEWEL, OHIO PROFESSIONAL SURVEYOR S-8007
DATE 20 JANUARY 2022

PLAT OF SURVEY

LOCATED IN TOWNSHIP OF EATON COUNTY OF LORAIN STATE OF OHIO

CUNNINGHAM & ASSOCIATES, INC.
CIVIL ENGINEERING and SURVEYING
203 W. LIBERTY ST. MEDINA, OHIO 44256 330-725-5980

DRAWN BY: SG
DATE: 12/14/2021
CHECKED BY: DSJ
DATE: 12/21/2021
PROJECT No. 21-271
ACAD FILE No. M:\121-271 Plat
SCALE: 1"=150'

SHEET NO. 1/1