


50527
 ASSIGNED
 LUCAS CO.
 MAPPER
 DATE: 3/11/22
 PAGE: 15-00001
 BY: A. Carlson
 3-23-048.074

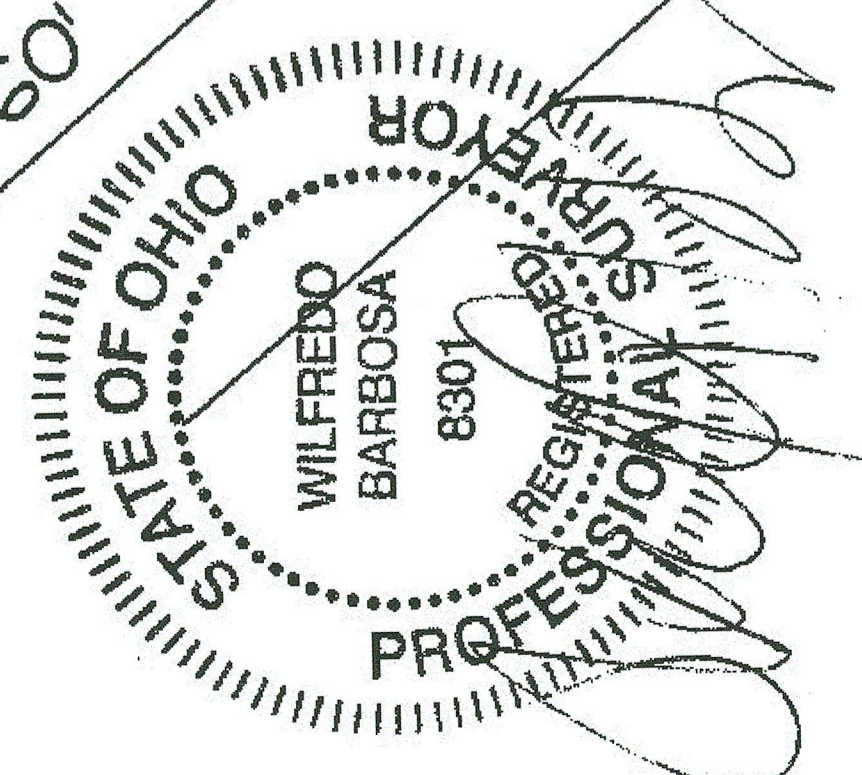


- LEGEND:
- ⊕ = DRILL HOLE FOUND
 - ⊙ = 5/8" REBAR SET WITH I.D. CAP
 - = PIPE FOUND ● = PIPE USED
 - ▲ = IRON PIN/ REBAR FOUND
 - △ = IRON PIN/ REBAR FOUND AND USED
 - = MONUMENT BOX □ = STEEL POST
 - R, REC = RECORD U = USED
 - C, CALC = CALCULATED T.M. = TAX MAP
 - Obs = OBSERVED CL = CENTERLINE

Revised: 3/11/2022

BARBOSA AND ASSOCIATES LLC
 5604 CASE ROAD
 NORTH RIDGEVILLE, OH 44039
 440 327-4776

PREPARED AT THE REQUEST OF:
 Roger Bunch

GRAPHIC SCALE

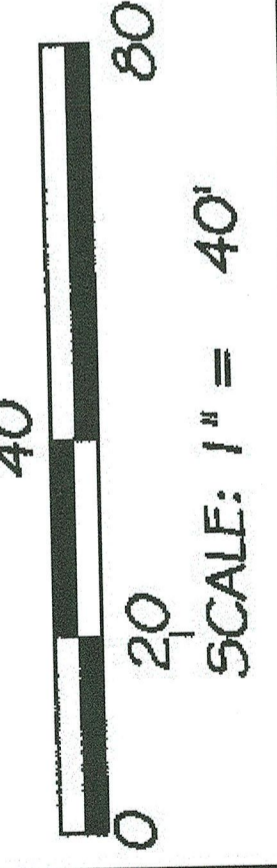

March 9, 2022 JOB No: 2022-2-2

BOUNDARY RETRACEMENT
 PARCEL 16-00-001-111-030
 PART OF SUBLOTS 4, 5 & 6
 IN AUGUST BANK'S SUBN. PLAT VOLUME 4 PAGE 34
 AND PART OF LOT 89 AND OVERLAPPING PART OF LOTS 90 & 91
 IN ORIGINAL PLAT OF RAWSONVILLE PLAT VOLUME 1 PAGE 23
 ORIGINAL GRAFTON TOWNSHIP LOT 1
 VILLAGE OF GRAFTON COUNTY OF LORAIN
 STATE OF OHIO