

- INDICATES IRON PIPE FOUND
- ◇ INDICATES RR SPIKE FOUND
- INDICATES WOOD POST FOUND
- ⊙ INCATES 1/2" IRON PIN & CAP SET


MAP OF SURVEY
FOR
WILLIAM KELLER

PART LOTS 33 & 48 BROWNHELM TWP
LORAIN COUNTY STATE OF OHIO
APRIL 2022 SCALE 1"=100'

APPROVED
LORAIN CO. MAINT
DATE 6/10/22
PAGE 01-00-033-048
BY ACorden
#22-04498
50600

I HEREBY CERTIFY THE WITHIN TO BE A TRUE REPRESENTATION OF A SURVEY MADE BY ME. THE BEARINGS ARE BASED ON ODOT VRS.

Daniel E. Hartung, Jr. 4/27/2022
DANIEL E. HARTUNG, JR., PE, PS

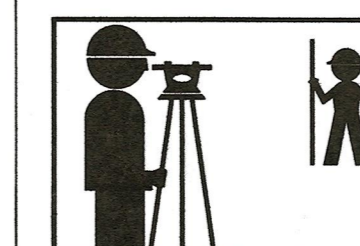

HARTUNG & ASSOCIATES
ENGINEERS & SURVEYORS

P.O. BOX 426, 346 NORTH MAIN ST., HURON, OH 44839-0426
(419) 433-4321 FAX (419) 433-7879

DANIEL E. HARTUNG JR., PE, PS