



LORAIN BOARD OF EDUCATION
 3-14-56 VOL 660 PG 94

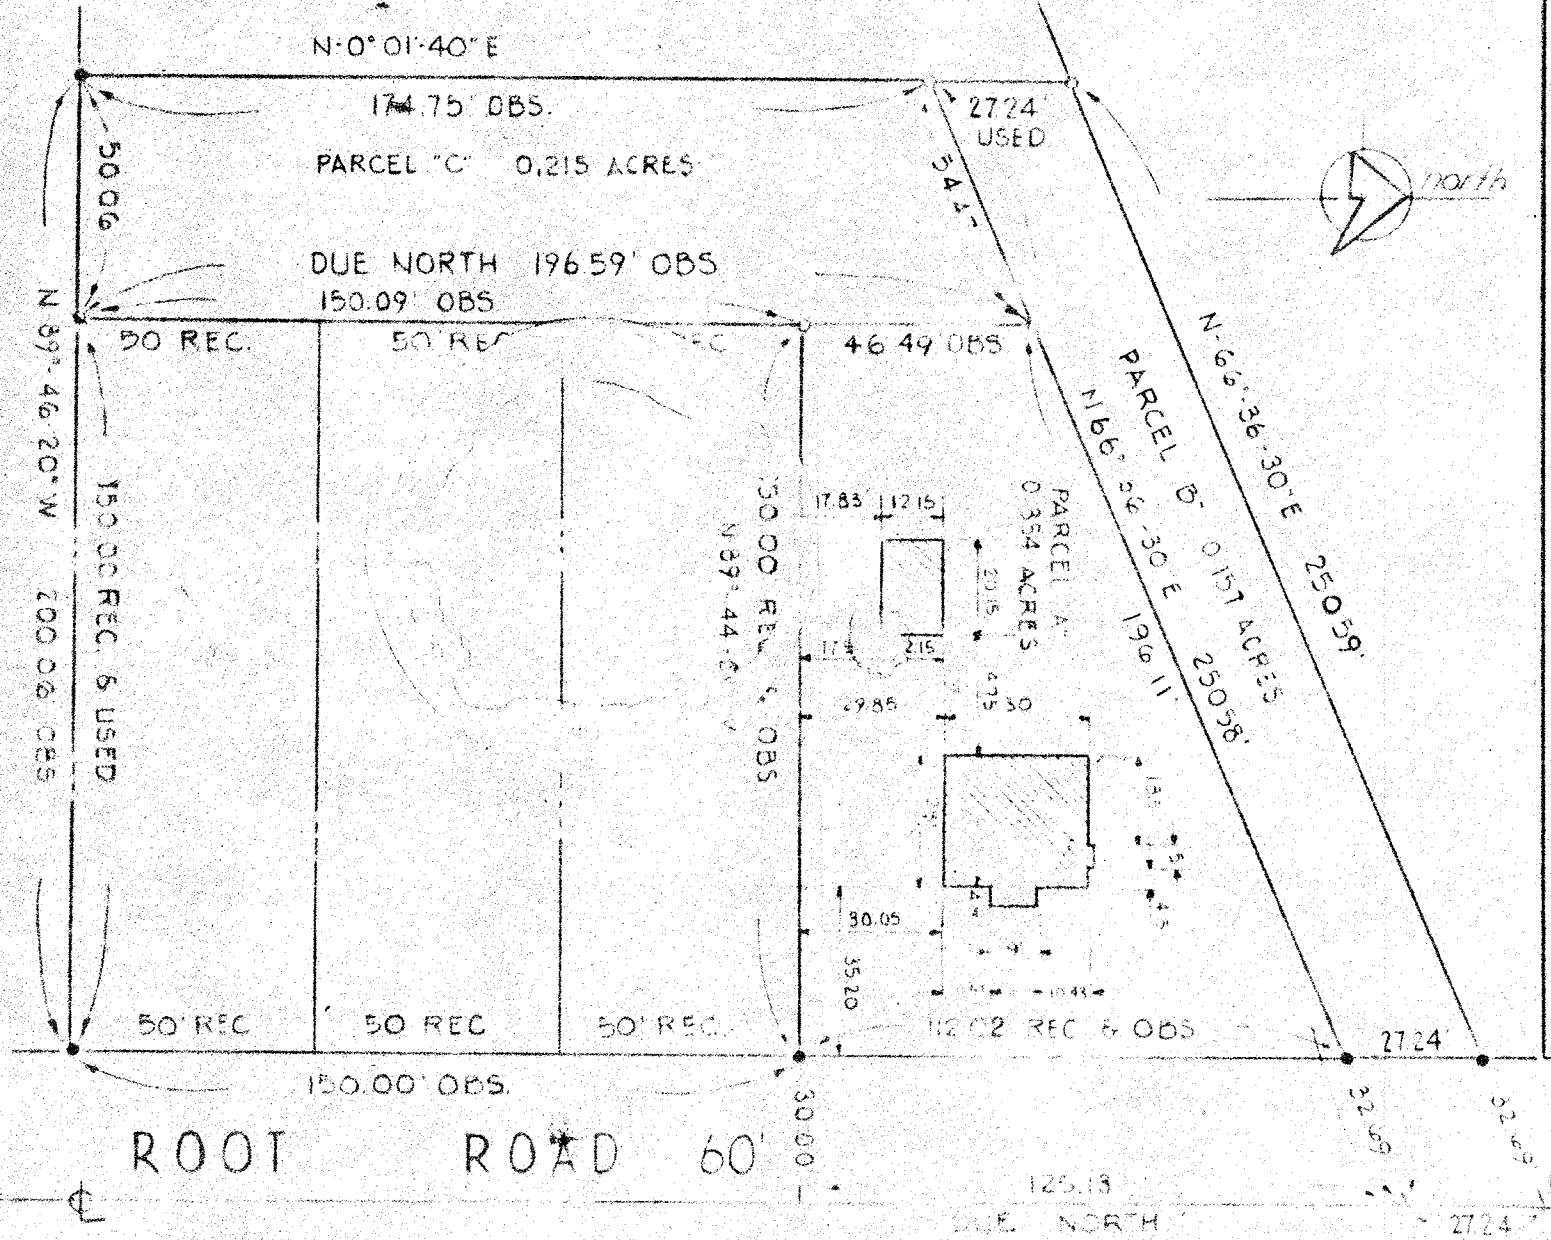

SURVEY FOR KJA ADJUSTS
 PART OF PL 16 JEFFERSON TWP
 NOW THE CITY OF LORAIN, OHIO
 BUT 9-71 SCALE 1"=40'

SCHAFER, HURA & ASSOCIATES, INC.
 ENGINEERS AND SURVEYORS
 4370 OBERLIN AVE.
 LORAIN, OHIO

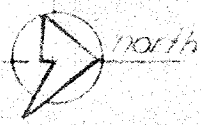

APPROVED
 LORAIN CO.
 MAP DEPT

DATE 7/15/22

PAGE 03-00-046

BY WRZ

22-04902-C
 50640

LEGEND
 • I.P.F.D.
 ○ I.P.SET
 □ I.P.F.D. GREAT