



Note: Bearings and Coordinates Shown are based on the Ohio State Plane (Grid North) But are used to describe angles only.

Being known as sublot Part of Original Lot 14 of Russia Township, now in the Village of South Amherst and being known as Lorain County Parcel Numbers 09-00-014-101-065, County of Lorain and the State of Ohio.

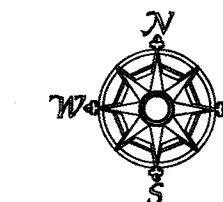

Scale 1" = 80'
September 19, 2022

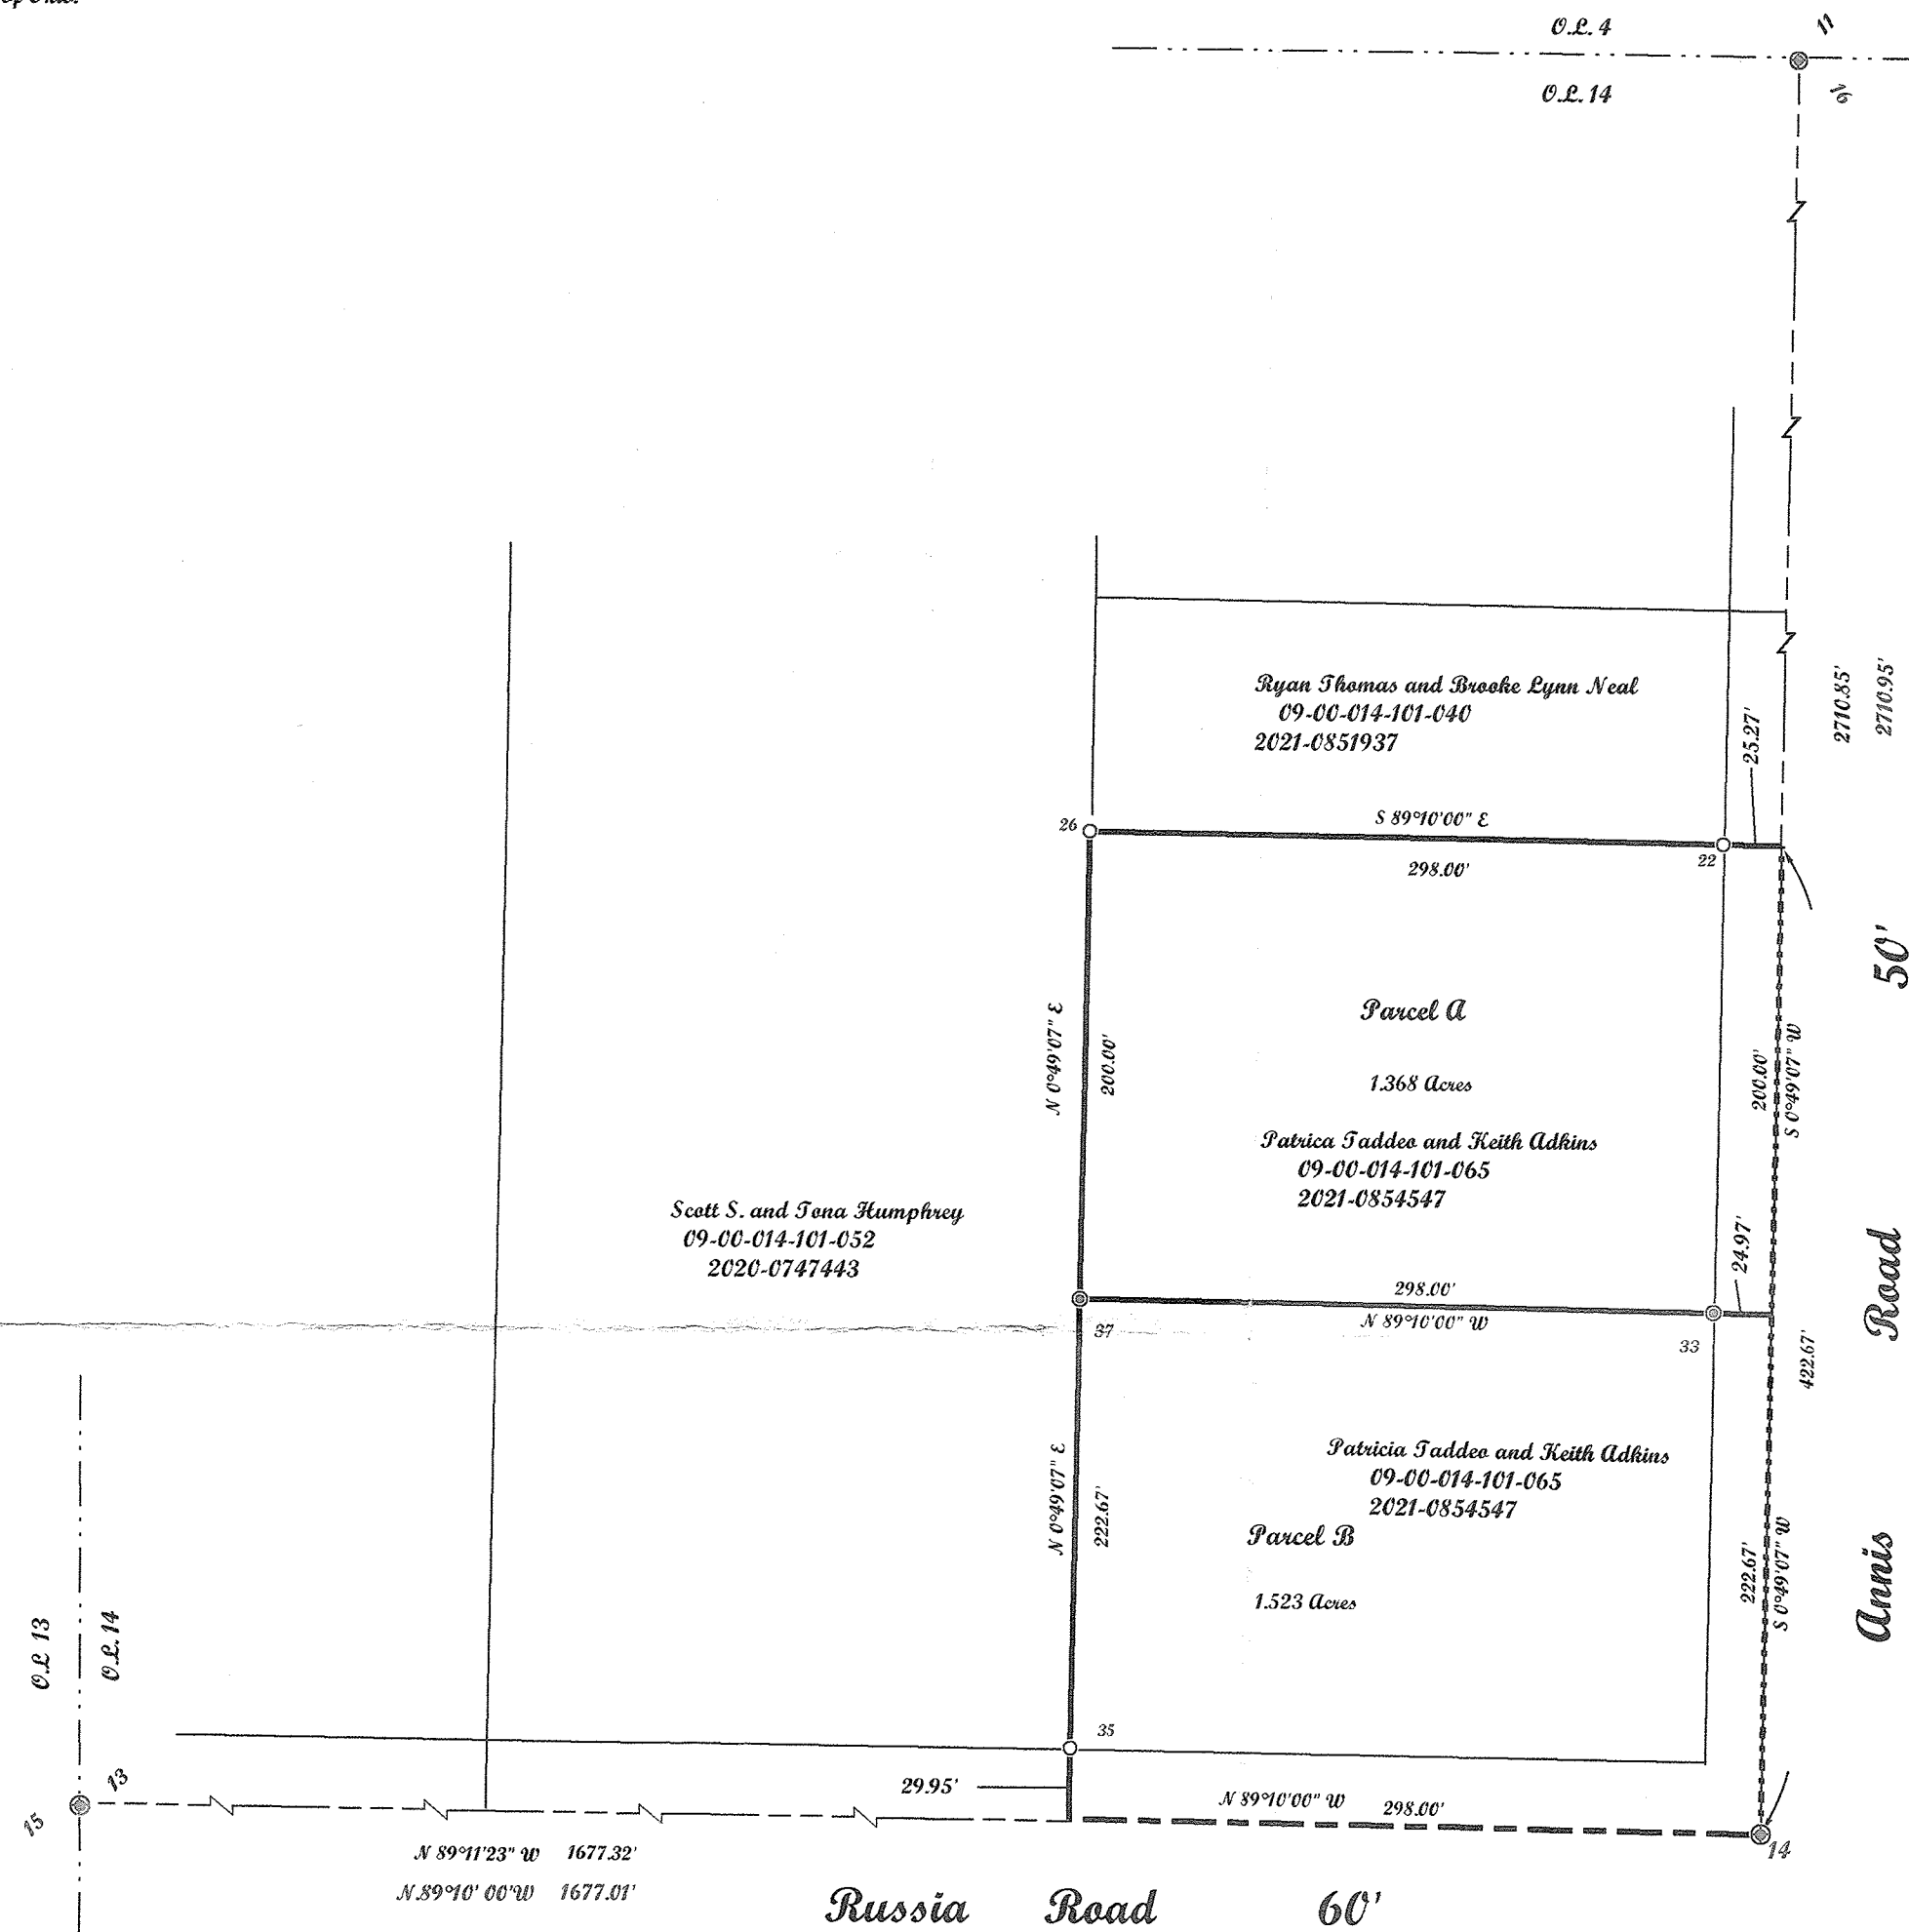

APPROVED
LORAIN CO.
MAP DEPT
DATE 11/21/22
PAGE 09-00-014
BY WRZ
22-04584
50743

| POINTS | DESC |
|--------|----------------------------------|
| 14 | IRON PIN FOUND IN A MONUMENT BOX |
| 15 | IRON PIN FOUND IN A MONUMENT BOX |
| 16 | IRON PIN FOUND IN A MONUMENT BOX |
| 22 | REBAR FOUND |
| 26 | REBAR FOUND |
| 33 | REBAR SET |
| 35 | REBAR FOUND |
| 37 | REBAR SET |

David J. Gyskowski
11-7-2022

McGannon Surveying, LLC
Boundary Survey
Patrick A. McGannon
Registered Professional Surveyor
1731 Gettysburg Drive, Lorain, Ohio 44053 (440) 282-2712
www.mcannonssurveying.com

Note: Only copies signed with Red ink shall be considered Valid.
Patrick A. McGannon
Patrick A. McGannon P.S. 7154

Prepared for Patricia Taddeo and Keith Adkins of
10100 Baumhart Road
Amherst, Ohio 44001.

P.L.S.O.
Member Number 2433

Note: Dimensions shown in Blue are record values and those shown in red are field observed values.
Adkins 2022.tbx F.N. 1672A