
DIMENSIONS SHOWN ON THIS PLAT ARE EXPRESSED IN FEET AND DECIMAL PARTS THE REOF, ALL BEARINGS ARE TO AN ASSUMED MERIDIAN AND ARE USED TO INDICATE ANGLES ONLY. PERMANENT MONUMENTS WERE FOUND OR SET AT ALL POINTS INDICATED HEREON, ALL BE ON WHICH I CERTIFY TO CORRECT.

THOMAS A. SIMON, REGISTERED PROFESSIONAL SURVEYOR NO. S-7775

40 80 120

BASIS OF BEARINGS IS THE NORTHERLY LINE OF BRACE AVENUE (N 89°23'43" EAST). IRON PINS SET ARE 3/8" DIAMETER, 30" LONG WITH PLASTIC CAPS "T. SIMON, S-7775".

> **GARDEN ACRES ALLOTMENT** PLAT VOL. 9 PG. 27

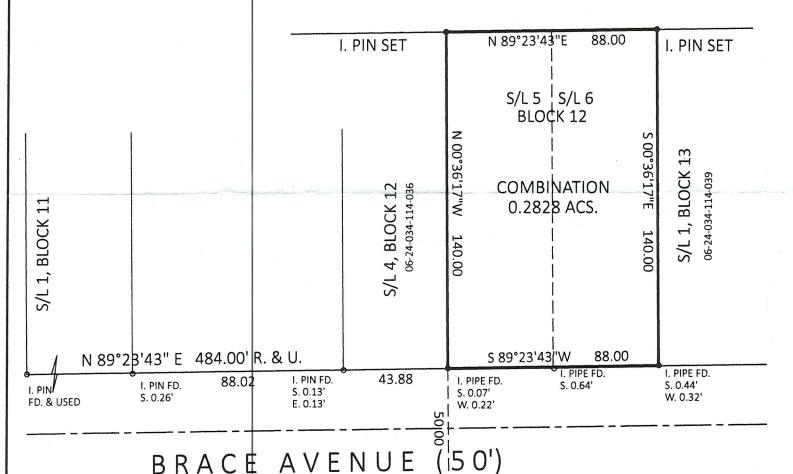

BRACE AVENUE

FD. & USED

MAP DEPT PAGE

THOMAS SIMON & ASSOCIATES, INC.

PROFESSIONAL LAND SURVEYORS

150 SOUTH OLIVE STREET ELYRIA, OHIO 44035 (440) 327-2925 TASIMON@WINDSTREAM.NET

PLAT OF BOUNDARY SURVEY AND COMBINATION **FOR** CARMEN BROOKS WHITE

BEING KNOWN AS ALL OF SUBLOT NOS. 5 & 6 BLOCK 12 IN THE ACRE FARMS ALLOTMENT NO. 1 AS RECORDED IN PLAT VOLUME 9 PAGE 21 OF LORAIN COUNTY MAP RECORDS AND PART OF ORIGINAL ELYRIA TOWNSHIP LOT NO. 34, WEST OF THE BLACK RIVER

CITY OF ELYRIA COUNTY OF LORAIN STATE OF OHIO

OCTOBER, 2023 SCALE: 1" = 40'