



MAP OF SURVEY

PREPARED FOR
SERENITY HOMES USA LLC
PARCEL NO. 0300103113032

Situated in the City of Lorain, County of Lorain and State of Ohio and known as being the Sublot Nos. 26 & 25 Block No. 10 in A.G. Frisbee's City View Allotment of part of Original Lot No. 103, Sheffield Township as shown by the Recorded in Plat Volume 6 of Maps, Page 8 of Lorain County County Records.

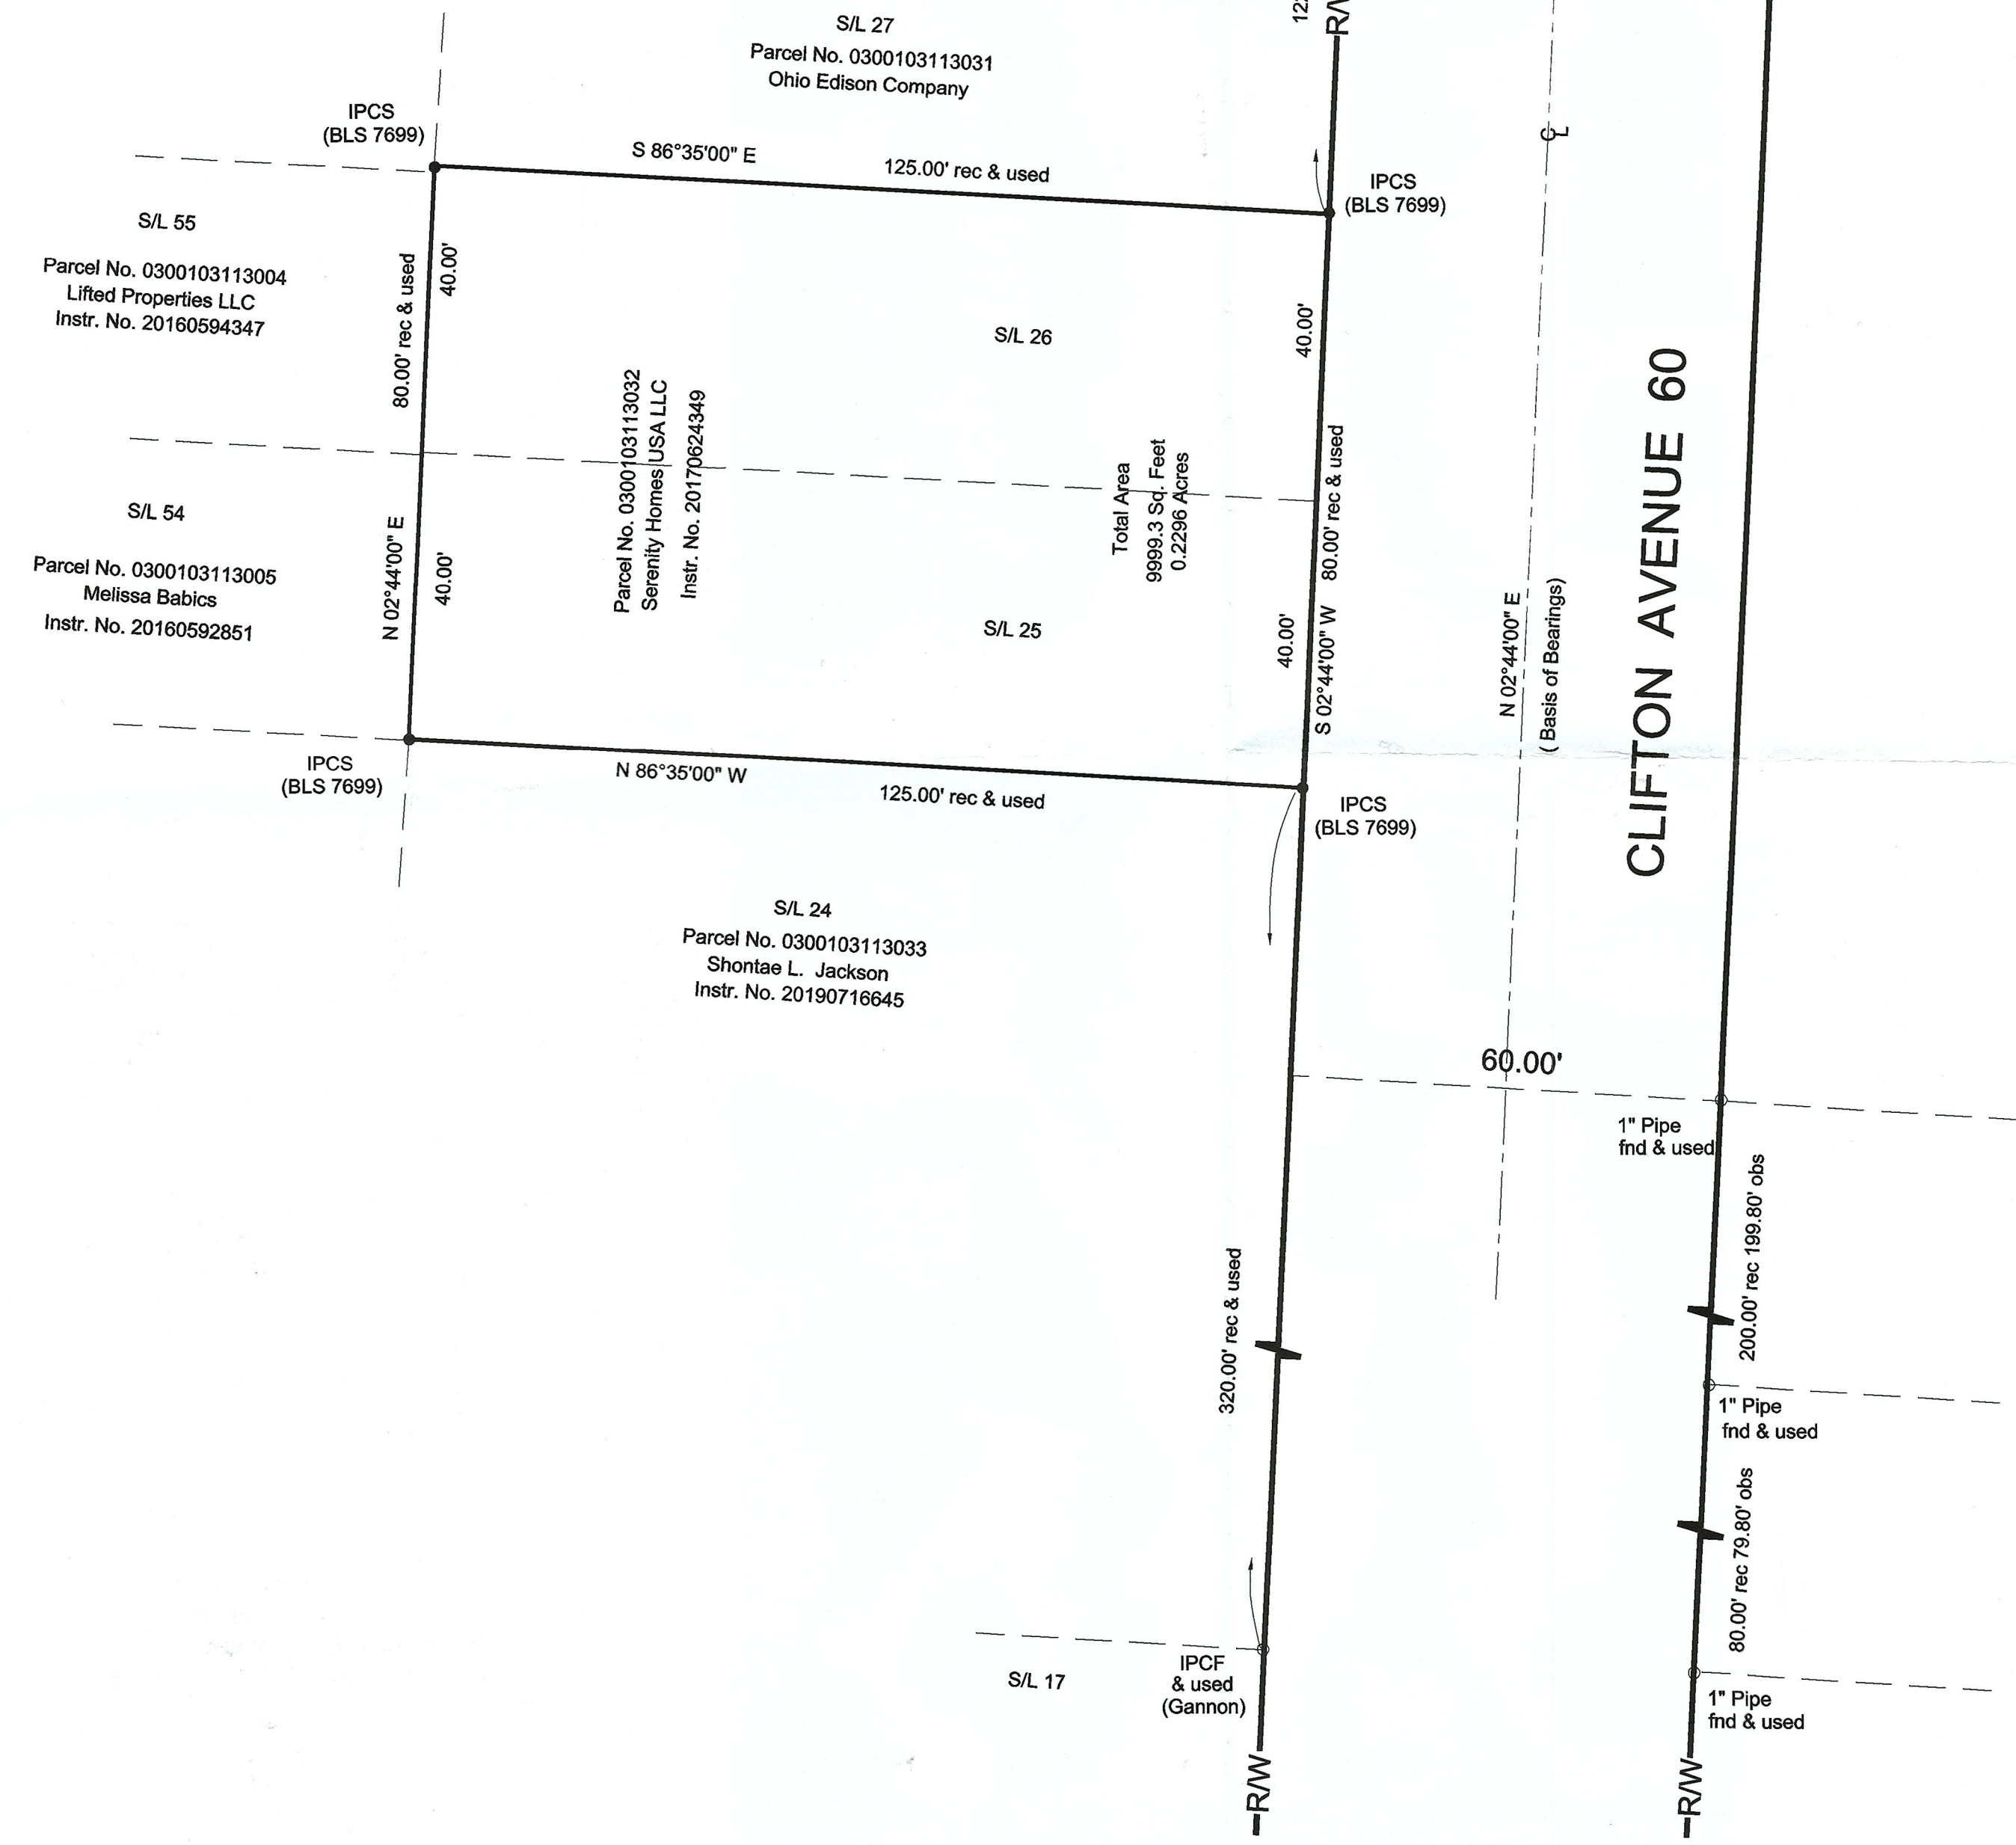

51148
APPROVED
LORAIN CO
MAP DEPT
 DATE 4/13/24
 PAGE 03-00103
 BY A. Carden
 # 24-05269-C

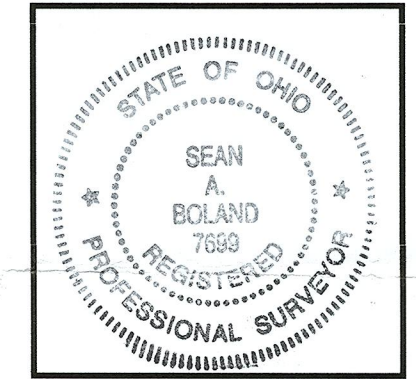

Certification

This Plat was prepared from the analysis of Recorded Plats, Recorded Deeds and Lorain County Records. Bearings are to an assumed meridian and indicate angles only. Distances are given in feet and decimal parts thereof. All of which I certify to be correct to the best of my knowledge.

Sean A. Boland 3/27/24
 Sean A. Boland, P.S.
 Registered Ohio Professional Surveyor 7699
 440 785-2943
 bolandsurveying@gmail.com

Legend

- IPCS = Iron Pin Capped Set
- IPCF = Iron Pin Capped Found
- IPF = Iron Pin Found
- IPMF = Iron Pin Monument Found
- ⊗ DHS = Drill Hole Set
- IPS = Iron Pin Set
- STMF = Stone Monument Found W/Drill Hole