
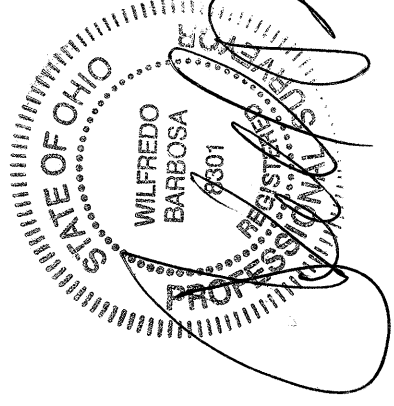
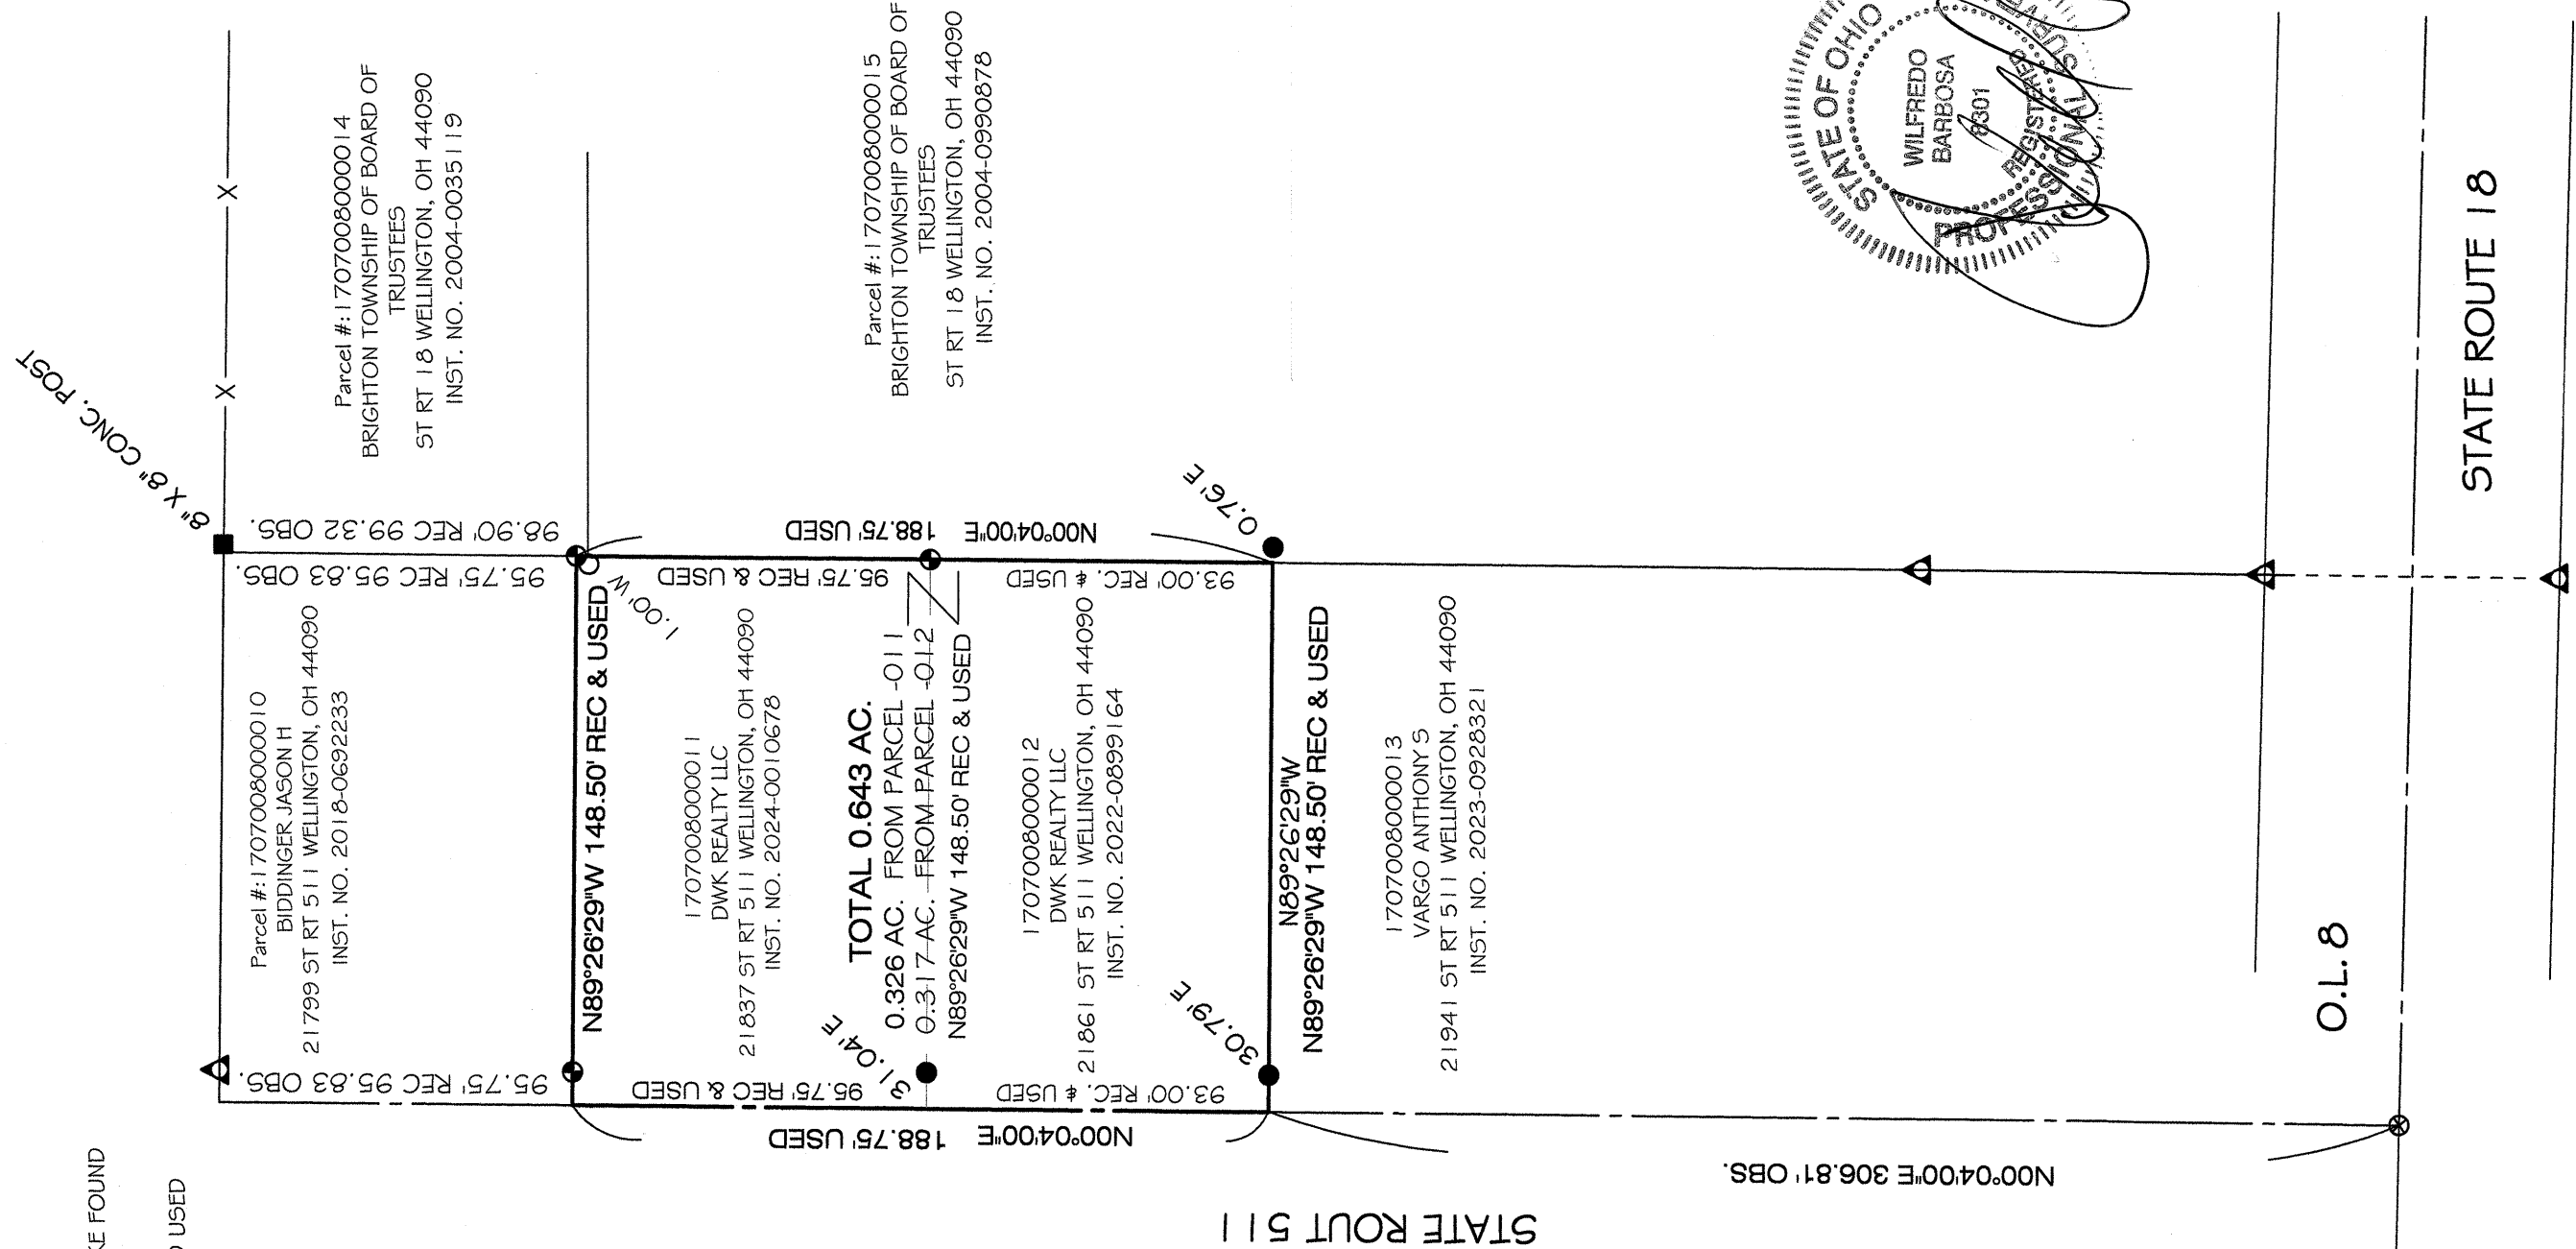


- LEGEND:**
- ⊕ = 5/8" REBAR SET WITH I.D. CAP
  - ⊗ = PIPE FOUND
  - ⊙ = PIPE FOUND AND USED
  - = PIPE FOUND AND USED
  - ▲ = IRON PIN/ REBAR FOUND
  - △ = IRON PIN/ REBAR FOUND AND USED
  - = MONUMENT BOX

<b>APPROVED</b>
<b>LORAIN CO</b>
<b>MAP DEPT</b>
<b>DATE</b> 5/23/24
<b>PAGE</b> 17-07-008
<b>BY</b> WRZ
24-04860

51194

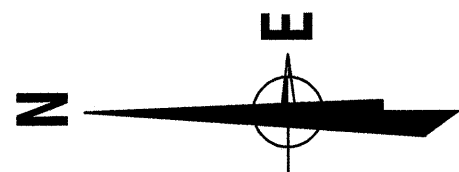

SCALE: 1" = 50'

PREPARED AT THE REQUEST OF:  
DWK REALTY LLC

**Survey Consolidation**  
Part of Original Brighton Township Lot 8, Tract 7  
COUNTY OF LORAIN STATE OF OHIO

**BARBOSA AND ASSOCIATES LLC**  
5604 CASE ROAD  
NORTH RIDGEVILLE, OH 44039  
440 327-4776

CHECKED BY: WB  
2/12/2024  
JOB No: 2023-12-2  
SHEET 1 of 1