
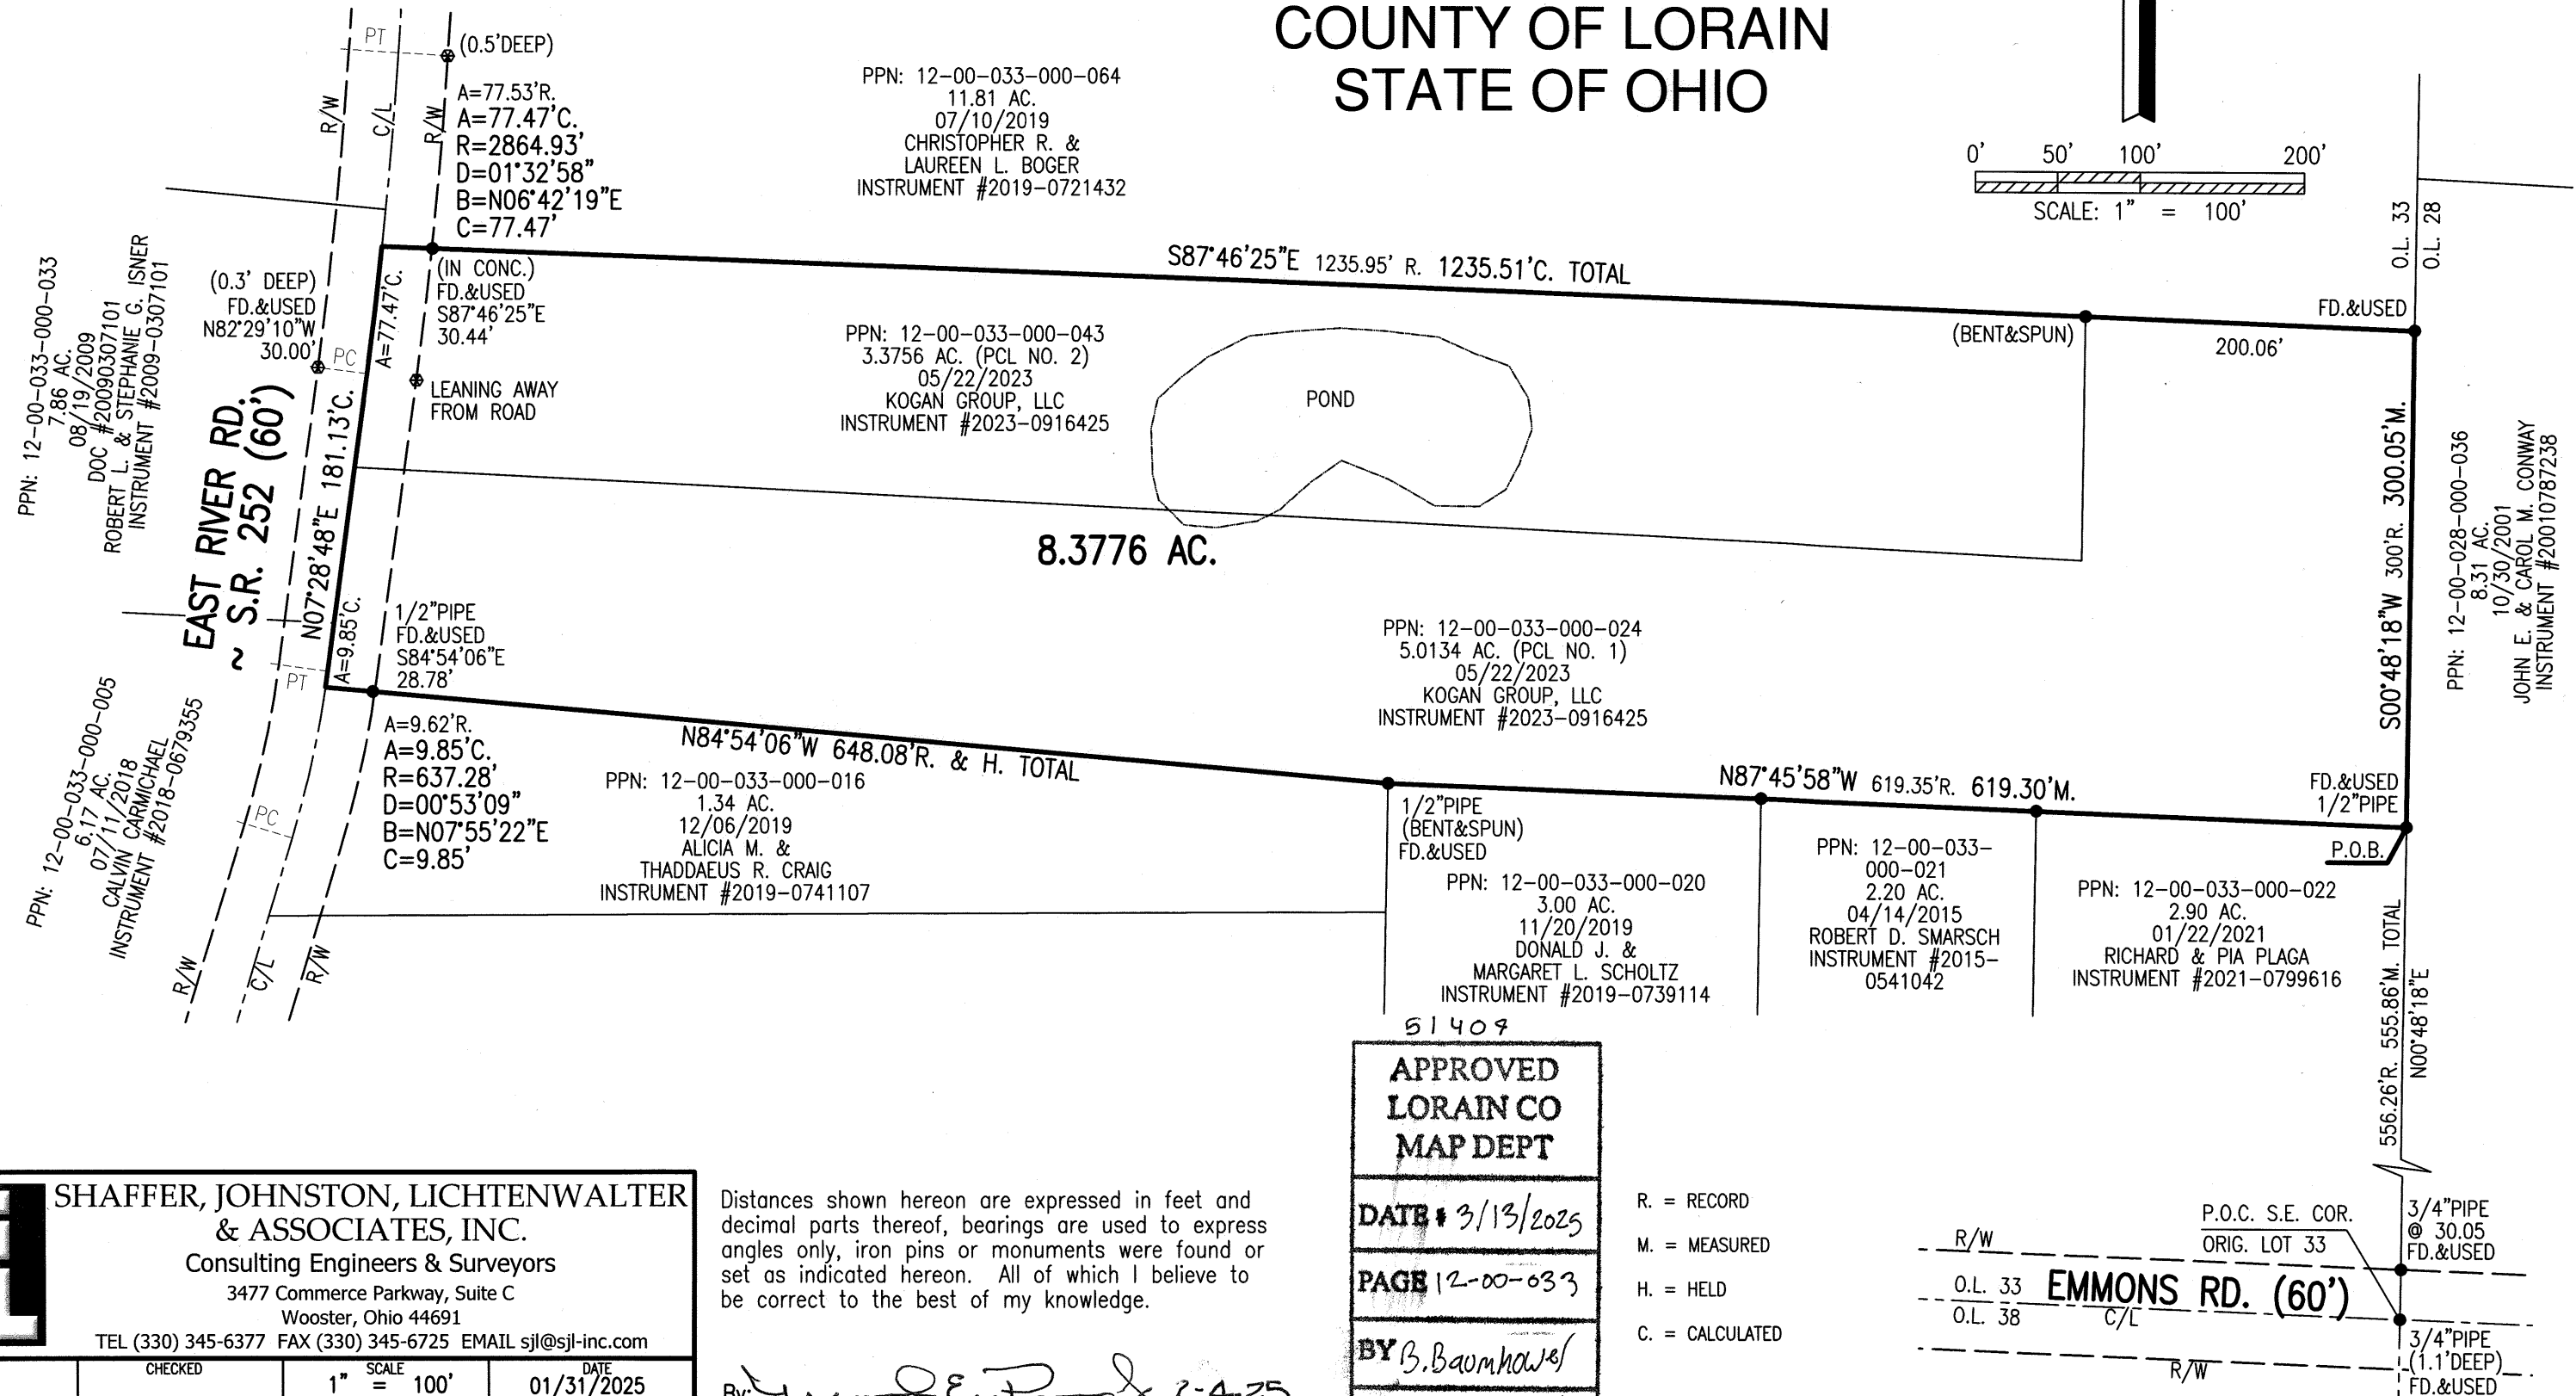


_____ CENTERLINE
 _____ R/W LINE
 _____ EX. PROPERTY LINE
 _____ PROP. PROPERTY LINE
 _____ POND

- 3/4" PIPE FD.
(UNLESS NOTED)
- ⊗ CONC. ODOT R/W
MARKER FD.

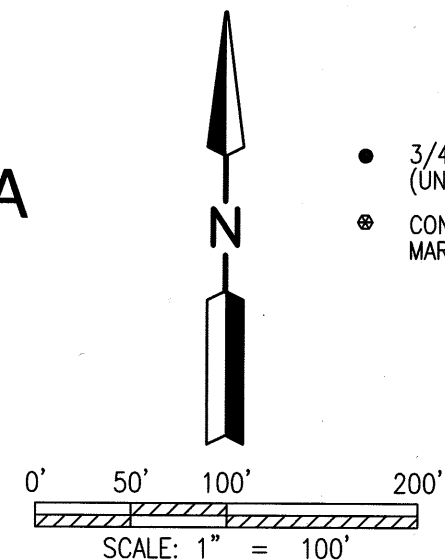

Consulting Engineers & Surveyors

3477 Commerce Parkway, Suite C
Wooster, Ohio 44691

TEL (330) 345-6377 FAX (330) 345-6725 EMAIL sjl@sjl-inc.com

Distances shown hereon are expressed in feet and decimal parts thereof, bearings are used to express angles only, iron pins or monuments were found or set as indicated hereon. All of which I believe to be correct to the best of my knowledge.

By: Mark E. Purdy 2-4-25
Mark E. Purdy, P.S. #7307 Date

APPROVED
LORAIN CO
MAP DEPT

DATE: 3/13/2025

PAGE 12-00-633

BY *B. Baumhowe*

25-04987

R. = RECORD
M. = MEASURED
H. = HELD
C. = CALCULATED