



Note: Bearings and Coordinates shown are based on the Ohio State Plane (Grid North) using grid coordinates. But are used to describe angles only.

Being known as subplot part of Original lot 9 of LaGrange Township and known as Lorain County parcel number 15-00-009-000-005, County of Lorain and the State of Ohio.

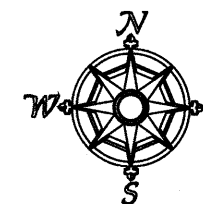

Scale 1" = 80'
April 26th 2025

Point Table	
Point	Description
21	IRON PIN FOUND IN A MONUMENT BOX
22	IRON PIN FOUND
23	IRON PIN FOUND
25	IRON PIN FOUND
27	REBAR FOUND
28	IRON PIN FOUND bent
30	IRON PIN FOUND bent
32	REBAR FOUND CAPED
33	barn
34	barn
35	barn
36	barn
37	REBAR SET
40	
41	

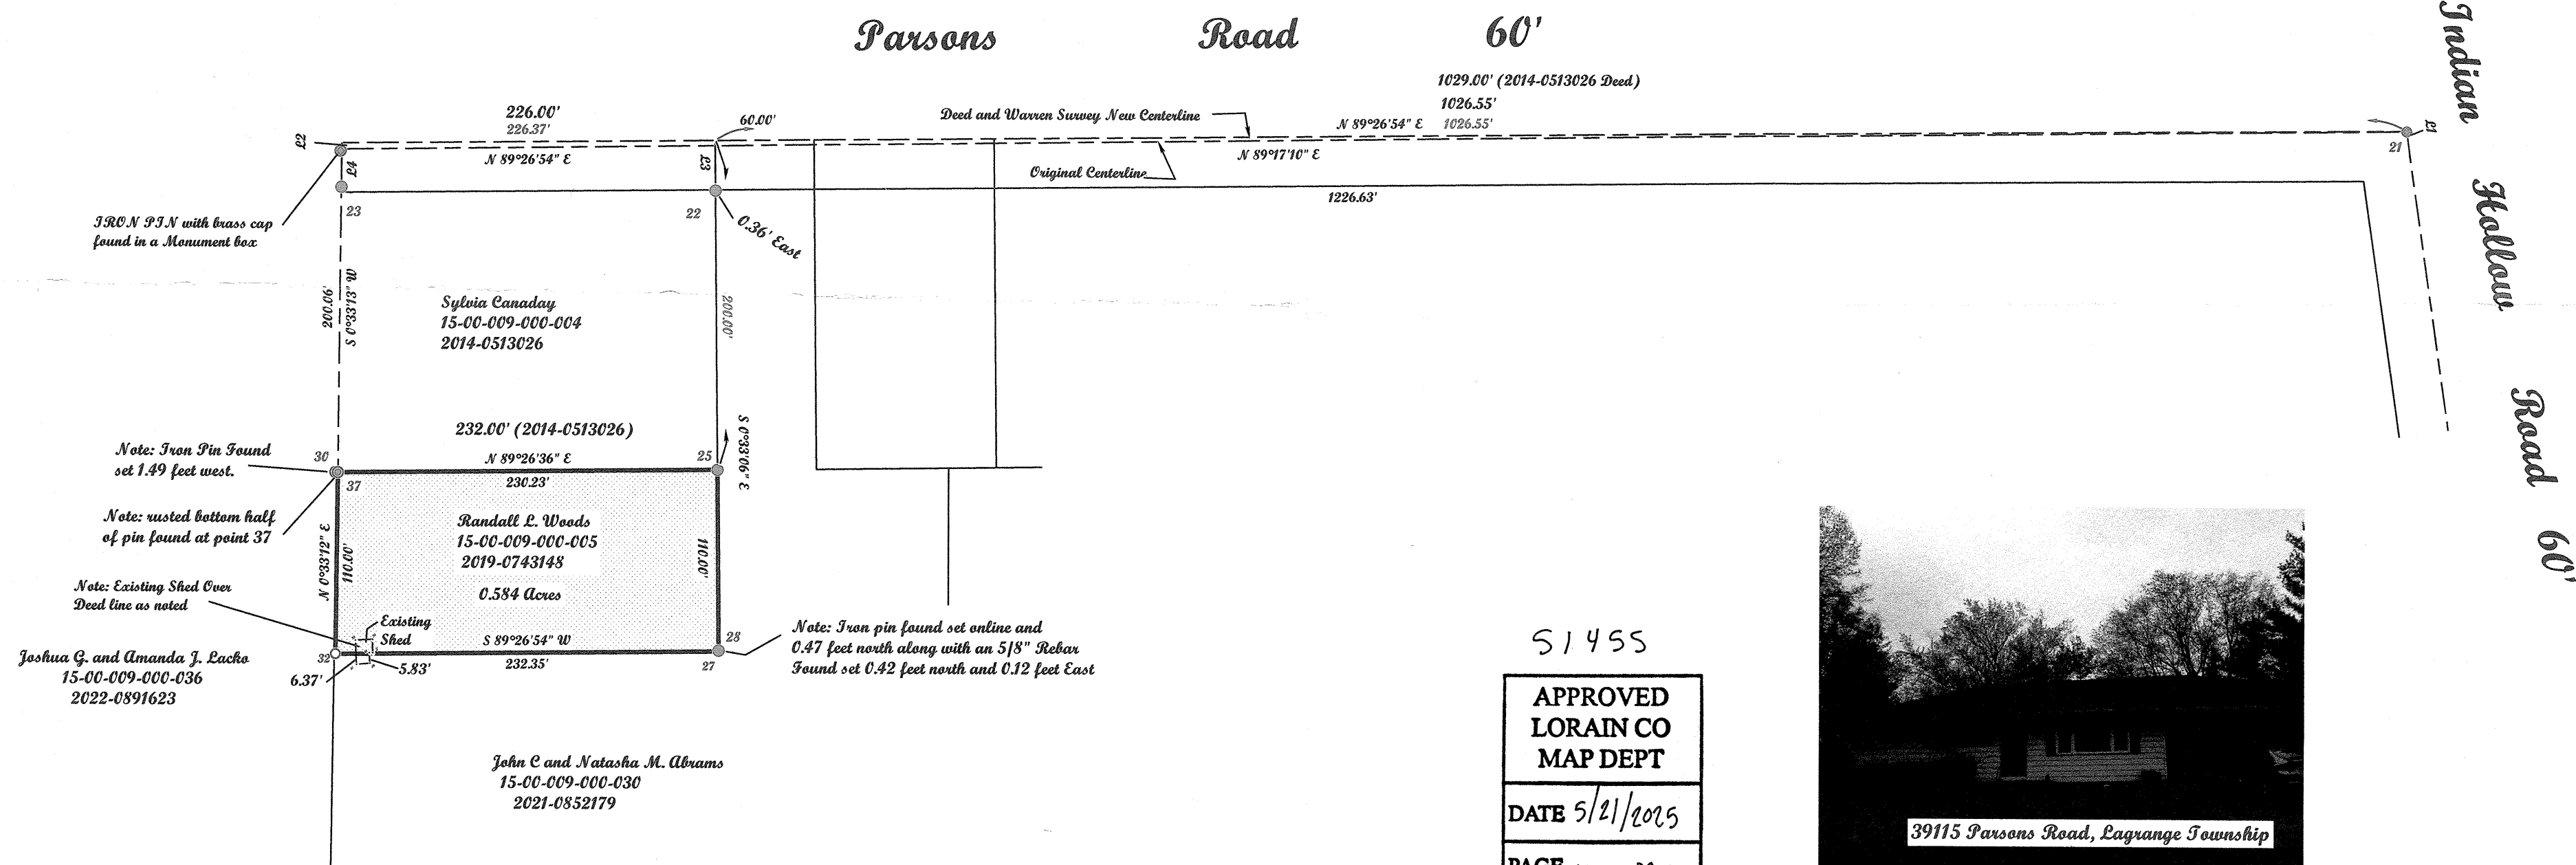


Line Table		
Line	Bearing	Distance
L1	S8°05'00"E	0.27'
L2	S0°33'13"W	3.82'
L3	S0°33'06"E	30.00'
L4	S0°33'13"W	22.95'

Note: Only copies signed with Red ink shall be considered Valid.

Patrick A. McGannon
Patrick A. McGannon P.S. 7154

Prepared exclusively for Estate of Randall L. Woods of 39115 Parson Road Grafton, Ohio 44044 under the term of the work order as if incorporated herewith.

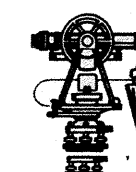

P.L.S.O.
Member Number 2433



Note: Dimensions shown in Blue are record values and those shown in Red are field observed values.

McGannon Surveying, LLC
Boundary Survey
Patrick A. McGannon
Registered Professional Surveyor
1731 Gettysburg Drive, Lorain, Ohio 44053 (440) 282-2712