

APPROVED
LORAIN CO
MAP DEPT


DATE 10/28/25

PAGE 10-00-016

BY WRZ

25-05062

51580

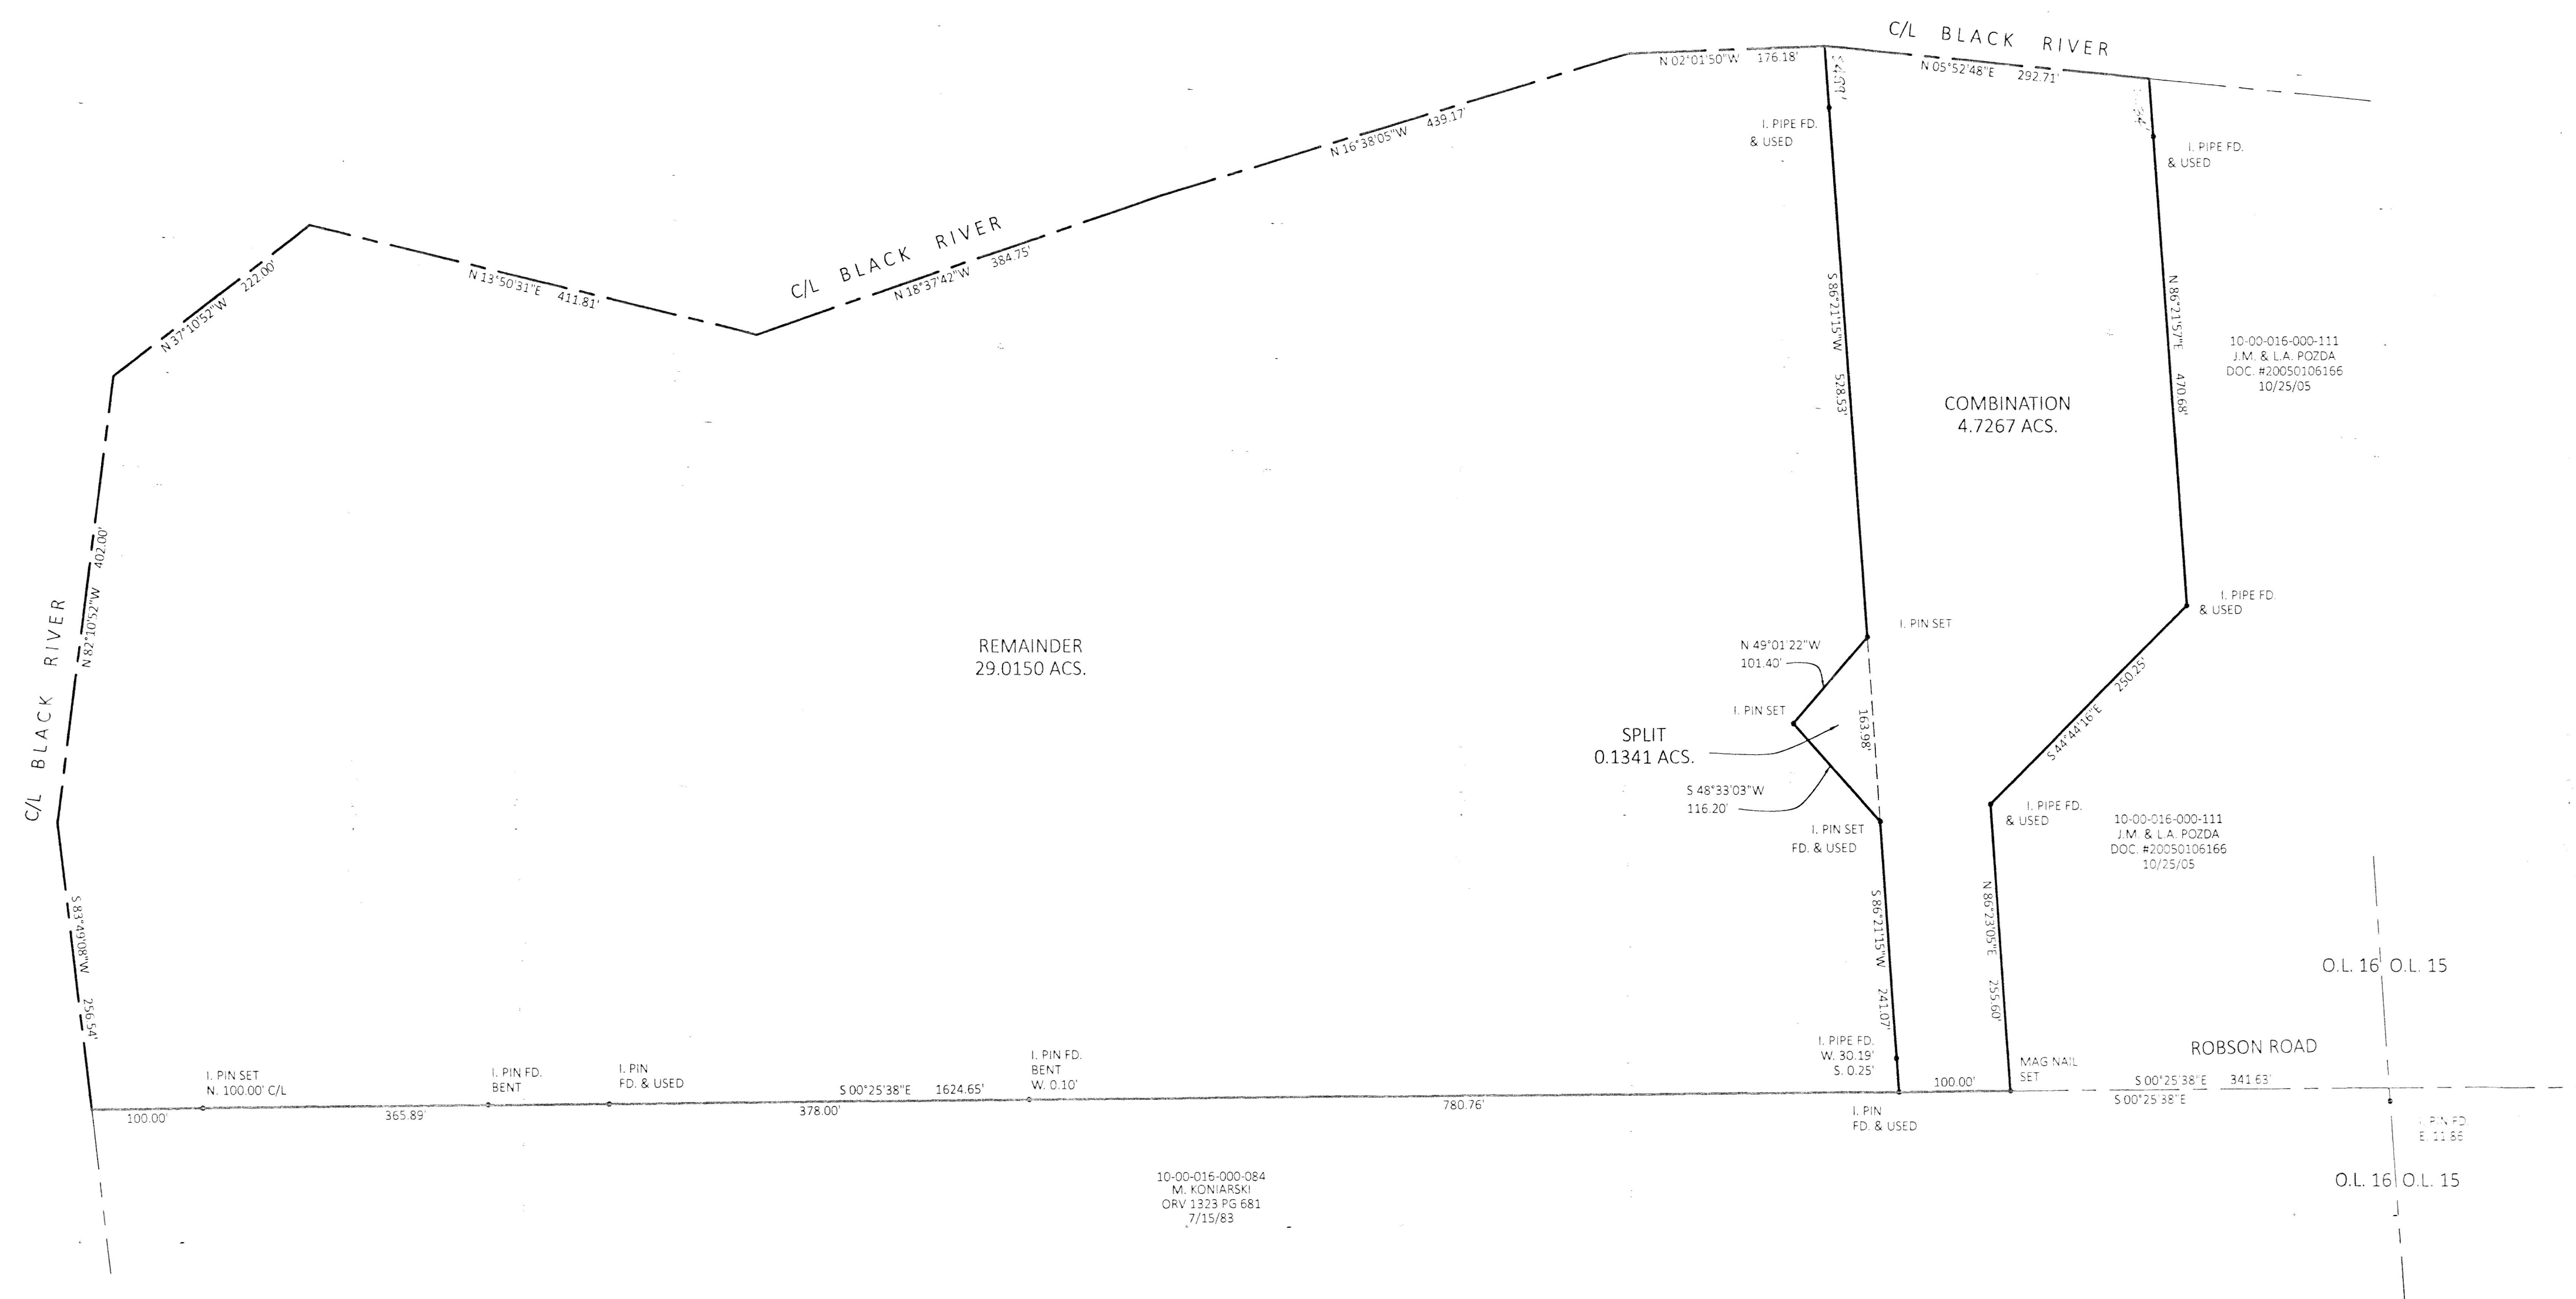

DIMENSIONS SHOWN ON THIS PLAT ARE EXPRESSED IN FEET AND DECIMAL PARTS THEREOF. ALL BEARINGS ARE TO AN ASSUMED MERIDIAN AND ARE USED TO DESCRIBE ANGLES ONLY. PERMANENT MONUMENTS WERE FOUND OR SET, AS INDICATED HEREON, ALL OF WHICH I CERTIFY TO BE CORRECT.

THOMAS A. SIMON, REGISTERED
PROFESSIONAL SURVEYOR NO. S-7775

BASIS OF BEARINGS IS THE CENTERLINE OF ROBSON ROAD,
(SOUTH 00°25'38" EAST). IRON PINS SET ARE 5/8" DIAMETER,
30" LONG WITH PLASTIC CAPS "T. SIMON, S-7775".

THOMAS SIMON & ASSOCIATES, INC.
PROFESSIONAL LAND SURVEYORS
13000 PINE HILL DRIVE
DAYTON, OHIO 45424
937.237.9200
TASIMON@ATTN.COM

PLAT OF BOUNDARY SURVEY
SPLIT AND COMBINATION
FOR
GLEN A. & LORNA L. CAREY
STEPHEN LEE & JOY LYNN ANDERSON
BEING KNOWN AS PART OF
ORIGINAL CARLISLE TOWNSHIP
SECTION NO. 16

COUNTY OF LORAIN STATE OF OHIO
AUGUST, 2025 SCALE: 1" = 100'