

NEVADA AVE. 60'

NEW HAMPSHIRE AVE. 60'

CREHORE STREET 60'


N89°57'46"W

0300055109042
VALLE MARLENE C
2603 CREHORE ST
I.N. 2024-0011287

0300055109045
LORAIN COUNTY HOMEBUYERS LLC
2635 CREHORE ST
I.N. 2025-0042168

GRAND HARBOUR HOLDINGS LLC
2643 CREHORE ST
I.N. 2007-0213683


113.81' OBS. 113.50' REC.

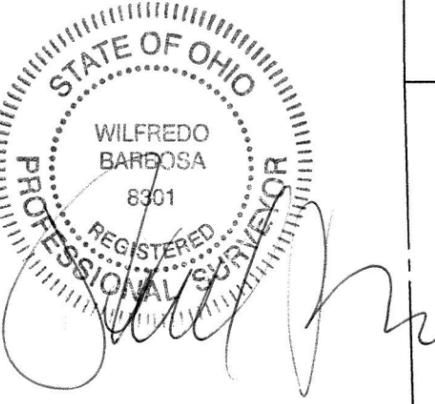

51635
APPROVED
LORAIN CO
MAP DEPT
DATE 1/7/26
PAGE 03-00-055
BY A Carden
#26-05648-C

PROPERTY ADDRESS:
2635 CREHORE ST.
LORAIN, OHIO 44052

BARBOSA AND ASSOCIATES LLC
5604 CASE ROAD
NORTH RIDGEVILLE, OH 44039
440 327-4776

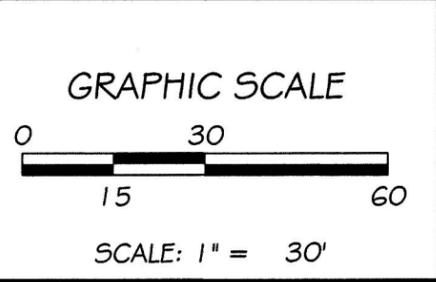

SURVEY
PARCEL 03-00-055-109-045
PARTS OF SUBLOTS 25,26,27,78,79,80
OF GEORGE RANDALL'S SUBN PV 8 PAGE 60
CITY OF LORAIN COUNTY OF LORAIN
STATE OF OHIO

- LEGEND:
- ⊙ = 5/8" REBAR SET WITH I.D. CAP
 - ⊕ = DRILLHOLE SET
 - = PIPE FOUND ● = PIPE USED
 - ▲ = IRON PIN/ REBAR FOUND
 - △ = IRON PIN/ REBAR FOUND AND USED
 - = MONUMENT BOX ☒ = FENCE POST
 - R, REC = RECORD U= USED
 - C, CALC = CALCULATED T.M. = TAX MAP
 - OBS = OBSERVED CL = CENTERLINE
 - P.O.B. = POINT OF BEGINNING
 - P.P.O.B. = PRINCIPLE PLACE OF BEGINNING

PREPARED AT THE REQUEST OF:
LORAIN COUNTY HOMEBUYERS LLC

1/4/2026
JOB No: 2025-12-1
SHEET 1 of 1