


"I, W. W. Wright proprietor of Lots No. 12, and 13, and all the succeeding lots lying west of the line on Forest Street in the Village of Oberlin and described in the within plat do hereby alter and amend this plat widening said Forest Street six feet on each side westward and including said Lots No. 12 and 13.

W. W. Wright Seal

O. B. C. L. S. A.

Sept. 26.
The State of Ohio, Personally appeared W. W. Wright above named Lorain County, ss. and acknowledged the execution of the above alteration and amendment to be his free act and deed this 26th day of September, 1865.
W. P. Harris - Notary Public.

The above was copied from the original Plat (herein recorded) this 6th day of Oct. 1865. W. K. Sackner Recorder by E. E. Bassett deputy.

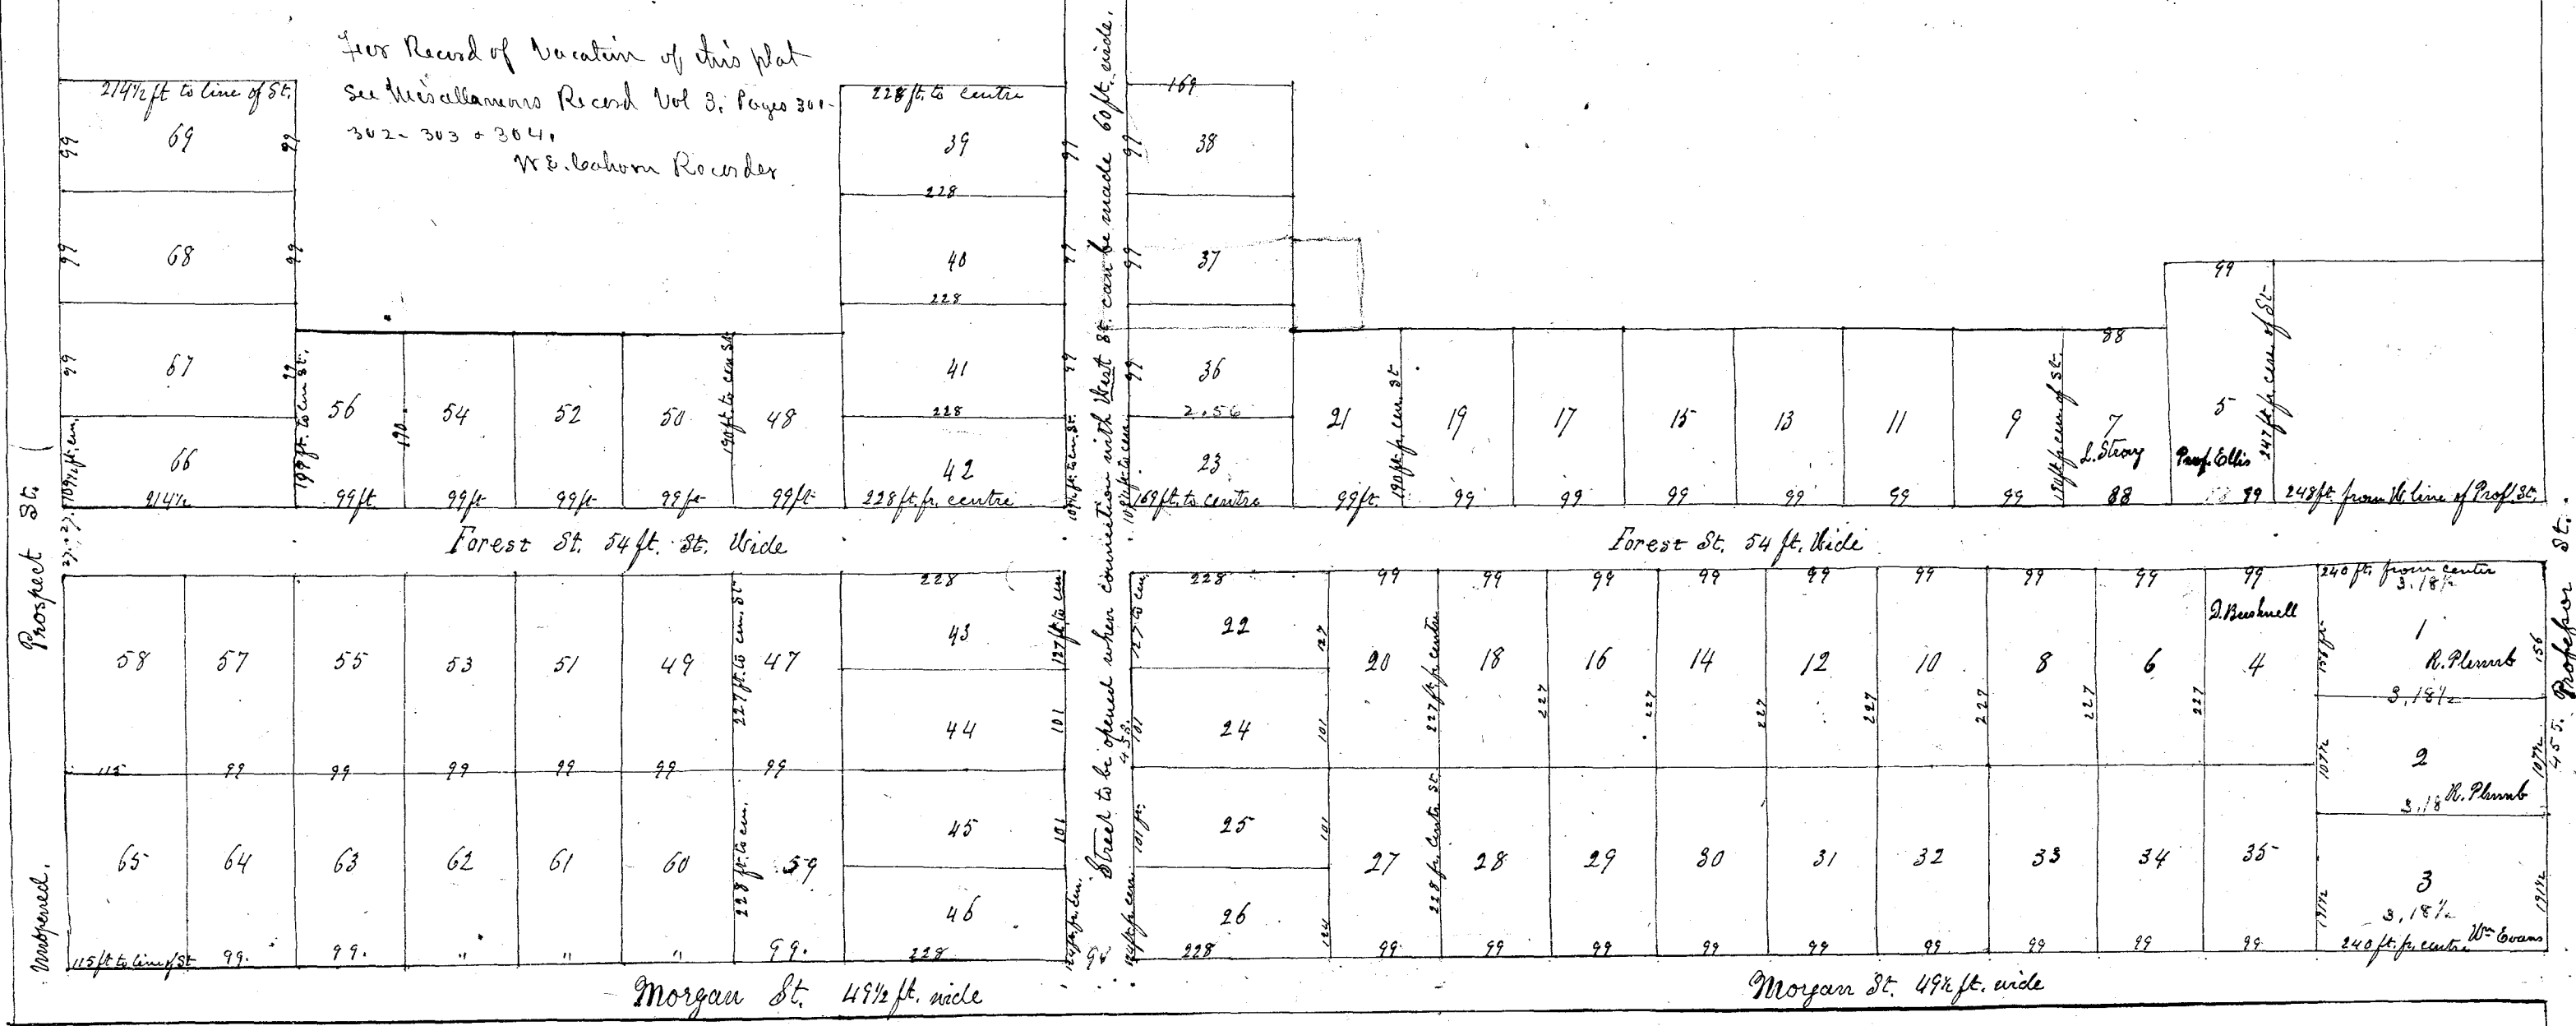


I, W. W. Wright proprietor of the lots of which the subjoined plat is a correct description do hereby certify that I have subdivided and laid out the same for sale, and that the precise width of the streets and also the precise width and length of the lots, and their progressive numbers are as indicated on said plat.

Said plat is bounded on the East by East line of out lot No. one, on the South by South line of out lots Nos. 1, 2, 3 + 4, on the West by West line of out lot No. four, in original lot No. 88.

Before me Daniel Bushnell a Justice of the Peace in and for said County personally came W. W. Wright who did acknowledge that he did sign and seal the foregoing instrument and that the same is his free act and deed. In testimony whereof I hereunto set my hand this 12th day of May, 1865.
Daniel Bushnell J. Peace.

Red. May 18th Recorded May 27th 1865 Henry B. West Recorder

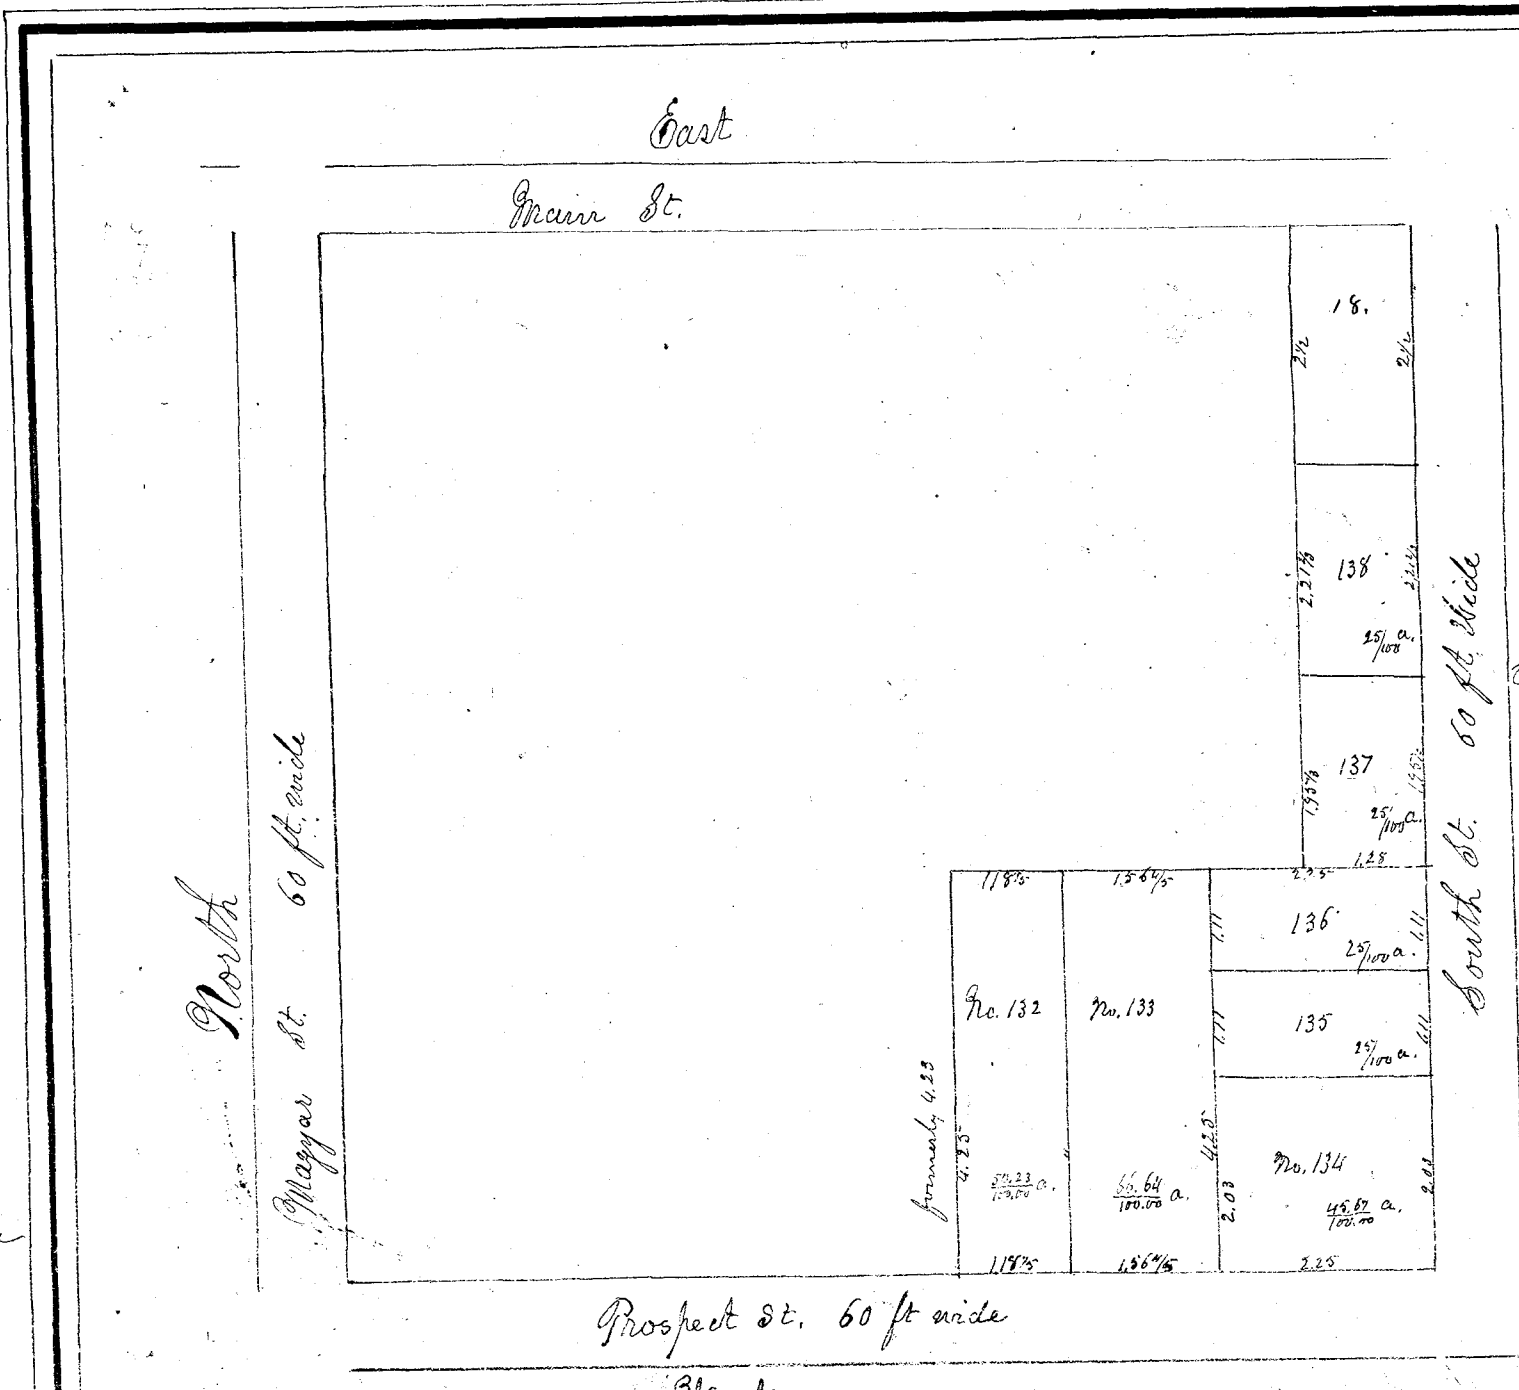

Wellington

State of Ohio } I hereby certify that at the request of Edmund Lambert Lorain Co. ss. I have surveyed lands in the Village of Wellington on original lot No. 89 and 124, and laid off certain lots, said lots numbering from 132 to 138 inclusive, Block No. 1: all distances measured and marked in chains and links.
Joseph Swift Jr. Deft. Lorain Co. Surveyor
Signed and sealed this 30th day of July A. D. 1863
Edmund Lambert

Personally appeared Edmund Lambert signer and sealer of the foregoing plat and survey and acknowledged the signing and sealing thereof to be his free act and deed this 30th day of July A. D. 1863.
Leonard Brown J.P.

I hereby certify the foregoing plat to be correct as described by me for Edmund Lambert. July 1st 1863. Joseph Swift Jr. Deft. Lorain Co. Surveyor
Red. & Recorded Aug. 3rd 1863 Henry B. West Recorder

Amended Dec 1/3 Lot no 135 of Combats Plat to W. H. Hanson