


Geo. A. Barnard's Addition to Wellington.

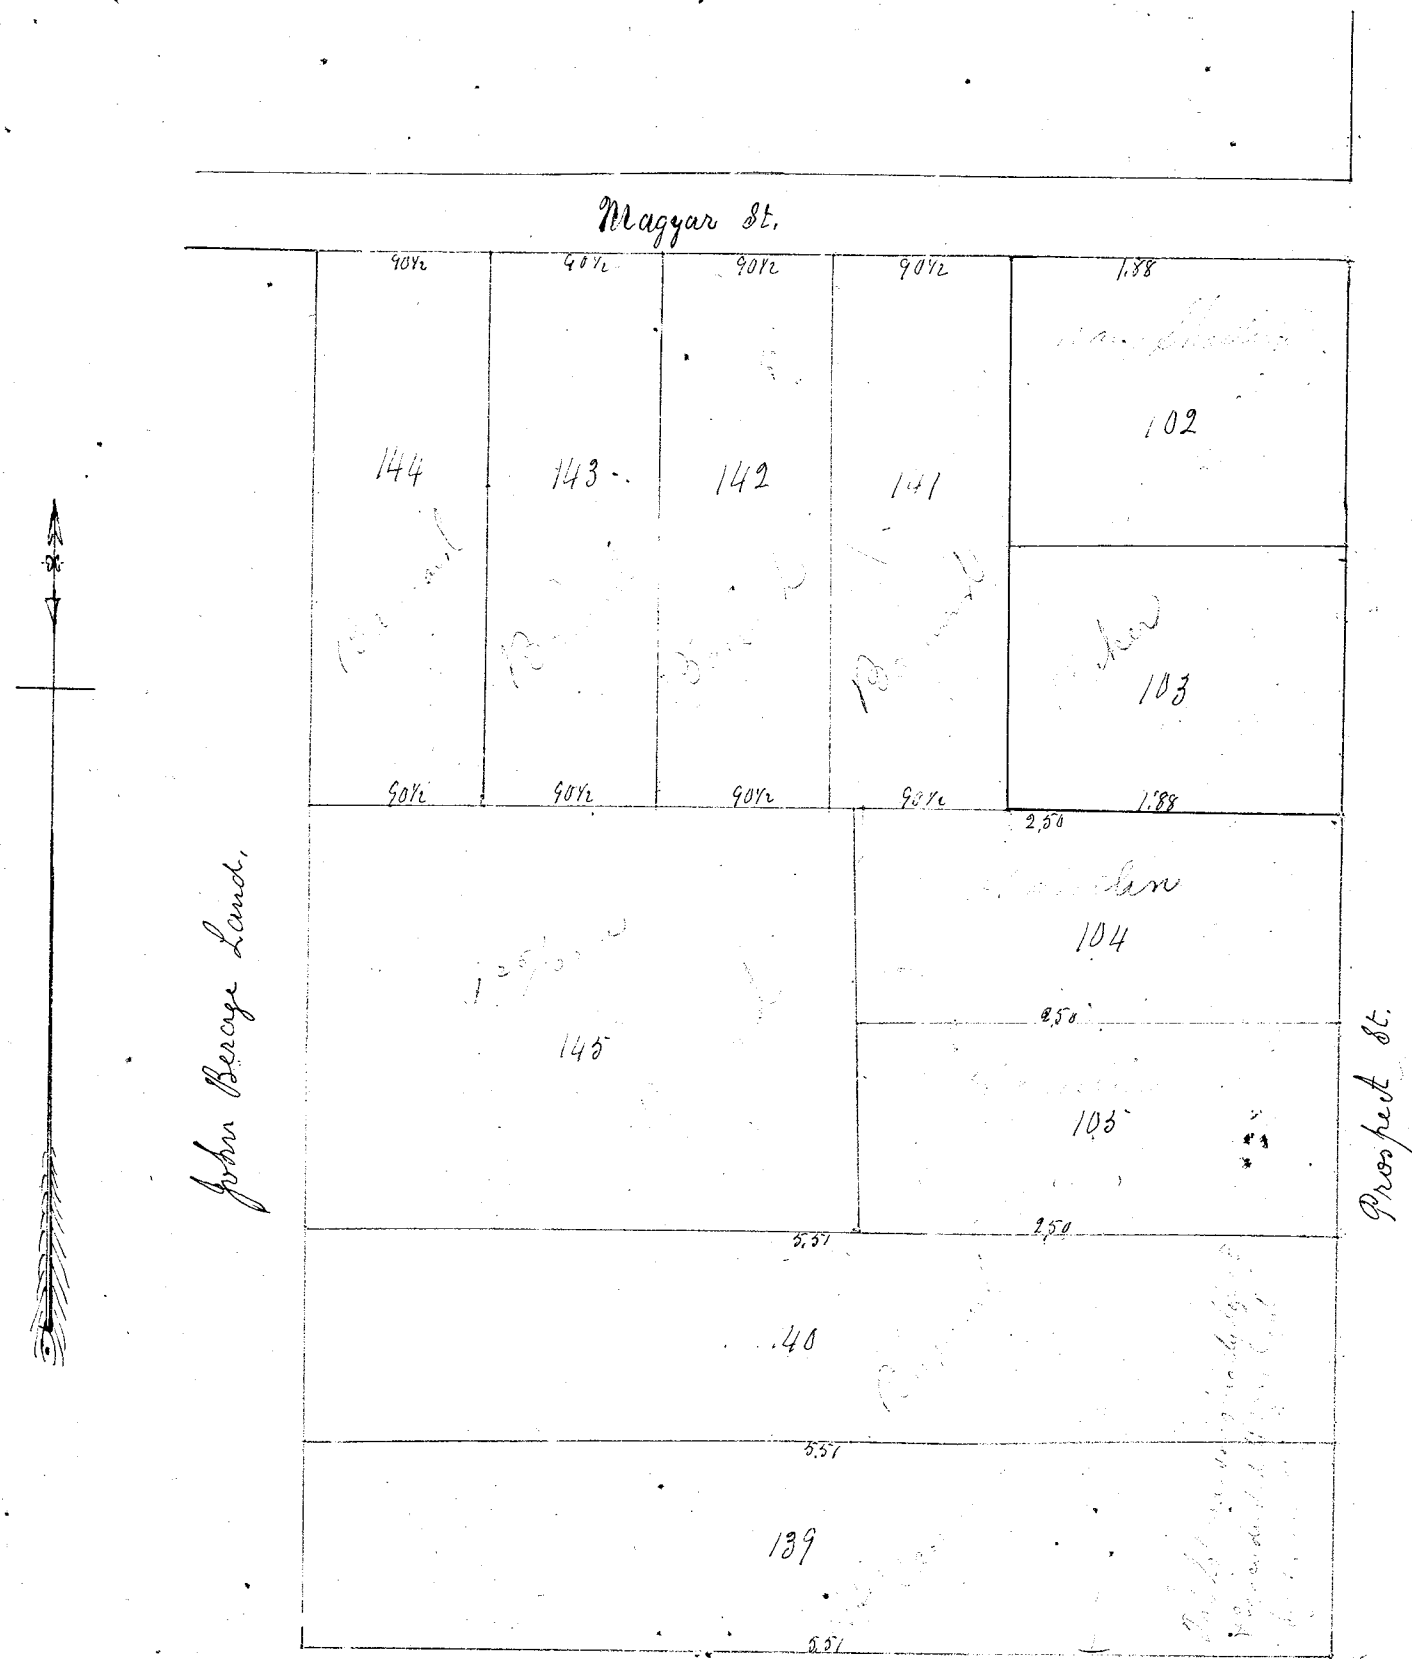


The Addition by Barnard was made by Division of Lot No. 92 and changing the form of lots No. 104 + 105. The measures indicated on plat are in chains and links. Lots Nos. 141, 142, 143 + 144 front on Magyar St. No. 104, 105, 139 + 140 front on Prospect St. No. 145 is an in lot. Addition, and alterations drawn in red ink. Wellington Aug. 28th 1863. L. B. Ward Surveyor.

Signed and sealed this 23rd day of Oct. 1863
Geo. A. Barnard

State of Ohio }
Lorain Co. ss } Personally appeared before me a Justice of the Peace in and for said County, Geo. A. Barnard signer and sealer of the above Plat and survey, and acknowledged the signing and sealing thereof to be his free act and deed this 23rd day of Oct. A.D. 1863
John H. Saxton Justice of the Peace

{ Red. and Recorded Oct. 28th }
1863 H. B. West Recorder

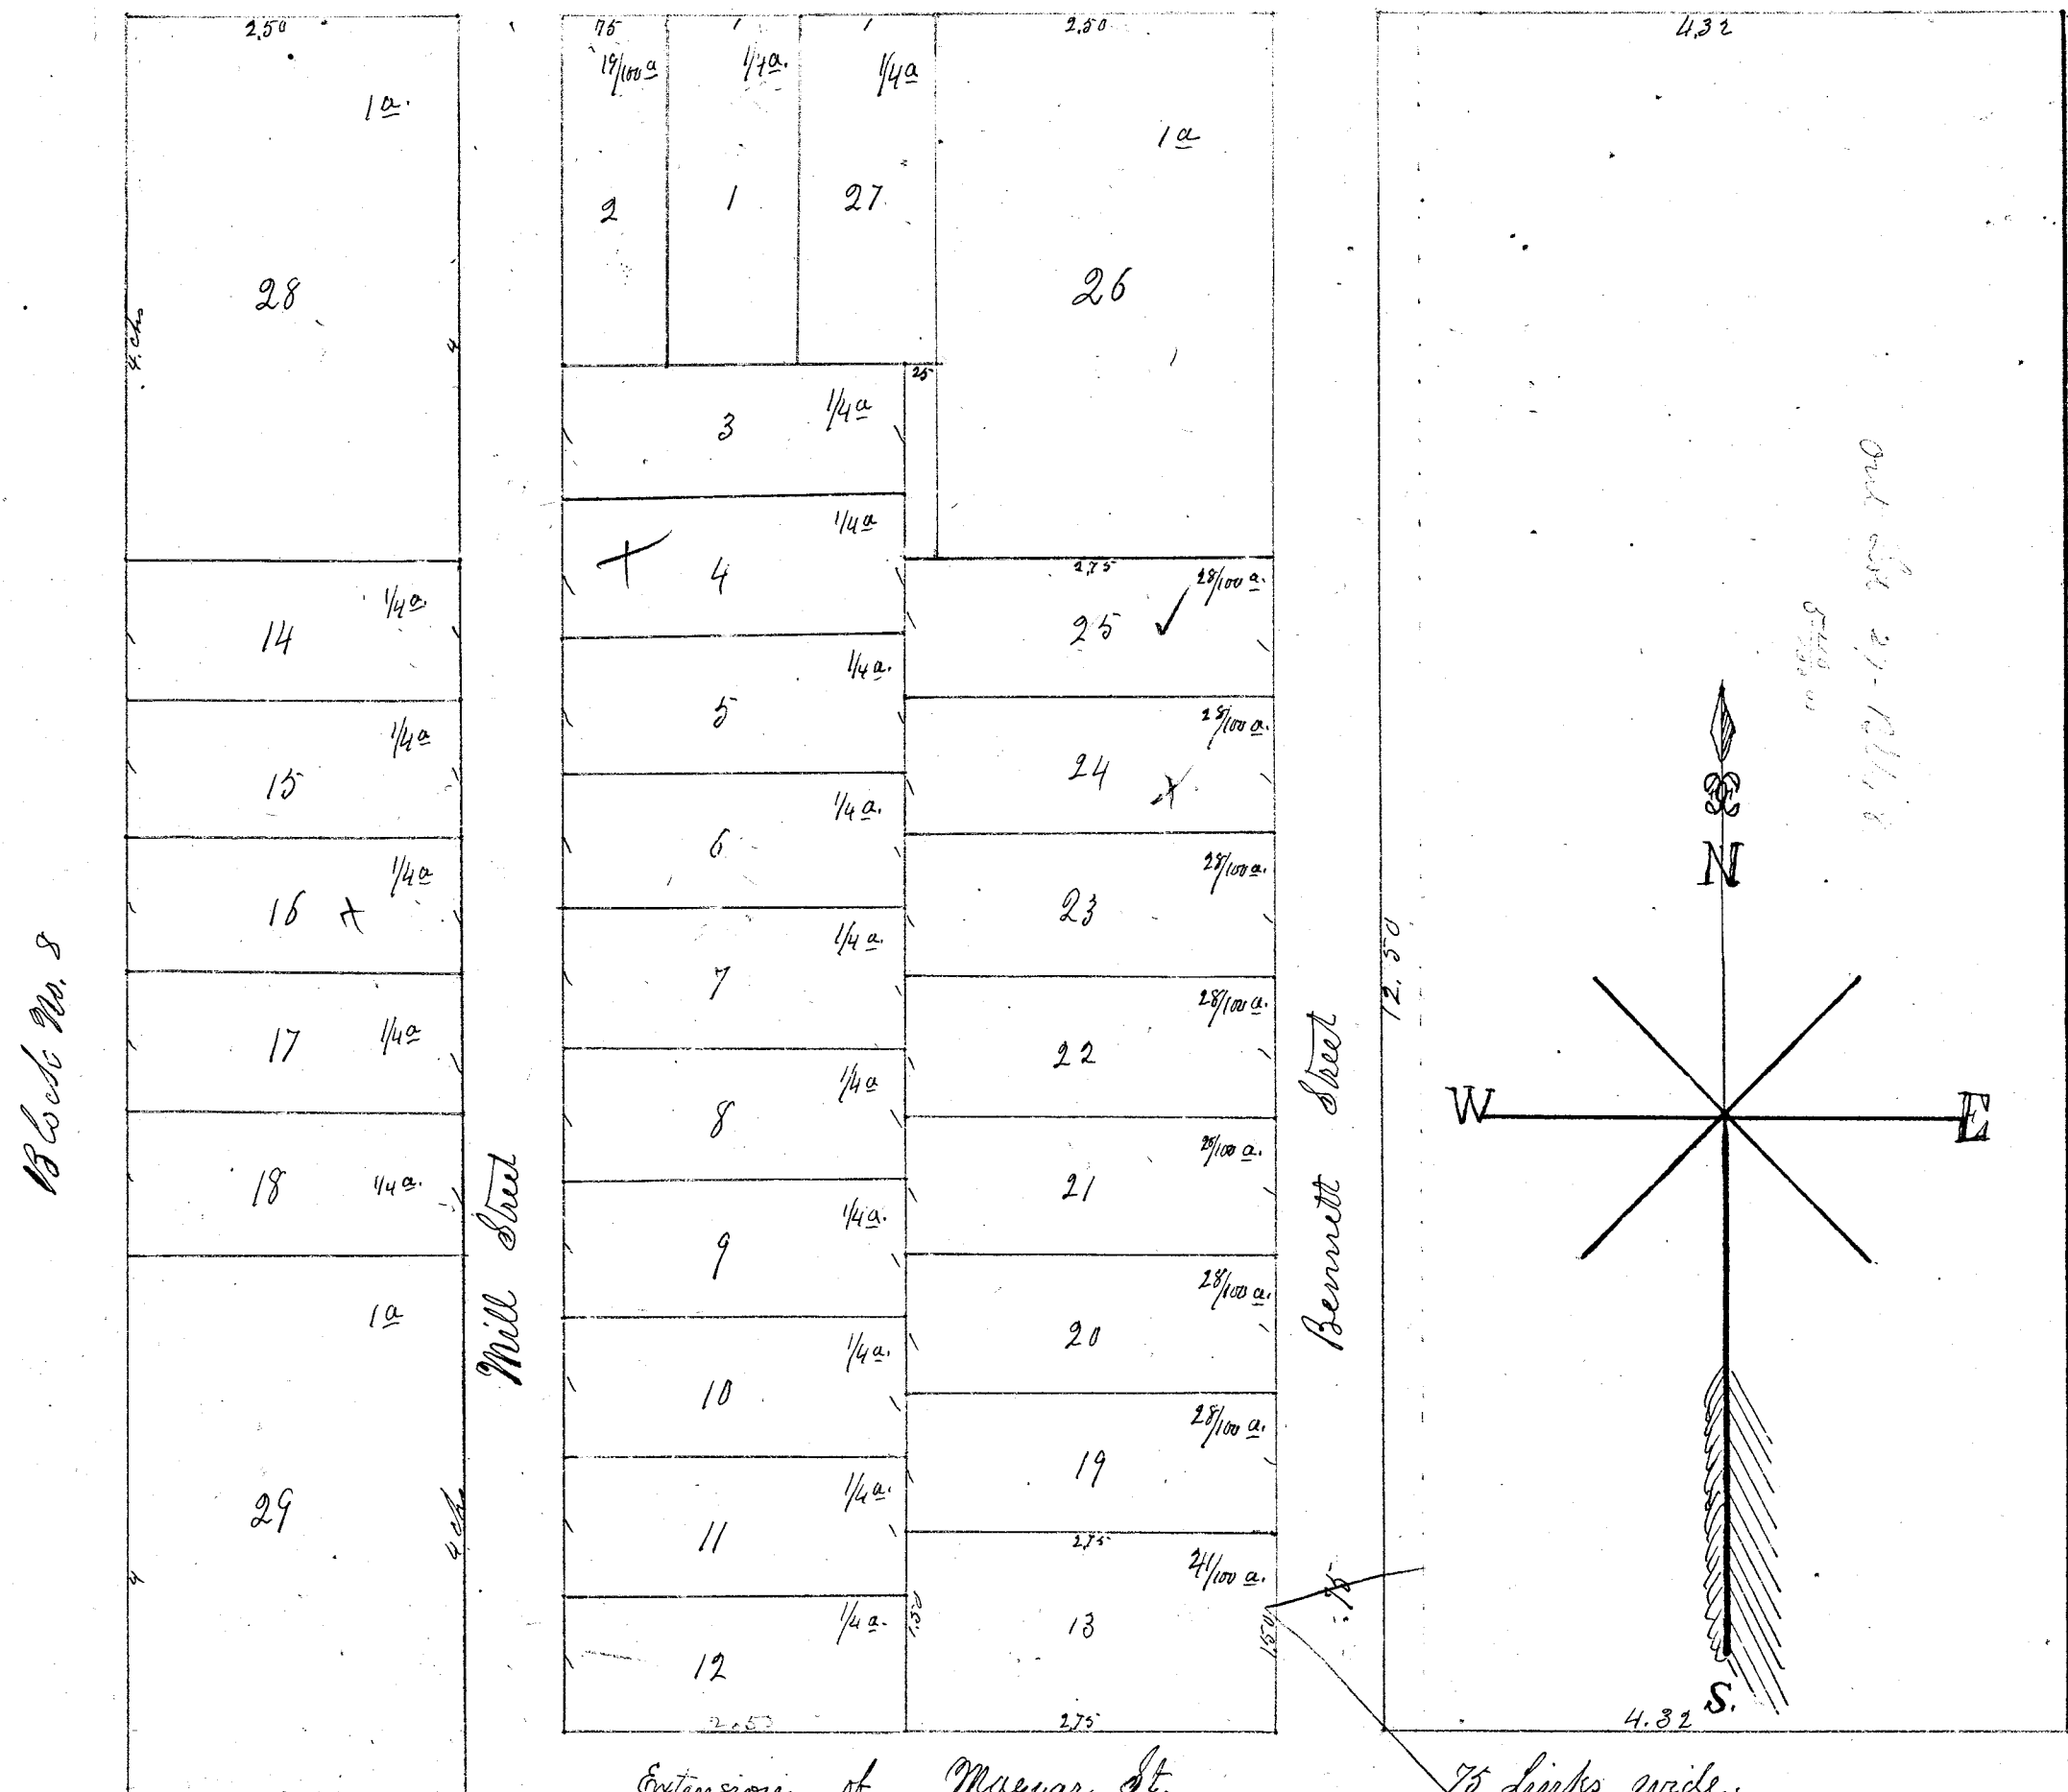

State of Ohio }
Lorain Co. ss } We the undersigned subscribers, owners of the land embraced in this plat, concur in the same as hereby witnessed by our hand, and seals this 29th day of April, A.D. 1864
Signed, sealed and delivered }
in presence of Leonard Brown } Charles O. Bennett
B. C. Lee and A. H. Smith by } Thomas Kirk
Timothy Doland
L. B. Loveland
L. B. Bennett
John Mullin

State of Ohio }
Lorain Co. ss } Before me a Justice of the Peace in and for said County, personally appeared Charles O. Bennett, Thomas Kirk, Timothy Doland, L. B. Loveland, L. B. Bennett and John Mullin and acknowledged that they did sign and seal the foregoing instrument and that the same is their free act and deed.
In testimony whereof I have hereunto set my hand this 8th day of Aug. A.D. 1864
Leonard Brown Just. of the Peace

{ Red. Aug. 18th Recorded Sept. 1st }
1864 H. B. West Recorder

N. line L. C. + C. R. R.

This plat is drawn to a scale of one chain to three fourths of one inch. All distances in chains and links. Divisions of Plat and new sheets marked in red ink.
L. B. Ward Surveyor