VOL 2 Pg 15 (418)

State of Ohio } This may certify that at
Lorain Co. } the request of Thomas Cavan,
I have surveyed and platted an addition to the Town Plat of Black River, Lorain Co. Ohio and located in Lot No. 1 in said Township of Black River and situated on the east side of the River. The Lots and Streets were surveyed as indicated by the plat also stone set as indicated, the stone were set in the Street lines & seven feet (except the westerly one) from the corners of the Lot. they are sand stones and a cross cut in the top. all distances are in feet and entered with black ink. the No's of the Lots and the quantity of the same are entered in red ink. The distances of the side lines on the Lots backing on the Lake Shore run or are taken to low water mark. Plat drawn on a scale of one chain to the inch.

June 10th 1873.

Joseph Swift Jr.
Lorain Co. Surveyor.

Recorded June 25th 1873
Wm. H. Tucker Recorder.

ORDINANCE NO. 640.

To change the name of Myrtle street to Lakeside avenue.

Section 1. Be it ordained by the council of the city of Lorain, Ohio, that the name of Myrtle street extending from Fifth street westerly to a point about six hundred feet west of the west line of Second street in the city of Lorain be and the same is hereby changed to Lakeside avenue.

Section 2. That the necessary entry be made on the city plat in the Recorder's office in Lorain County.

Section 3. This ordinance shall take effect and be in force from and after its passage and legal publication.

Passed this 2nd day of December, 1901

J. J. MAHONY, City Clerk.
FOREST RAUCH, Pres. of council, pro tem.

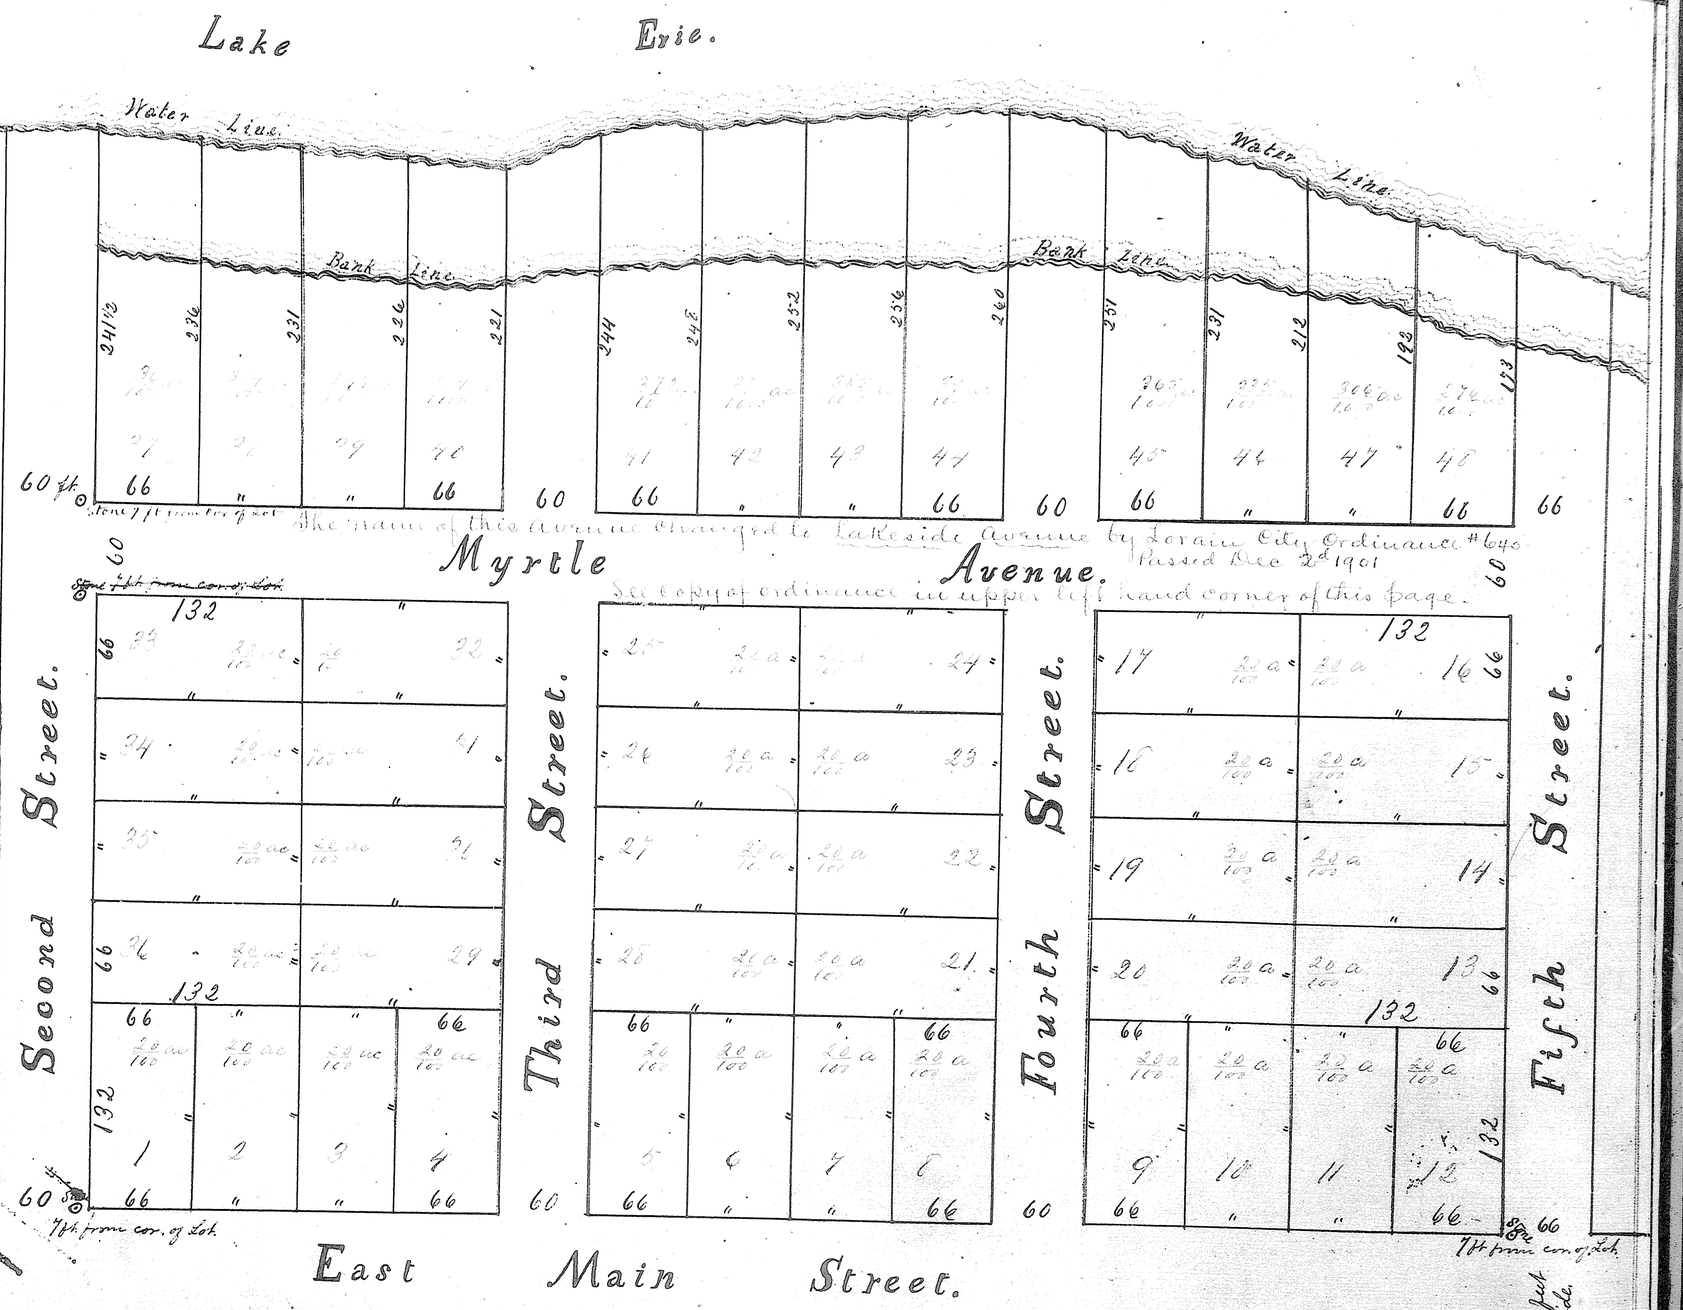

VOL 2 Pg 15 (419)

VOL 2 Pg 15 (419)

State of Ohio } This is to certify that at the request of Frank E. Bronson I have surveyed
Lorain Co. p. } and platted an addition to the Town Plat of Elyria Lorain Co. Ohio
and located in lot No. 85 west of Black River in said Elyria Township. Said
allotment beginning at Lot No. 43. as No. on this plat and running up to Lot No.
66, also subdivided Sub. Lot No. 33 into three subdivisions as indicated by
the plat. I have also thrown on to this plat for the purpose of convenience
a former allotment made by Charles C. Bronson. I also changed on said
C. A. Bronson's allotment (which allotment was made before the L. S. & T. C.
R. R. track was located) Lots Nos 7. 8. 9. 22. 23. 24. 26. & 27 & put the same
face on the east & west R. R. Streets; and the distances are entered in red
ink. All distances are entered except in Streets, in chains & links,
and the quantities in fractional parts of acres. All lots fronting on
Lake Avenue & West Street are measured to the center of the
Street. June 14th. 1873.

Joseph Swift Jr. Lorain Co. Surveyor
C. A. Bronson (Seal)
Frank Bronson (Seal)

Signed and Sealed in
presence of Wm H. Tucker
E. G. Johnson.

The State of Ohio } Personally appeared F. E. Bronson and
Lorain County p. } C. A. Bronson who acknowledged that
they did sign and seal the written plat and that the
same is their free act and deed. Witness my hand
and official seal this 15th day of August 1873.
Wm H. Tucker Notary Public (Seal)
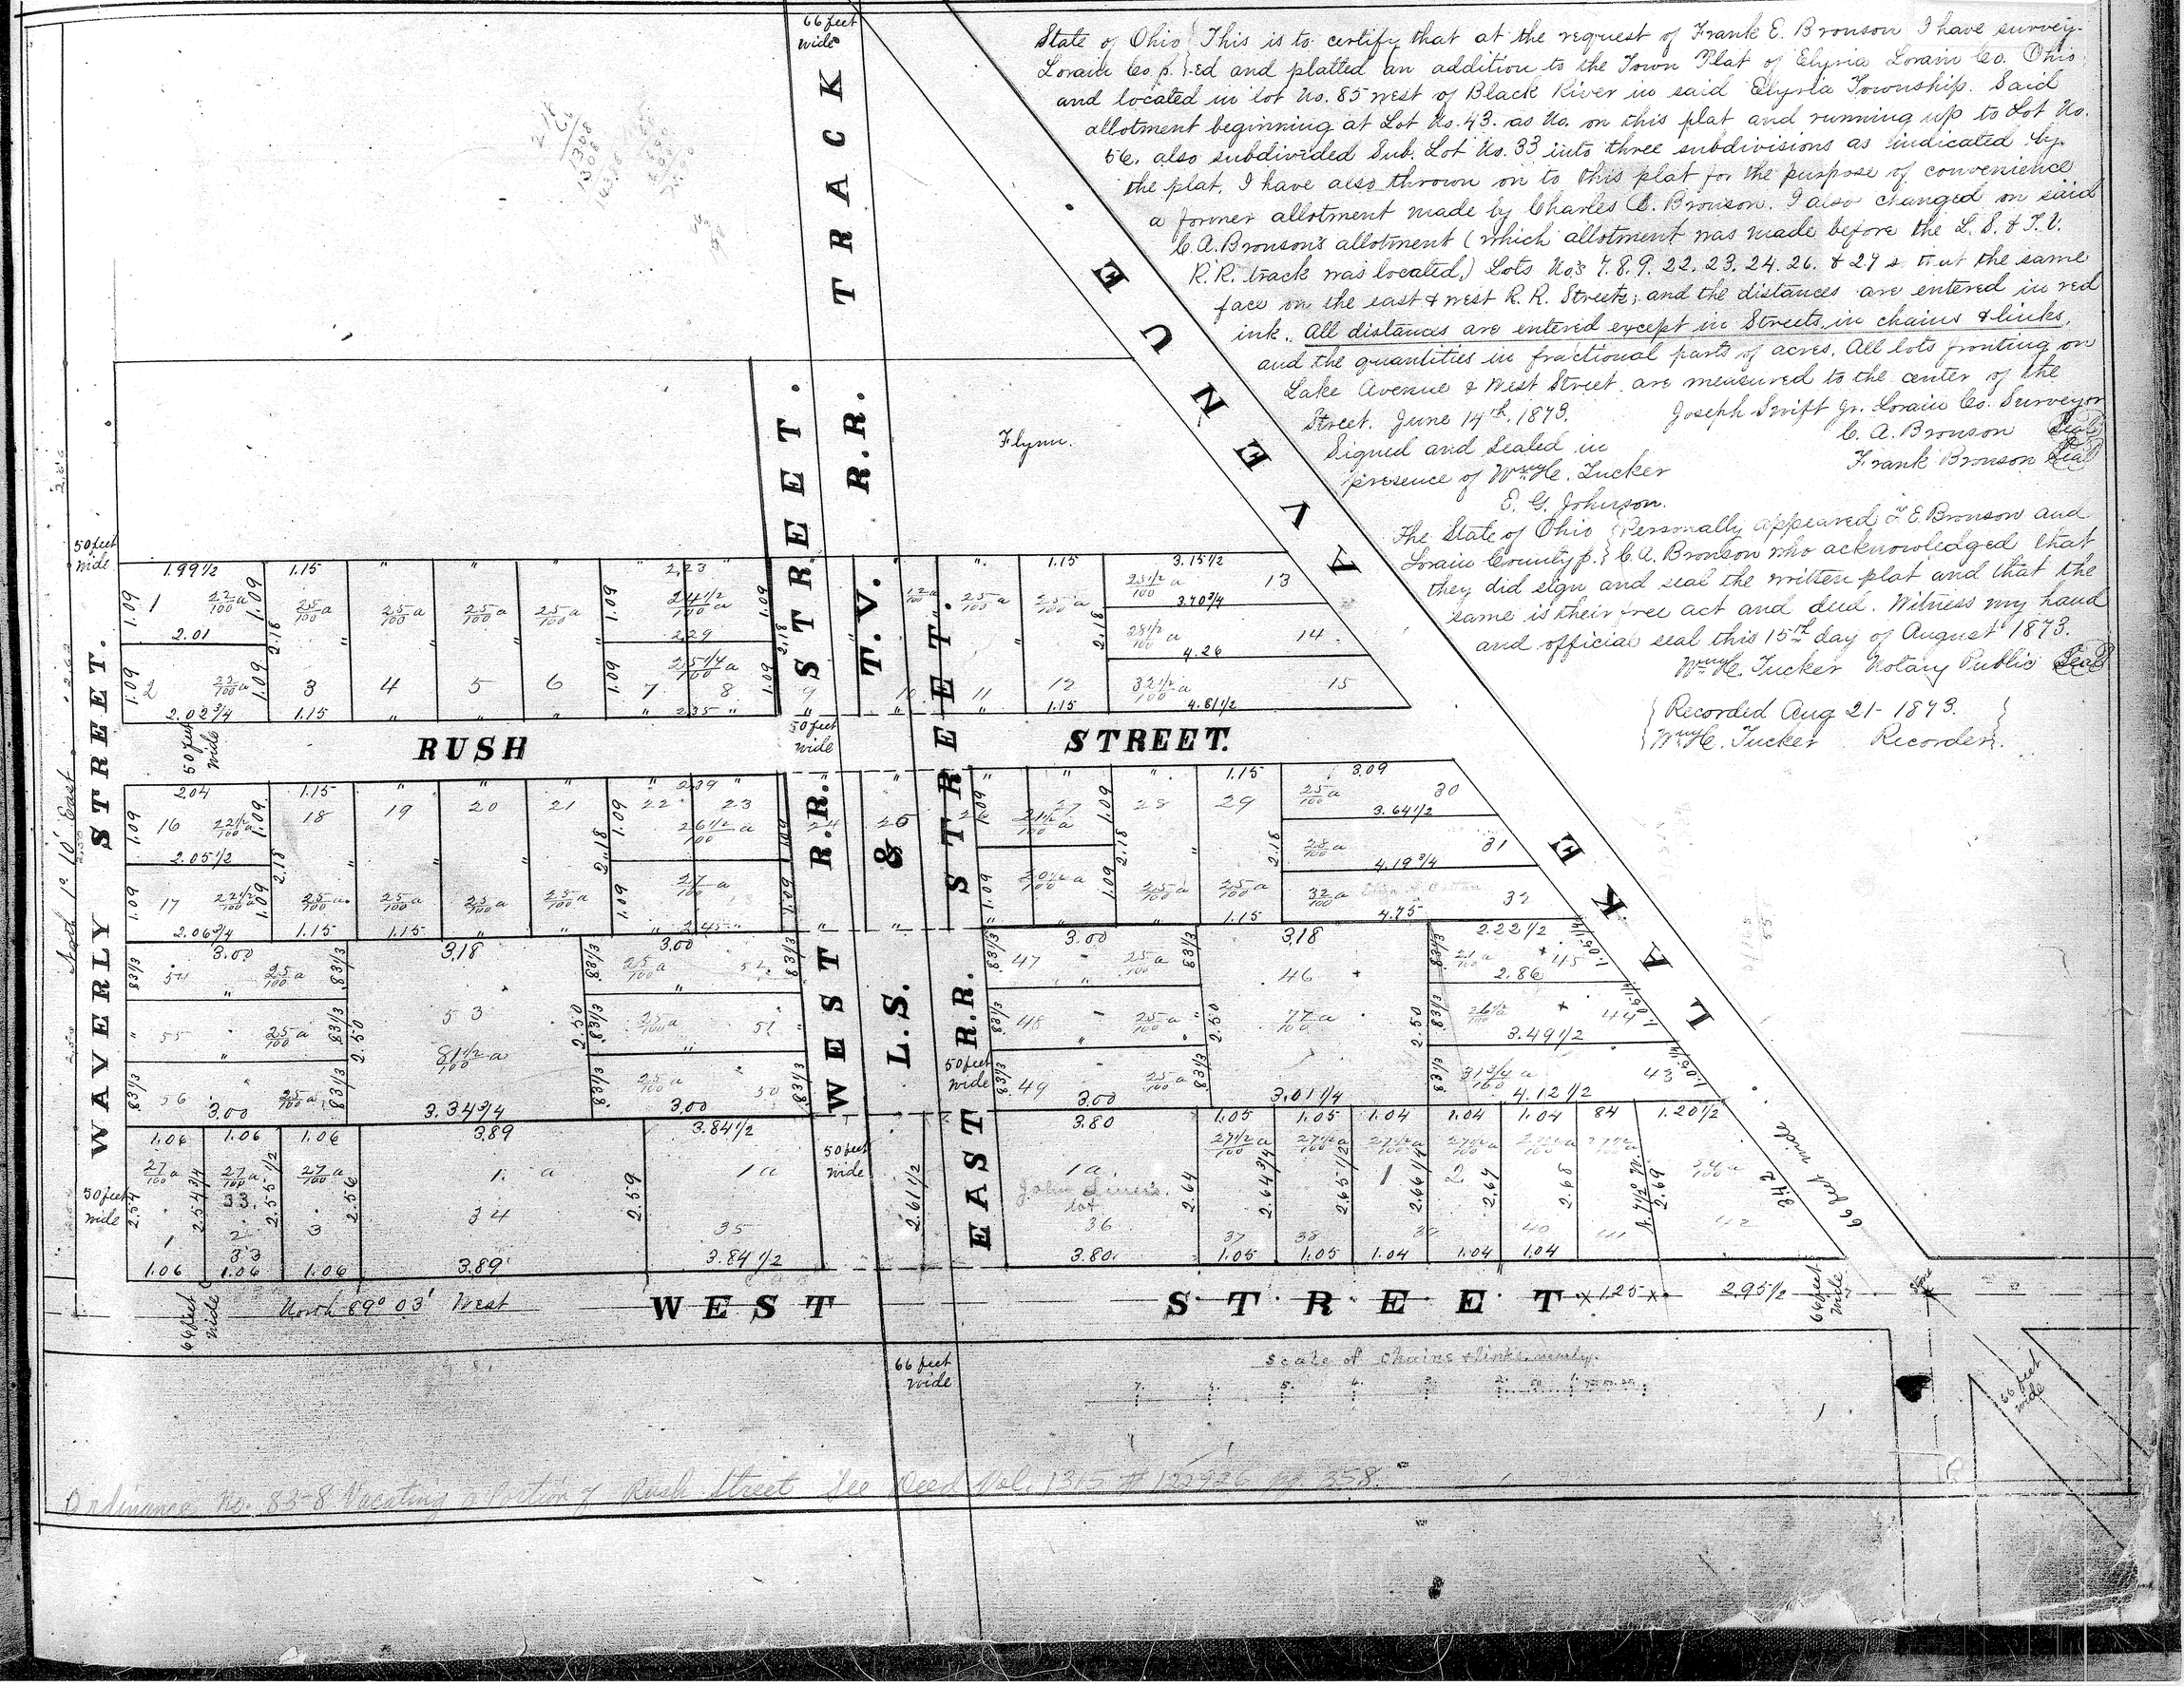
Recorded Aug 21 - 1873.
Wm H. Tucker Recorder.