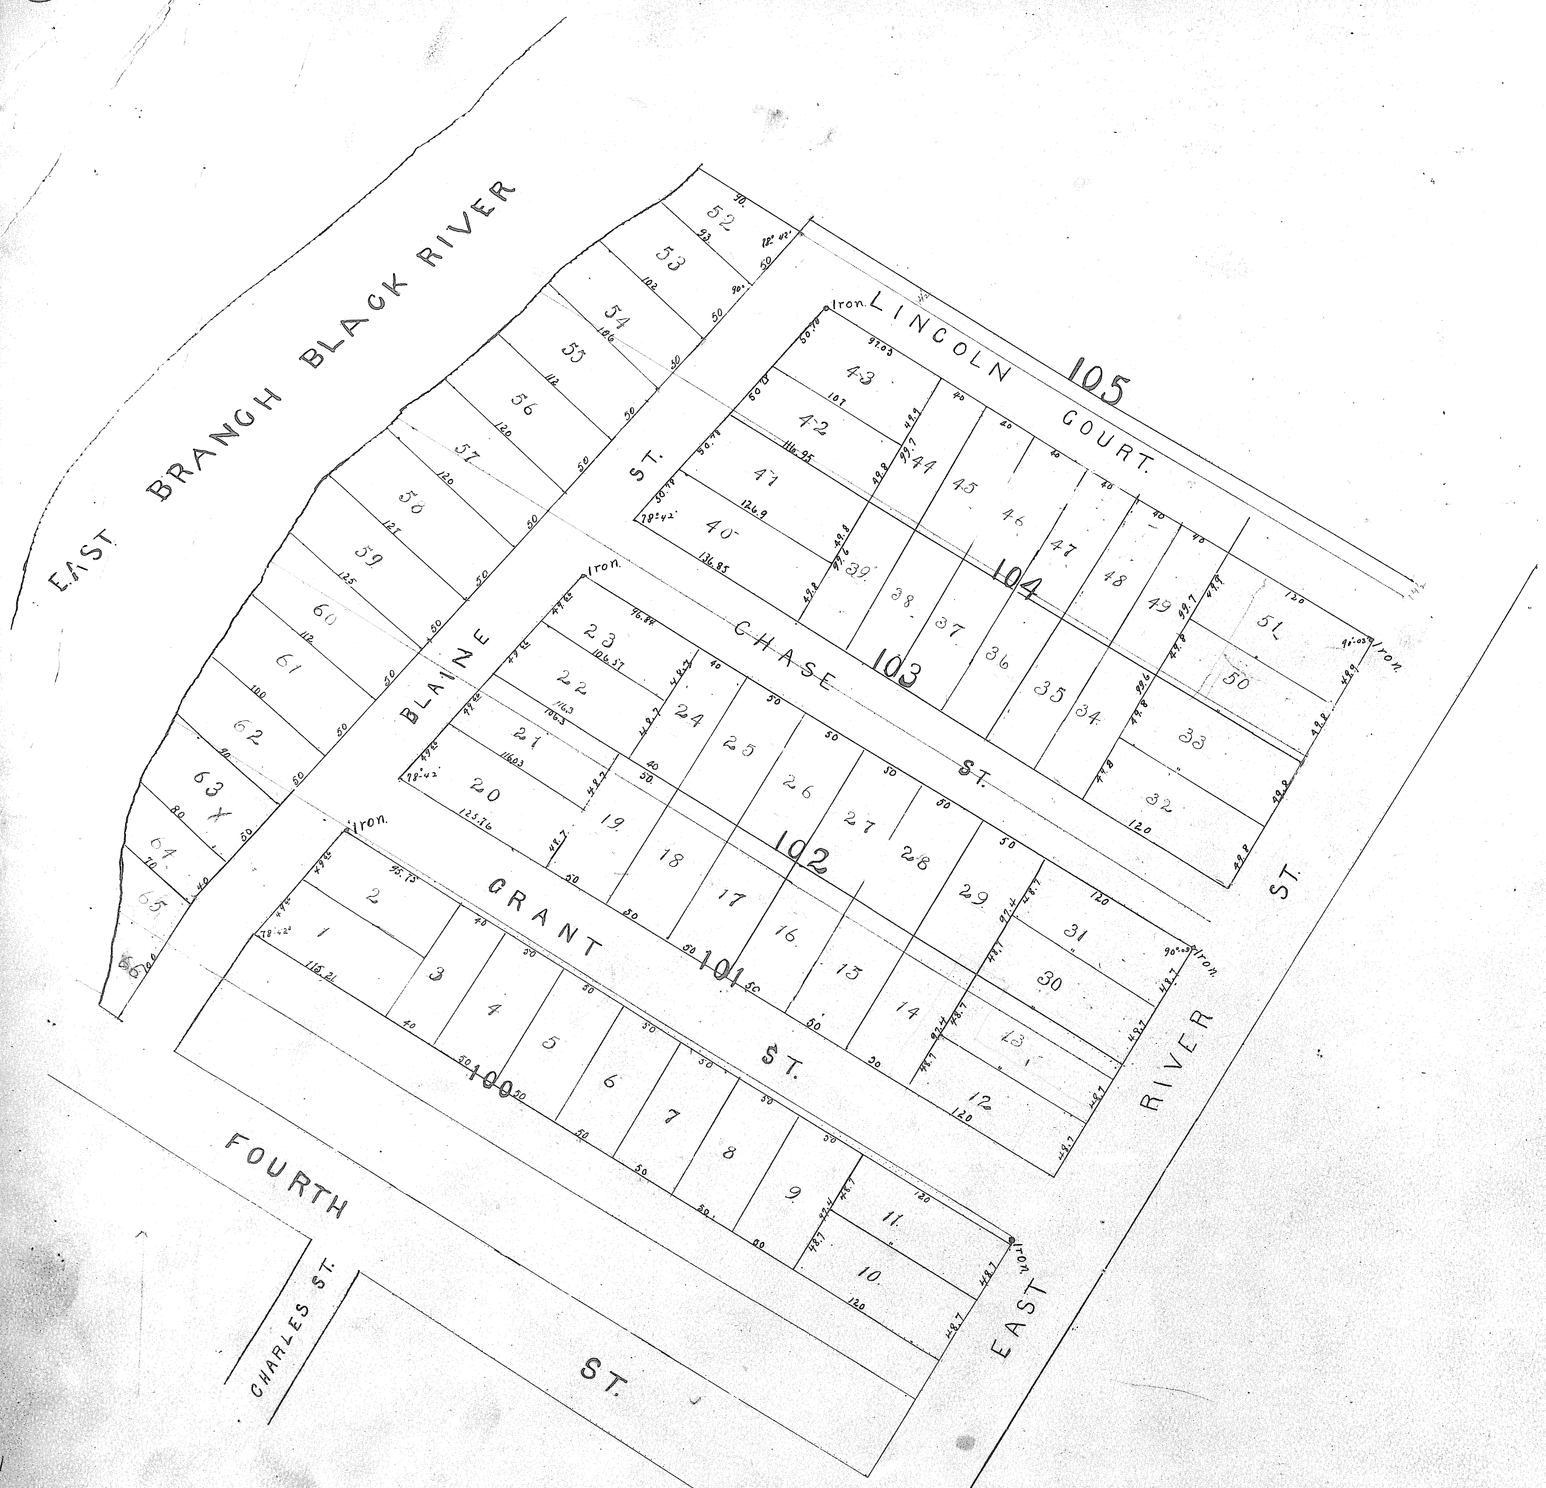

Elyria O. June 13. 1899. I hereby certify that this is a correct plat of a sub-division of original lots numbers 100, 101, 102, 103, 104 and 105 East of Black River made at the request of John C. Crisp Trustee. Clemon H. Snow. Sur.

Elyria O. June 20. 1899 - Resolved by the council of the City of Elyria that the plat of John C. Crisp Trustee of a subdivision of original lots numbers 100, 101, 102, 103, 104 + 105 East of Black River is hereby accepted and the streets shown thereon dedicated to public use. President of City Council Fred Norton Smith. Clerk. N. H. Park.

John C. Crisp Trustee.

Lorain Co. ss- Elyria O. June 1899

Before me a Notary Public in and for said County personally appeared the above named John C. Crisp Trustee who acknowledged that he did sign the plat thereby dedicating the streets thereon shown and that the same is his free act and deed. In testimony whereof I have hereunto set my hand and seal at Elyria Ohio - 20 - day of June A.D. 1899.

C. H. Griswold Notary Public (Seal)

Received for Record June 29. 1899 - at 10.45 A.M.
Recorded July 3rd. 1899 - H. J. Cahoon Recorder.

VOL 5 P 8 (459)

http://www.duplipdf.com
Created by TIFF To PDF trial version, to remove this mark, please purchase the full version.

VOL 5 PG 8 (454)

MAP

Of Blocks 35, 36, 37, 38, 41, 42, 43 & 44 of W. S. Streator Trustee, showing in dotted lines, Streets laid out by Plat recorded in Vol. 2. Page 11. Lorain County Map Records, which are to be vacated. and in solid lines with yellow shade Streets that are to be dedicated in their stead. I certify this Map to be a correct representation of said streets.

Lorain O. March 17. 1899. E. C. Loof Surrow. Surv. & C. E.

Scale 200 ft. 1"

Received July 24th 1899 at 8 o. A.M.
Recorded Aug. 7th 1899.

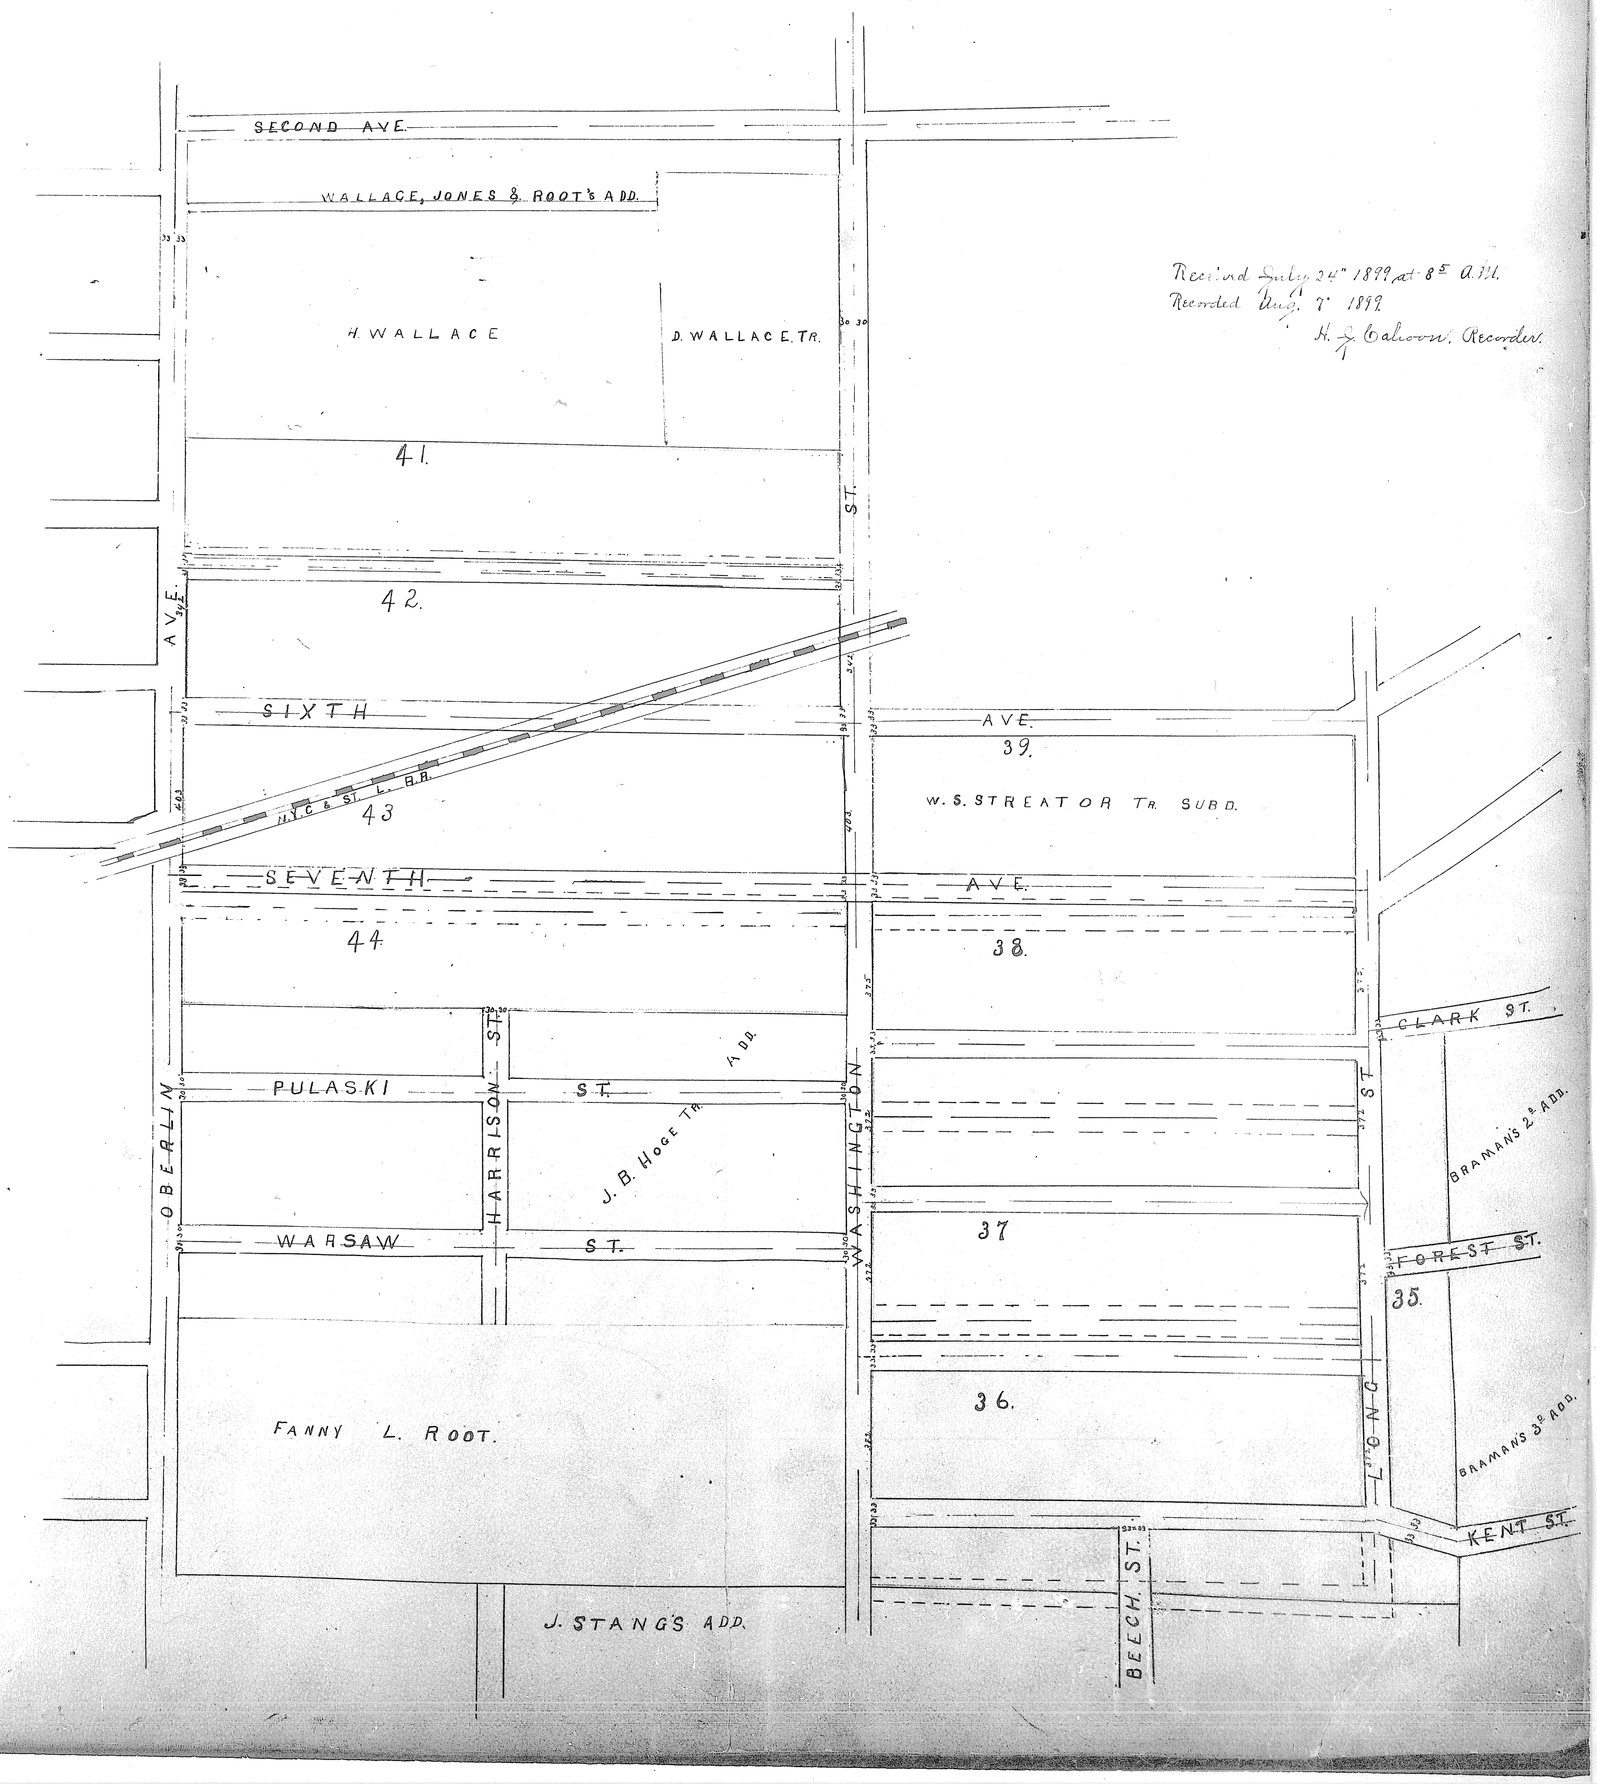

VOL 5 PG 8 (454)

http://www.adlitpdf.com
Created by TIFF To PDF trial version, to remove this mark, please register this software.