http://www.adultpdf.com
Created by TIFF To PDF trial version, to remove this mark, please register this software.

VOL 5 Pg 13 (456)

VOL 5 Pg 13 (456)

For Restriction vacating alley from Helen street to Wilbur Street see Deed Vol. 1233 # 444869 Pg 68

" " " "

For Vacating alley see Deed Vol. 1307 # 114416 Pg 435 Ordinance 100-82

Vol. 5 Pg 13 (436)

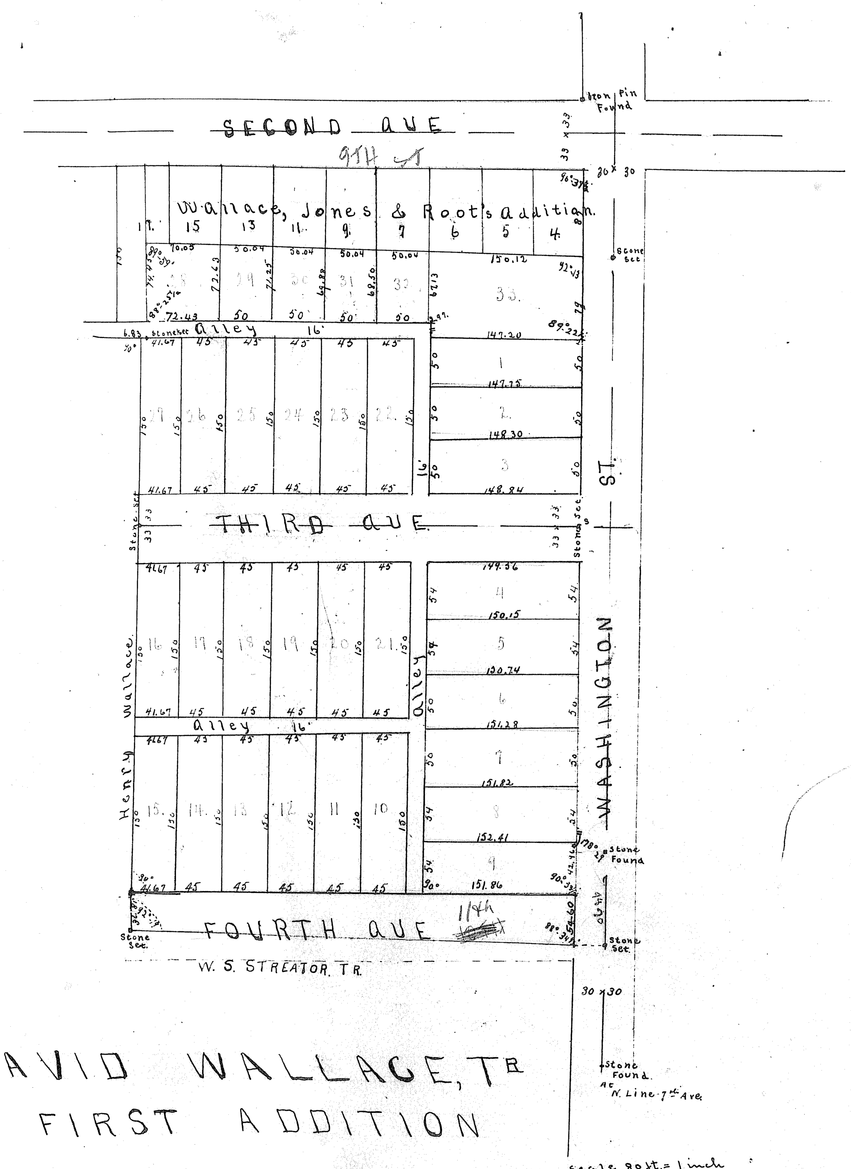

DAVID WALLACE, TR
FIRST ADDITION
To THE CITY OF LORAIN. O.

Scale. 80 ft. = 1 inch

This Addition of 6 5/100 Acres is situated in original lots Nos. 5 and 6, Black River Township, now in the City of Lorain, and is bounded on the North by Wallace, Jones & Roots Addition, On the East by Washington Street; on the south by Land of W. S. Streator Tr.; and on the west by land owned by Henry Wallace. Washington Street is already established. Third Avenue is parallel to Second Avenue and 316 feet distant therefrom, and together with the Alleys is hereby dedicated to public use. Distances are given in feet and decimals thereof. Stone monuments were found or set at all points so indicated on the Plat. All of which I hereby certify to be correct.

E. C. Kuykendall. Surveyor. Lorain O. July 13th 1900.

State of Ohio } Before me a Notary Public in and for said County
Lorain County ss } personally appeared the above named David Wallace Trustee, Lilly Hill, + Theo. F. Daniels who acknowledged that they did sign the foregoing instrument and that the same is their free act and deed. In testimony whereof I hereunto set my hand and affix my official seal this 13 Day of July A. D. 1900. A. V. Hagman Notary Public (Seal)

We the undersigned Trustee and part owners of the land embraced in the above addition hereby adopt this Plat of the same and dedicate to public use Third Avenue and Alleys as shown.

David Wallace Jr.
Lilly Hill.
Theo. F. Daniels.

State of Ohio } I, J. J. Mahony, Clerk of the City of Lorain Ohio hereby certify that the
Lorain County ss } within plat was accepted and confirmed by the Council of said City, by
Ordinance No. 550. passed July 16. 1900. J. J. Mahony. City Clerk.

Received Aug. 2nd. 1900. At 3. P.M. - Recorded Aug. 10th 1900 H. J. Cahoon Recorder

VOL 5 Pg 13 (436)

http://www.oldtipdf.com
Created by TIFF To PDF trial version, to remove this mark, please register this software.