ALTERED PLAT OF

THE LORAIN STONE COMPANY'S

2ND SUBDIVISION OF

A PART OF LOT No 3 TRACT No 1 BLACK RIVER TWP.

LORAIN CO., OHIO.

THE LORAIN REALTY CO. INC. AND OTHERS.

T. L. Gibson. SURVEYOR.

Scale 1" = 200'

EXHIBIT "B"

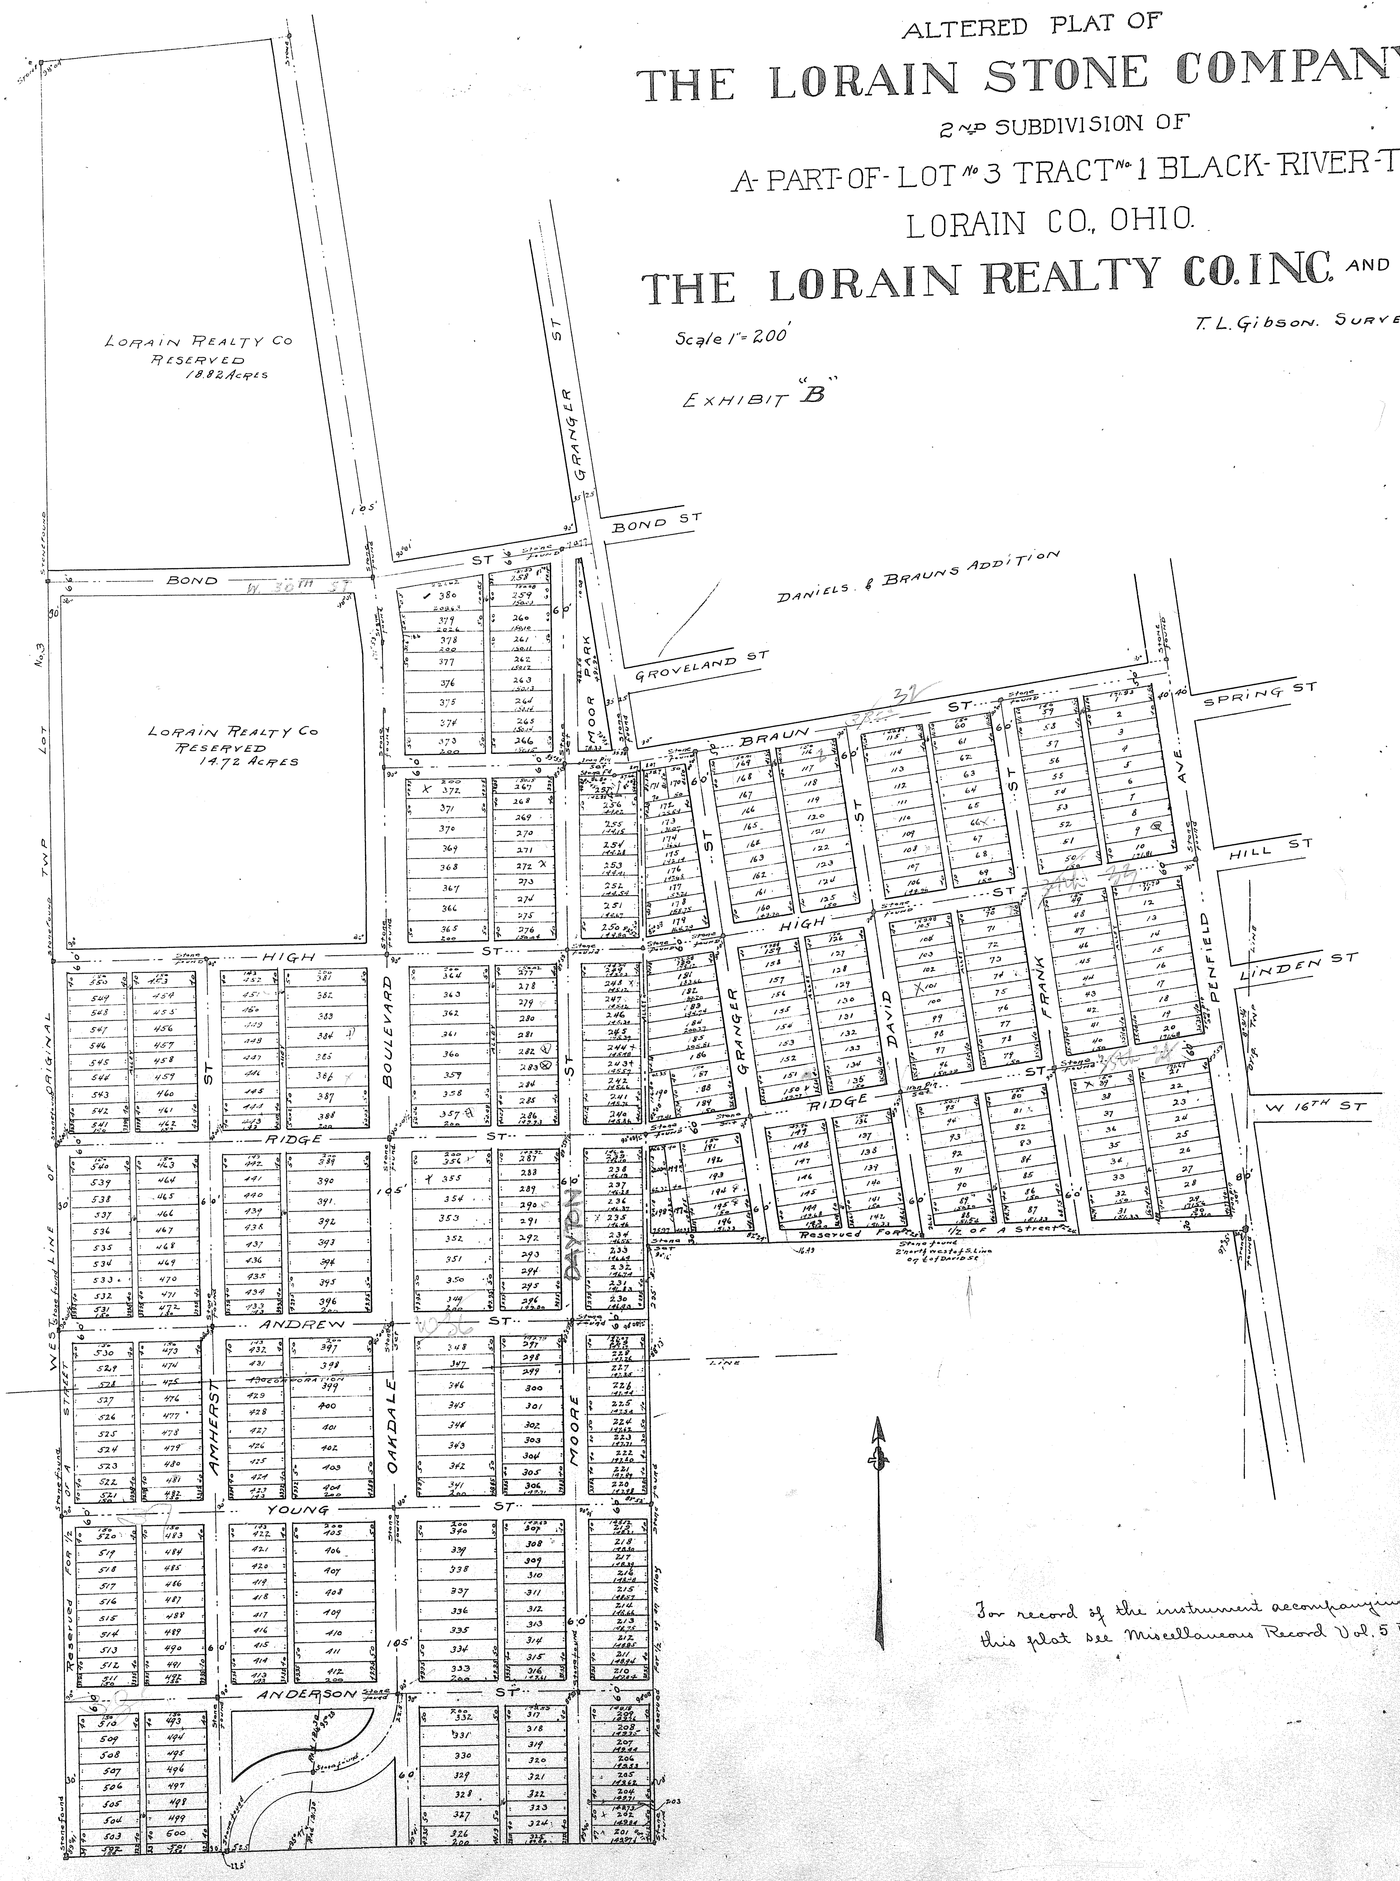

For record of the instrument accompanying this plat see Miscellaneous Record Vol. 5 Page 389.