http://www.adultpdf.com
Created by TIFF To PDF trial version, to remove this mark, please register this software.

VOL 7 B34 (488)

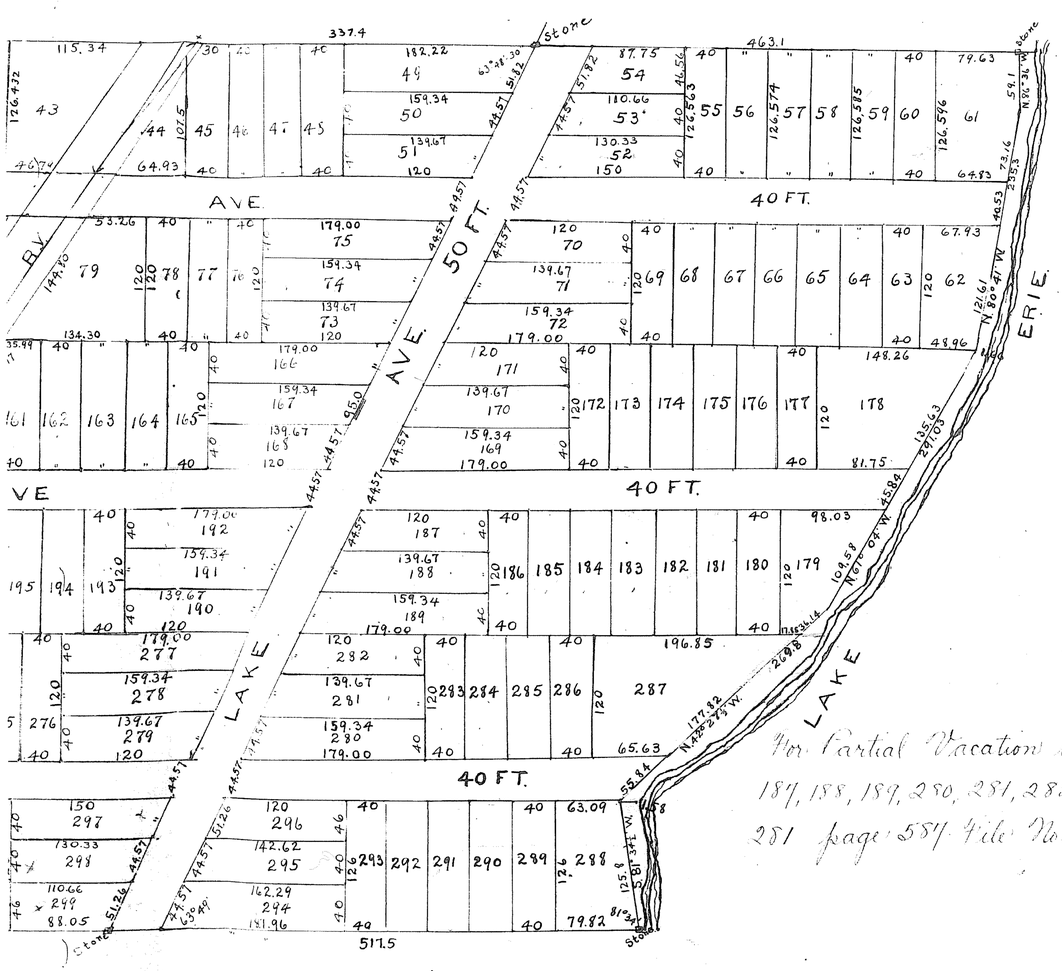

For Partial Vacation of this Plat as to Lots #62, 63, 64, 65, 66, 67, 68, 69, 70, 71, 72, 169, 170, 171, 172, 173, 174, 175, 176, 177, 178 see Deed Vol. 534 Page 302. "File No. 430004.

For Partial Vacation of this Plat as to Lots Nos. 183, 184, 185, 186, 187, 188, 189, 280, 281, 282, 283, 284, 285, 286 and 287 See Deed Vol. 281 page 557 File No 248935.

For Vacation of Cove Ave from Lake Rd. north to Lake Erie see Journal Entry-Deed Vol. 734 Pg. # 548203

VOL 7 B34 (488)