http://www.adultpdf.com
Created by TIFF To PDF trial version, to remove this mark, please register this software.

No 43965:-

PLAT of PART of LOTS No 73 & 75 WEST of BLACK RIVER, ELYRIA, OHIO.

Surveyed July 1st. 1908.

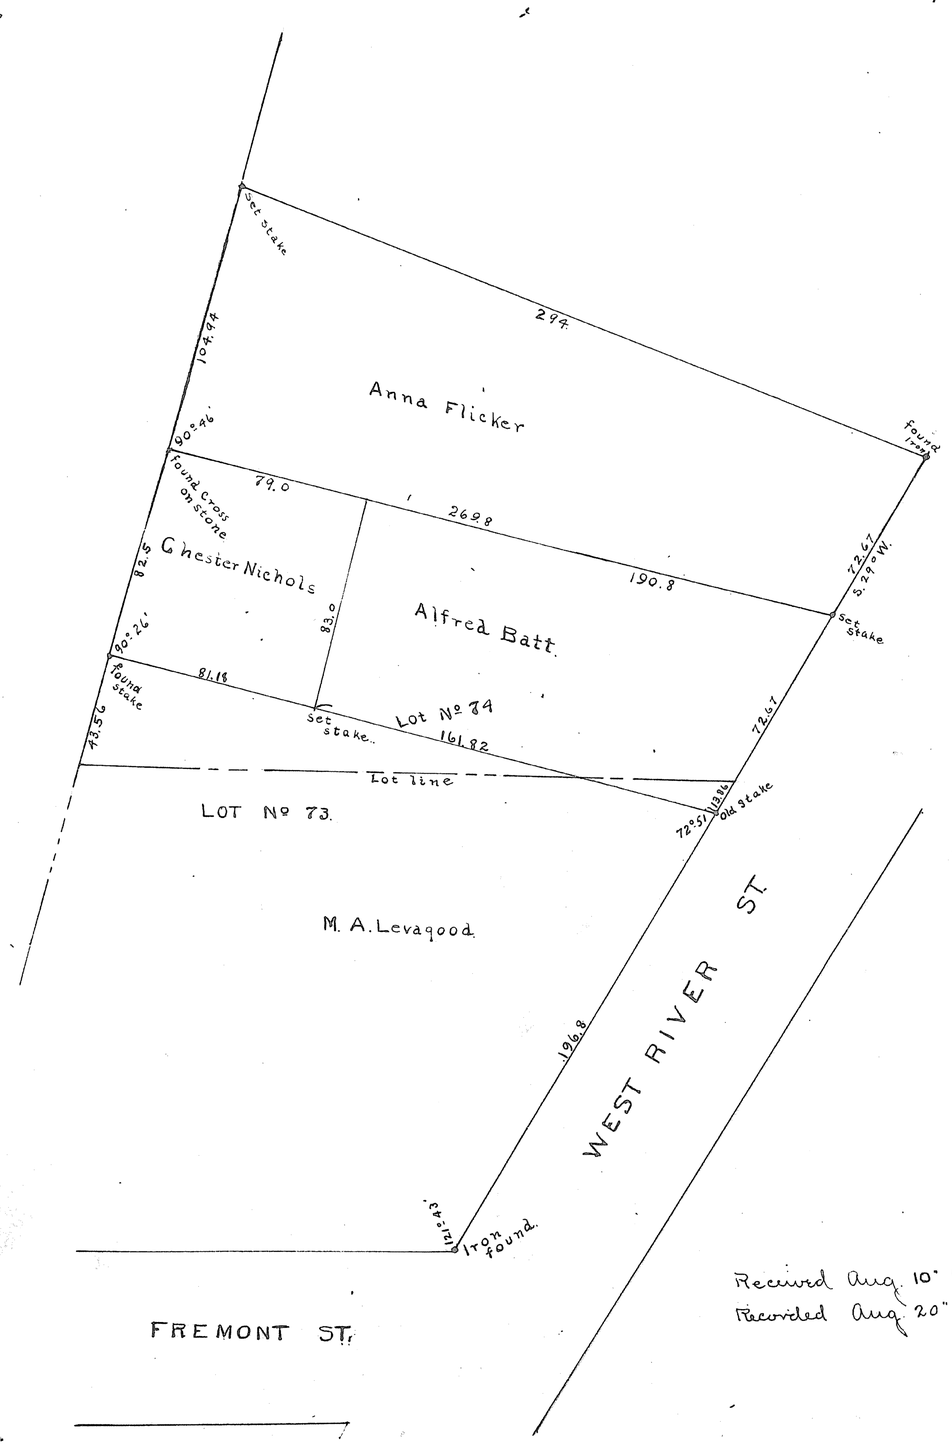

I, hereby certify that this is a correct plat of lots and lands shown hereon that the lines of said lots and lands are located substantially in accordance with the deeds thereof, that stakes are placed where shown and that the scale of this plat is 40 ft. to the inch.

Elyria, O. Aug. 9th 1908. C. H. Snow, Eng.

Received Aug. 10th 1908 At 3 00 P.M.
Recorded Aug. 20th 1908 Chas. E. Tucker, Recorder.