http://www.adultpdf.com
Created by TIFF To PDF trial version, to remove this mark, please register this software.

VOL 7 Pg 56 (494)

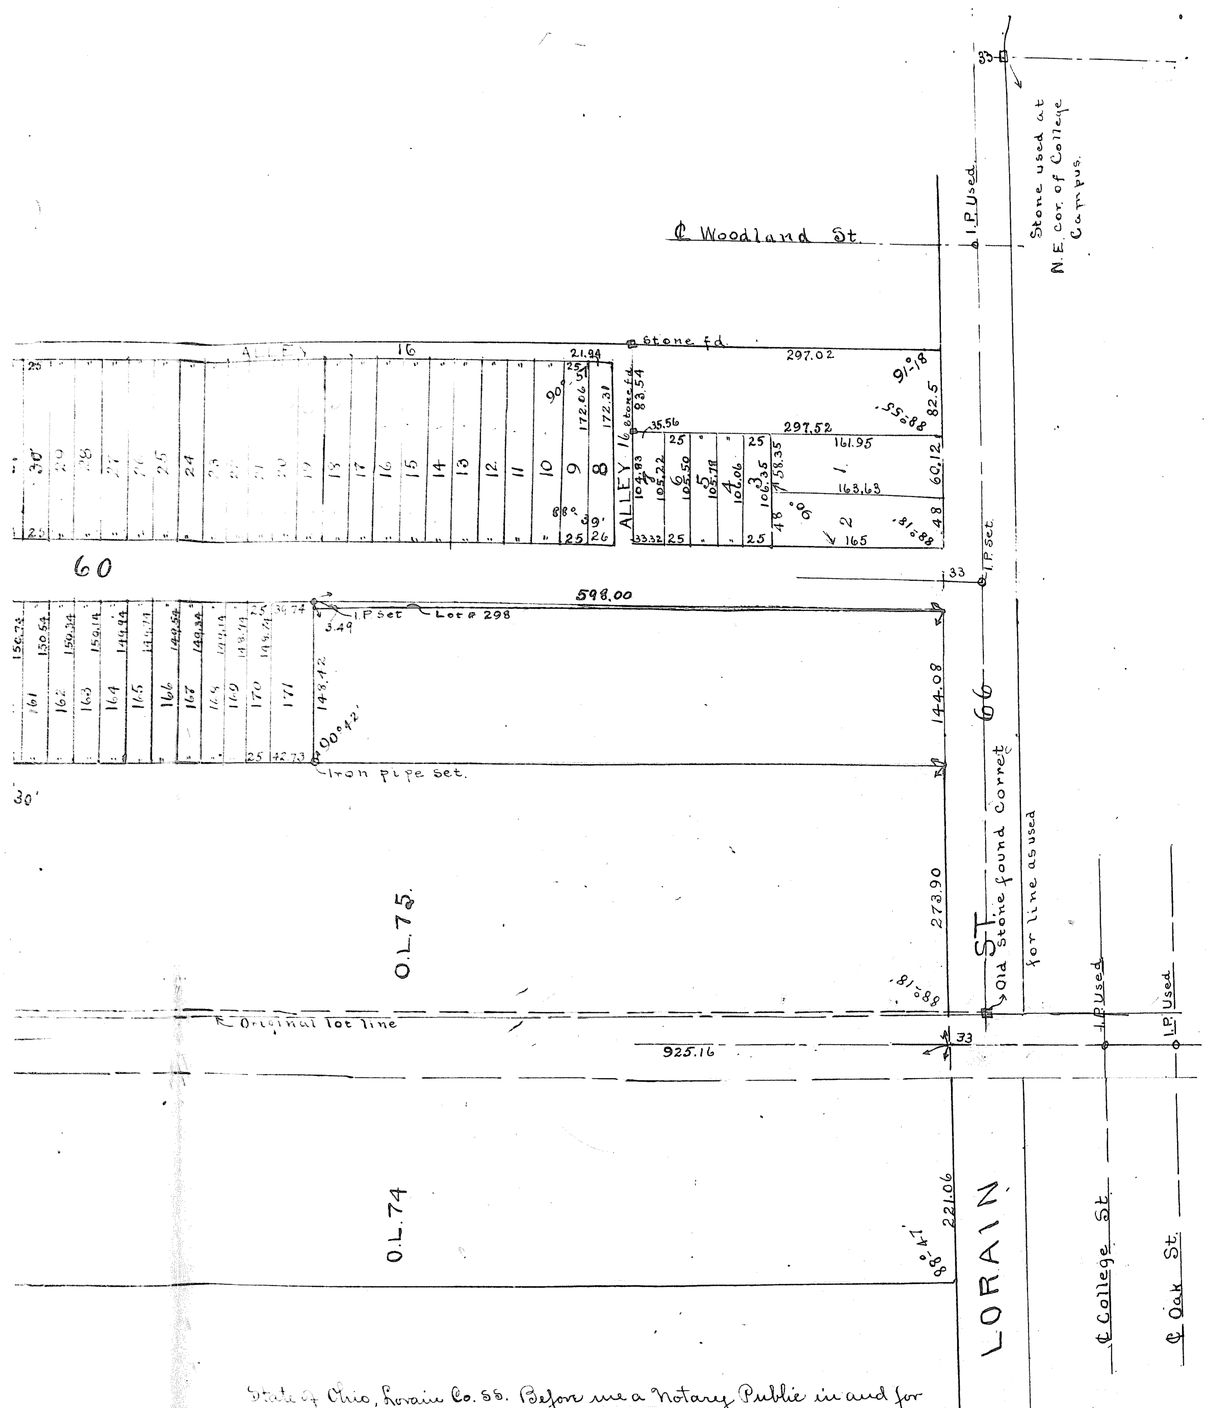

State of Ohio, Lorain Co. ss. Before me a Notary Public in and for said County personally appeared the undersigned who acknowledged that they did sign the foregoing instrument and that the same was their free act and deed. In testimony whereof I have hereunto set my hand and affixed my official seal this 5th day of January A. D. 1909.

Charles R. Summers
Notary Public (Seal)

Received Feb. 8th 1909 At 4:30 P.M.
Recorded Feb 25 1909 Chas E Tucker Recorder.

VOL 7 Pg. 56 (494)