http://www.adultpdf.com
Created by TIFF To PDF trial version, to remove this mark, please register this software.

Vol 7 Pg 59 (495)

59

№ 46355.

SURVEY
FOR
L. and E. TURNER
Lot 47 Pittsfield Twp.
Scale-1" 200' Feb 1909

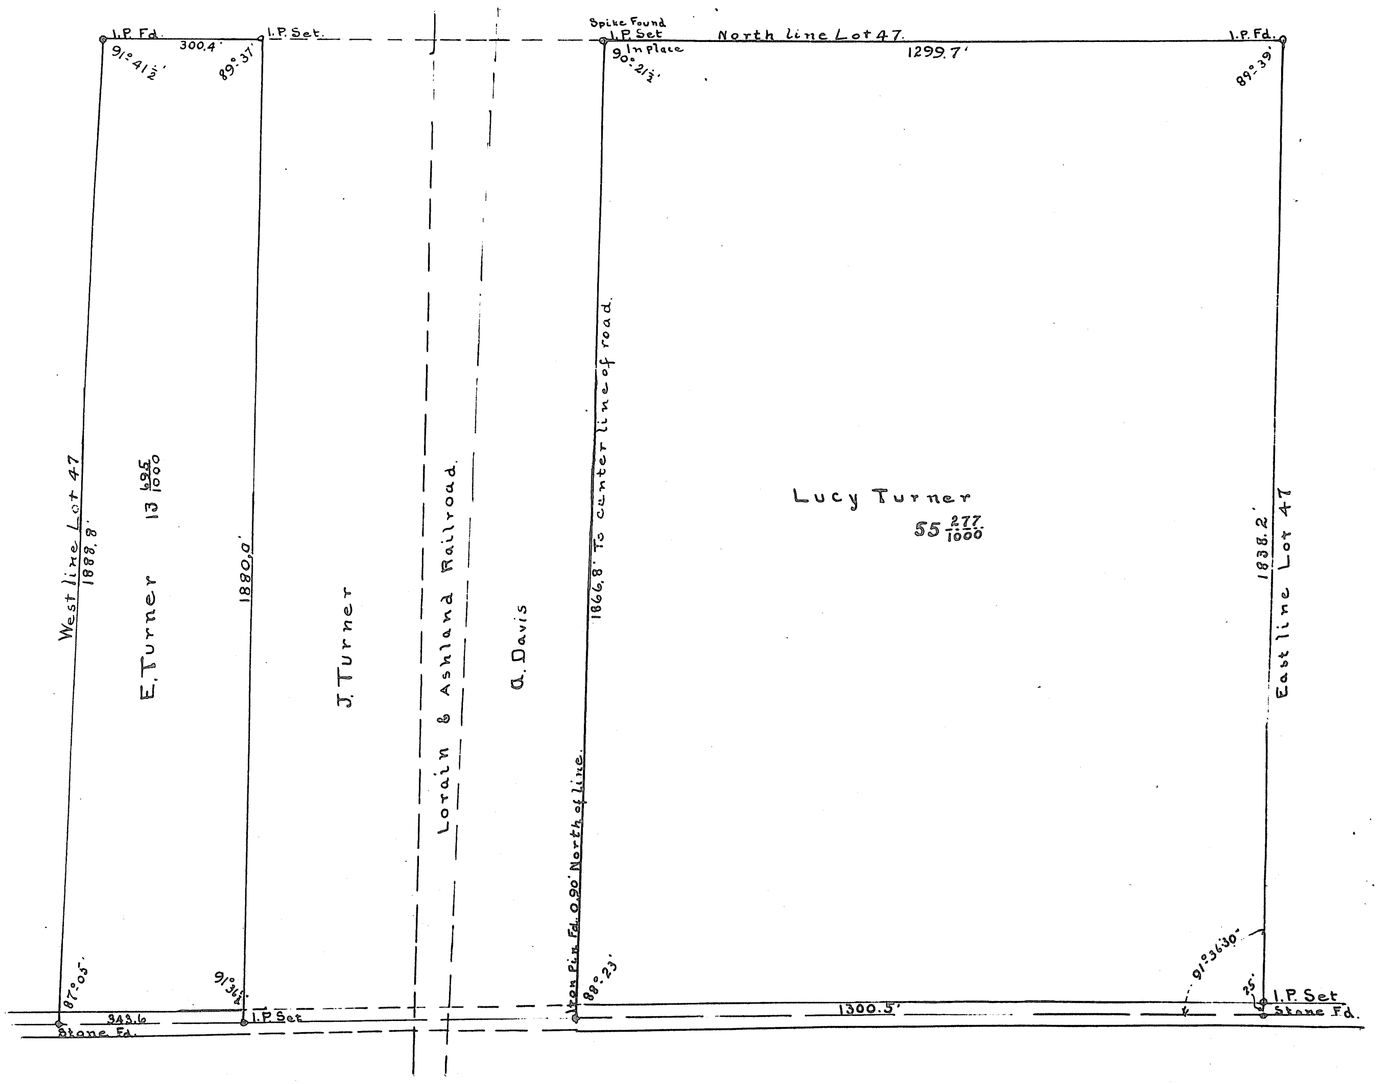

Received Mar. 9. 1909 At 12:36 P.M.
Recorder Mar. 10" 1909 Chas E. Tucker, Recorder.

Vol 7 Pg 59 (495)