http://www.adultpdf.com
Created by TIFF To PDF trial version, to remove this mark, please register this software.

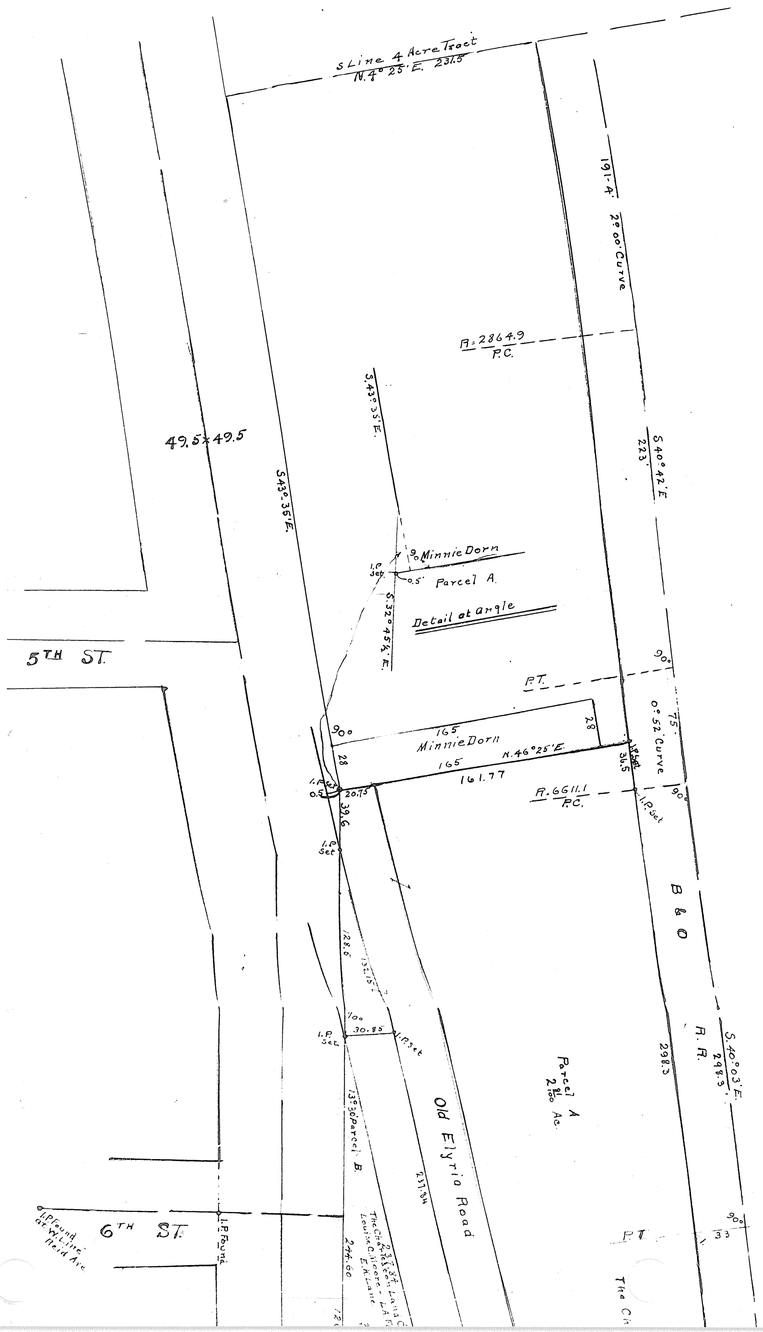

MAP

Showing Property in the City of Lorain, Ohio,
Abutting on what was formerly the old Elyria Road (sometimes called the Black Road) lying between the north line of Broadway and said north line extended westerly, and the south side of Lot dedicated to Minnie Dorn by deed recorded in Vol. 133 P. 235 Lorain Co. Deed Records.
Iron pins were found or set at all points so indicated on the map.
All measurements are given in feet and decimals thereof, all of which are believed to be correct.
Lorain, O. Sept. 8, 1916.
Scale 50 ft. 1 inch.

E. G. Rentschler Surveyor.

VOL 8 P.555 (209)

VOL 8 P.555 (209)