




UNIT 50-52 FRONT

 


UNIT 50 SIDE

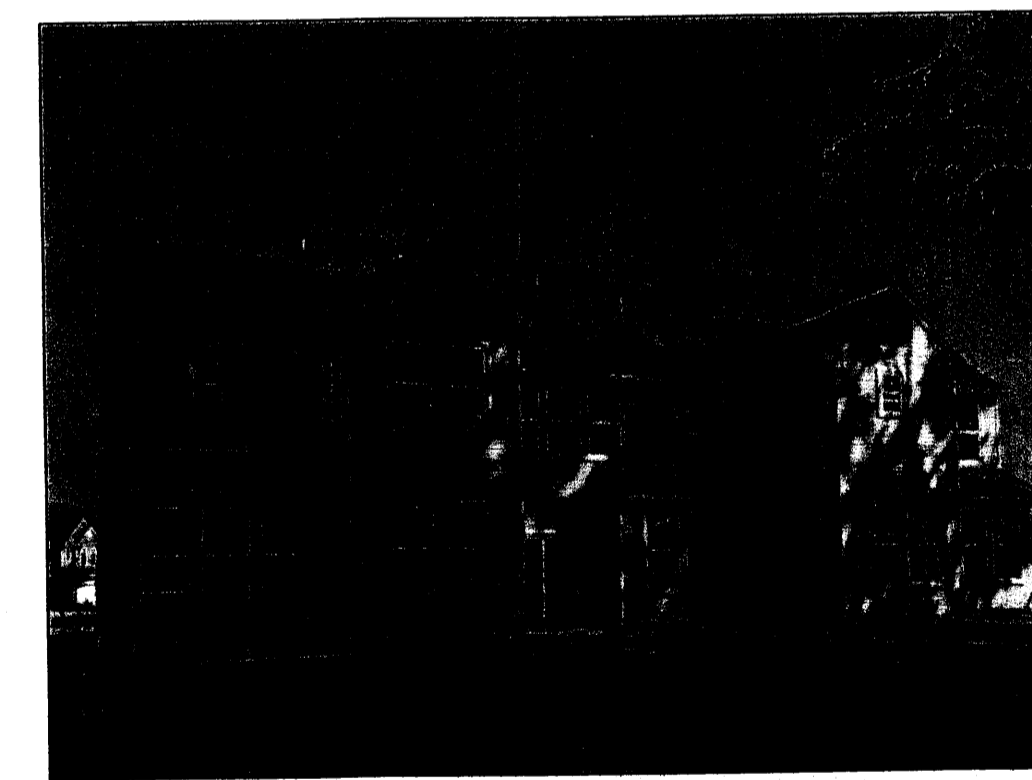

UNIT 50-52 REAR

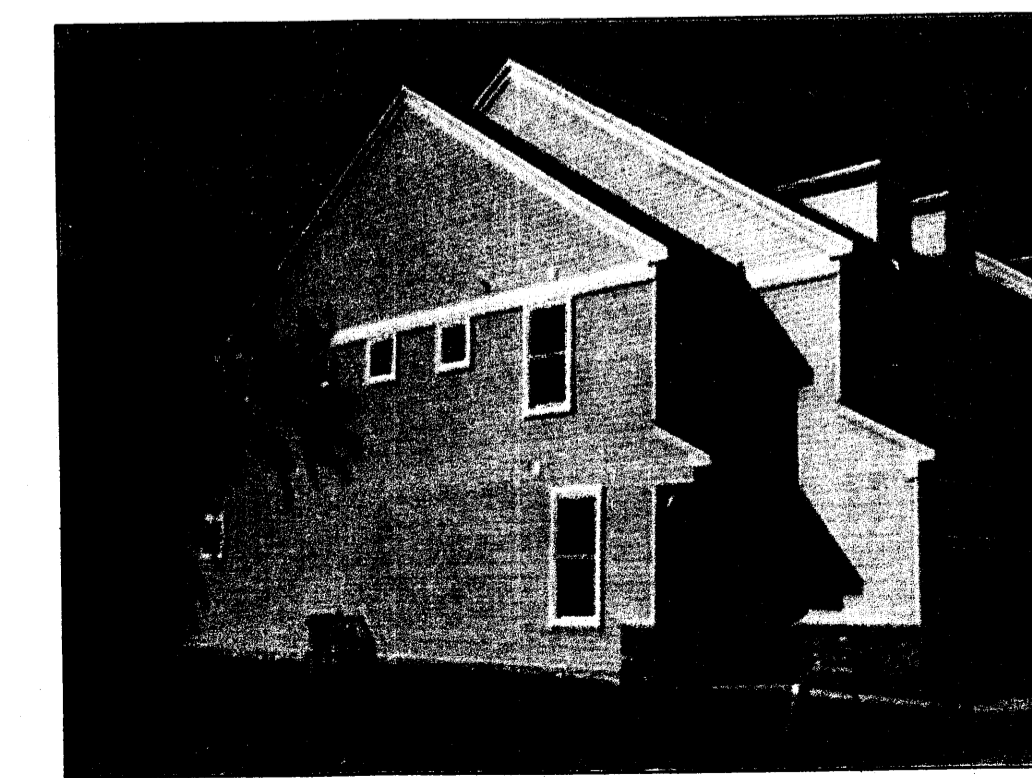

UNIT 52 SIDE

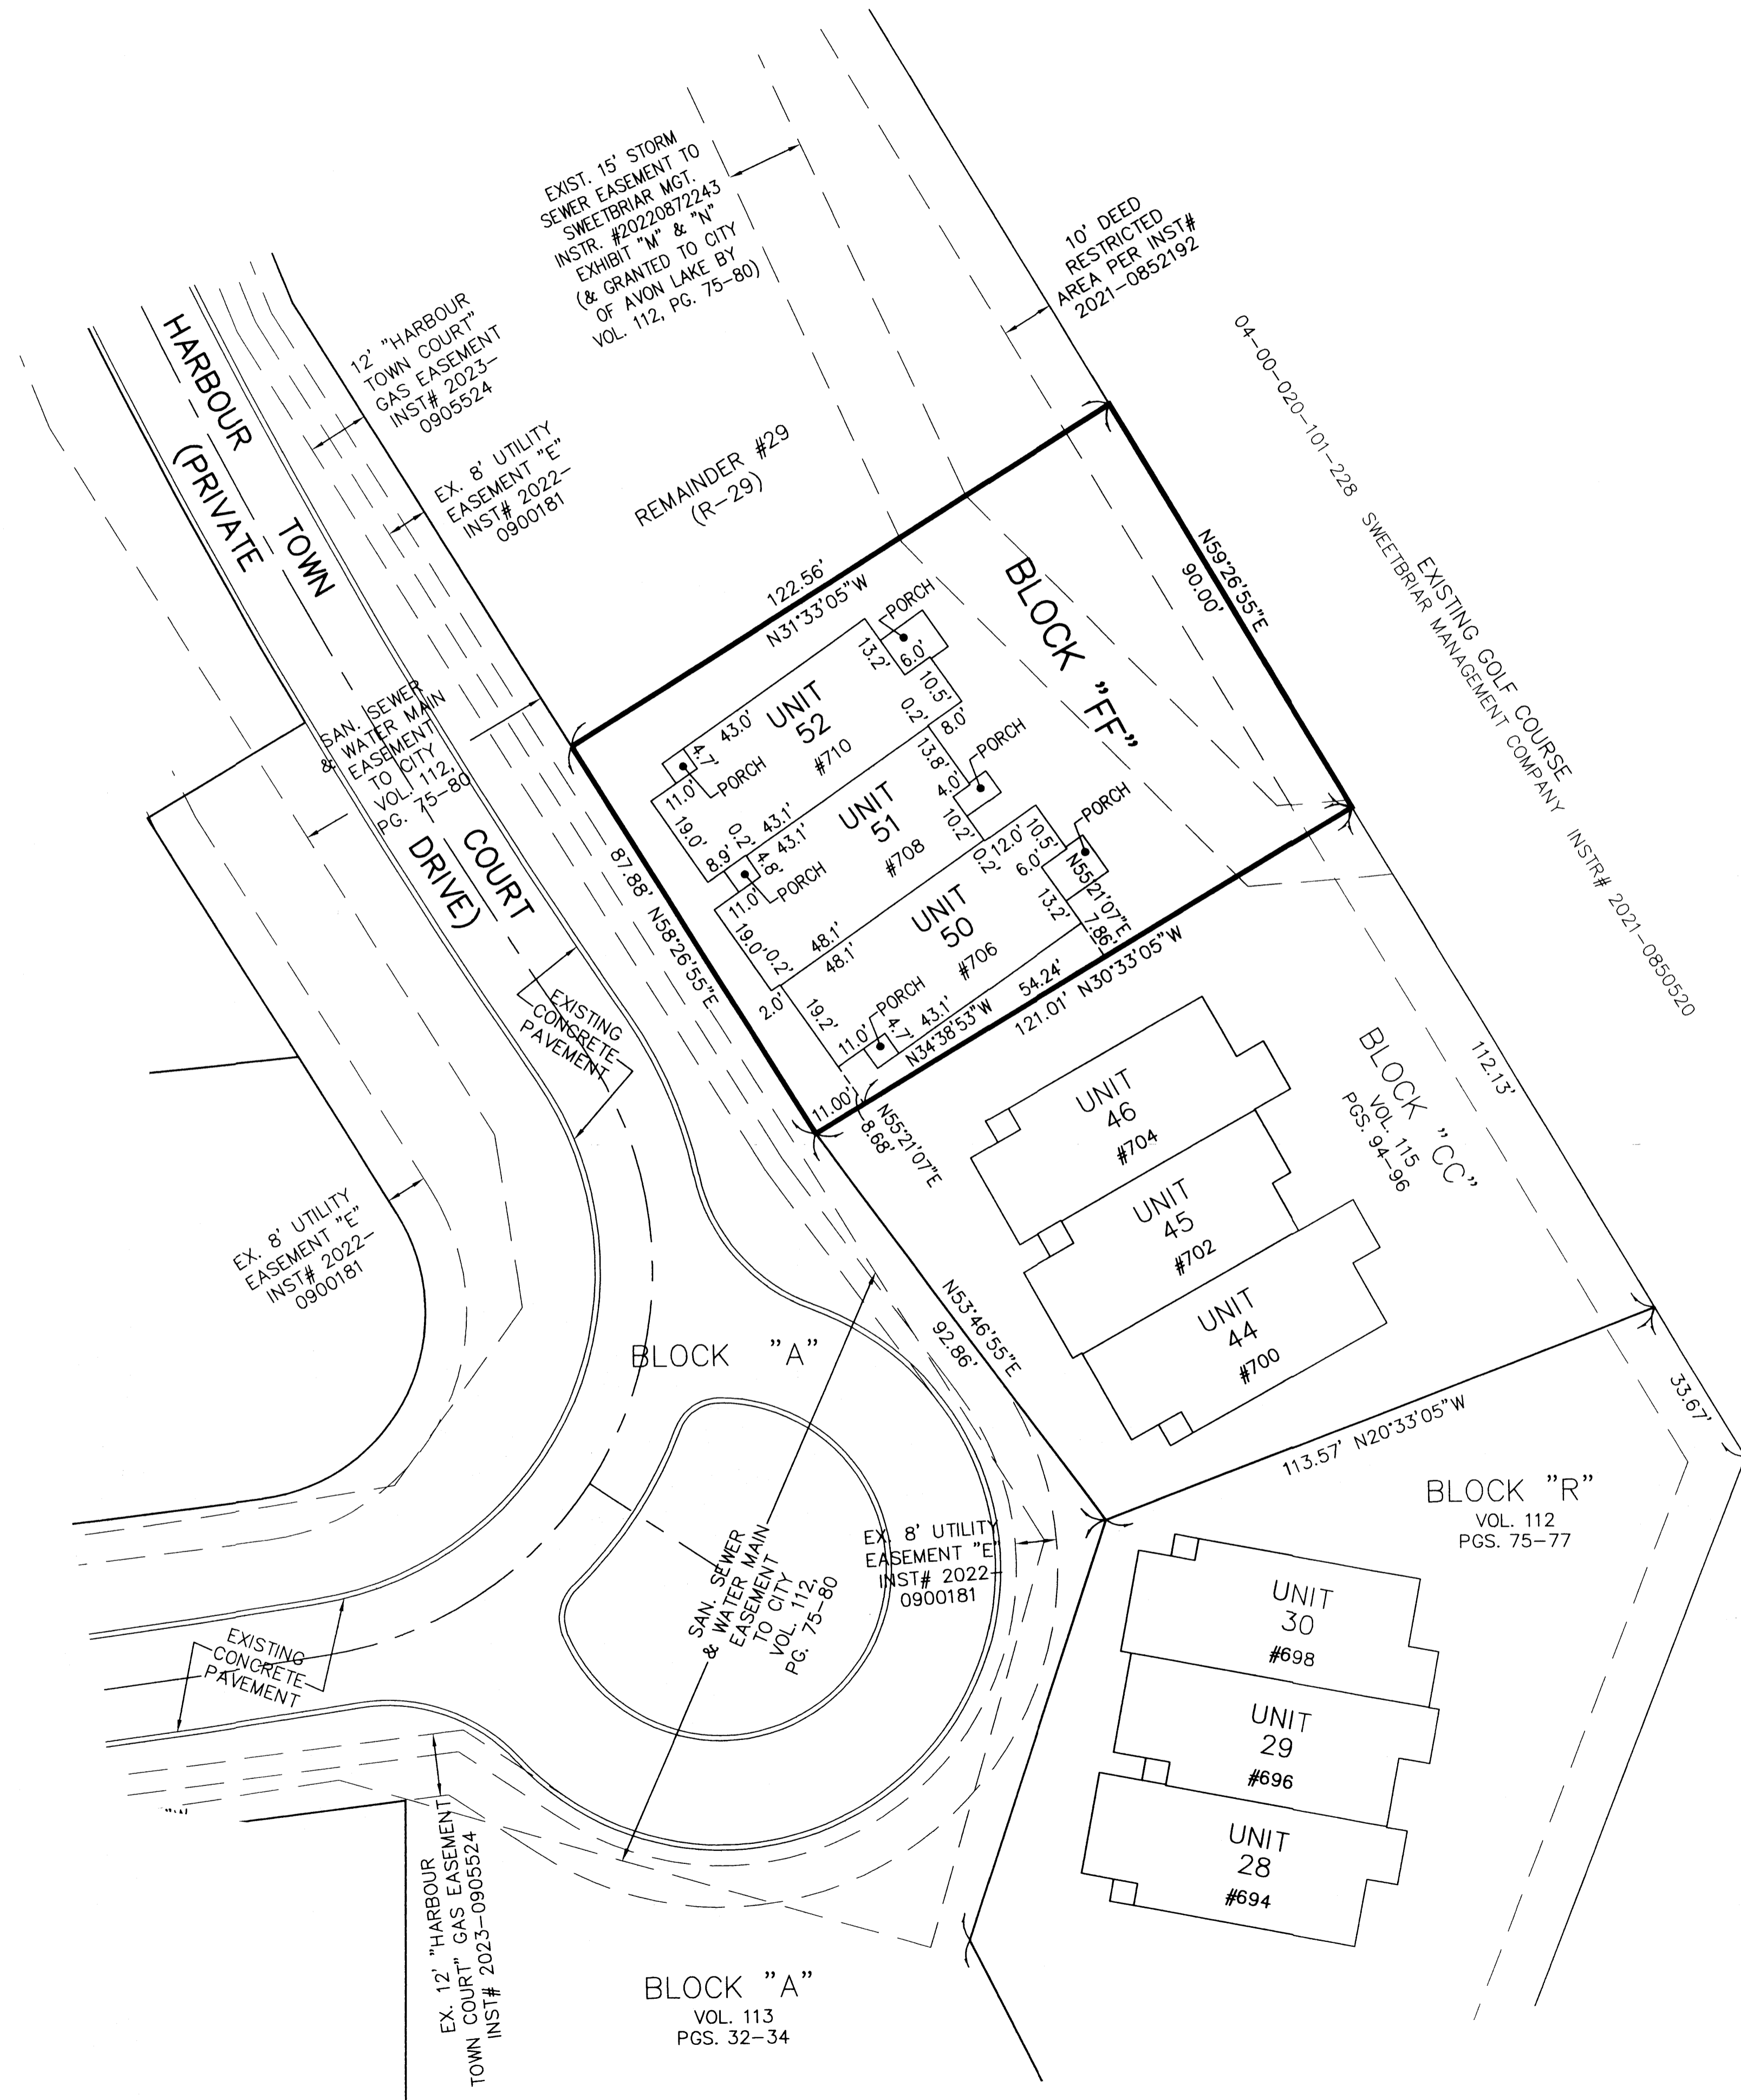

NOTE:
LIMITED COMMON ELEMENTS INCLUDE THE
LAND WITHIN 3 FEET FROM THE UNIT
FOUNDATION SHOWN AND WITHIN 3 FEET
OF ANY PATIOS, DECKS AND/OR PORCHES
ADJACENT TO THE FOUNDATION OF EACH
UNIT AND THE DRIVEWAY ADJACENT TO
THE FOUNDATION WITHIN 18 FEET OF THE
GARAGE DOOR.

ALL ANGLES BETWEEN ADJOINING WALLS
ARE 90° UNLESS OTHERWISE NOTED

BEARINGS BASED ON LEGACY
ISLE SUBDIVISION #1 PLAT

