VOL 15 PG 16 (623)

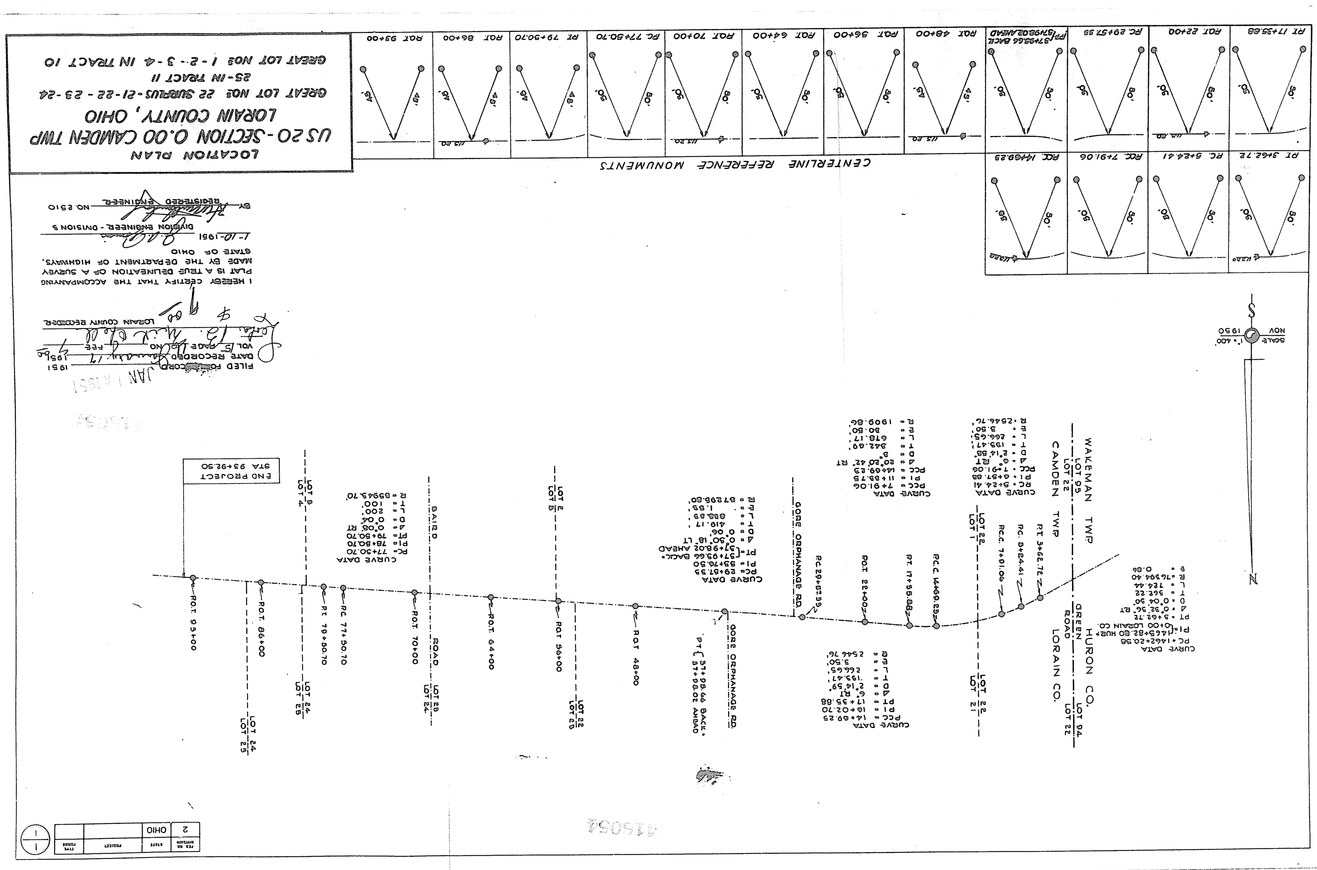

91

VOL 15 PG 16 (623)

http://www.adultpdf.com
Created by TIFF To PDF trial version, to remove this mark, please register this software.