


ORIGINAL TWP. LOT 23 AMHERST VILLAGE

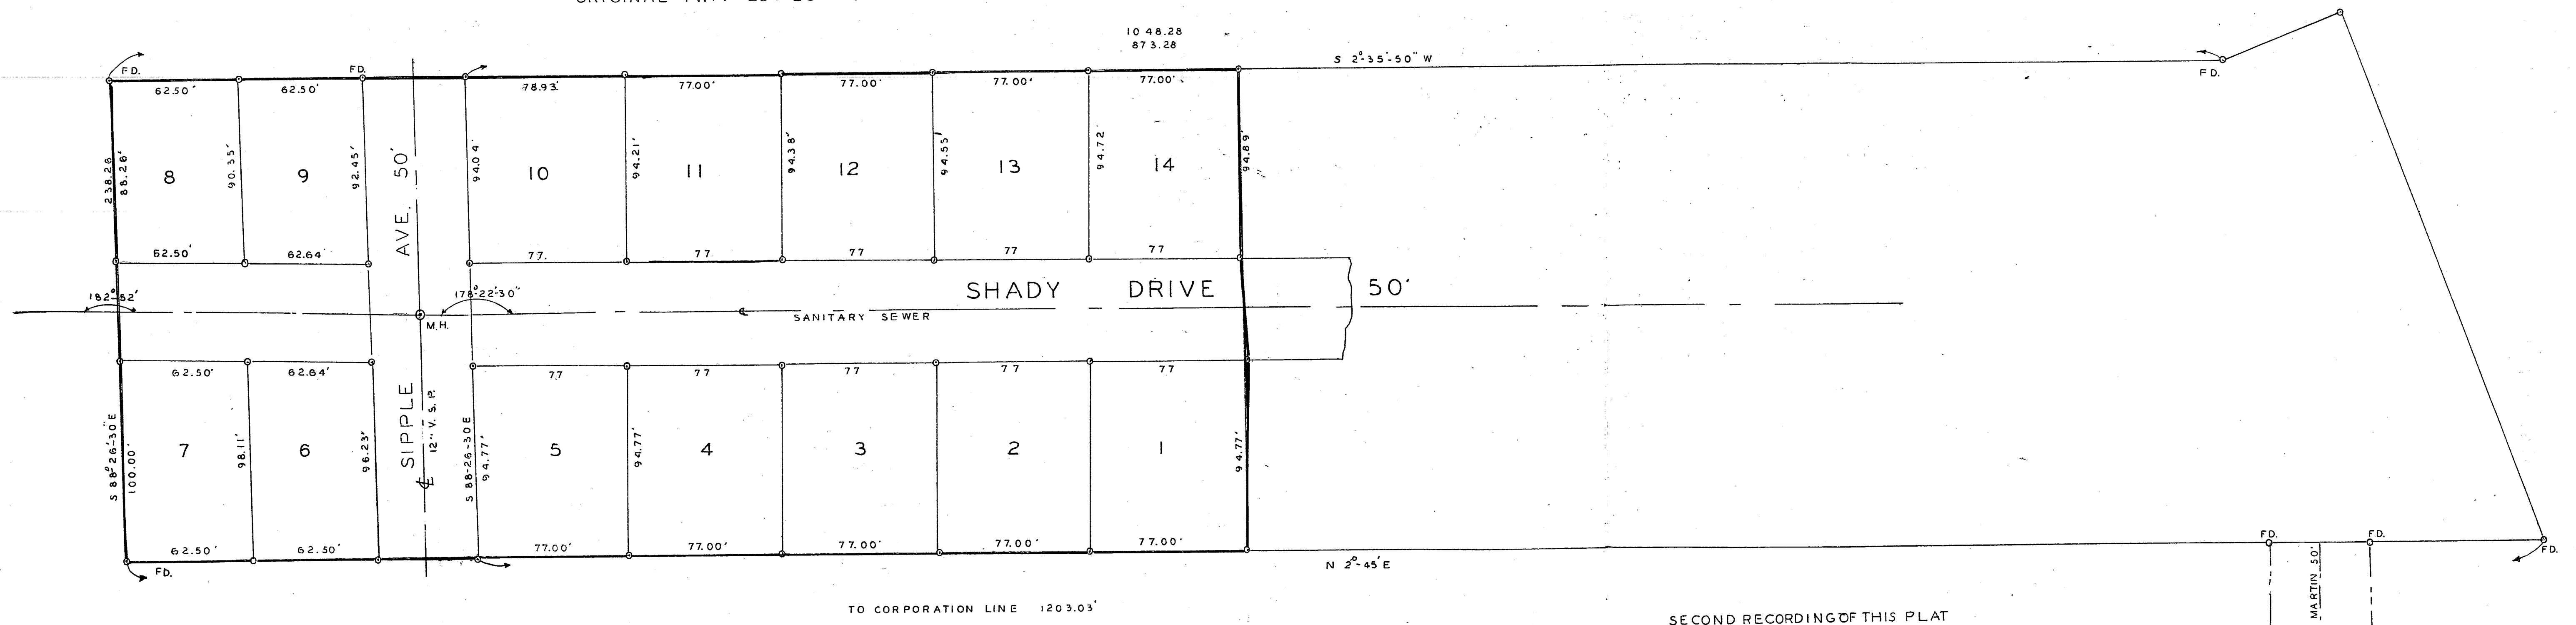

SURVEYORS CERTIFICATE

THIS IS TO CERTIFY THAT AT THE REQUEST OF AUGUST BRANDT, I HAVE SURVEYED AND STAKED THIS SUBDIVISION WHICH COMPRISES AN AREA OF 3.077 ACRES OF LAND. DISTANCES ARE SHOWN IN FEET AND DECIMAL PARTS THEREOF. BEARINGS SHOWN ARE ASSUMED AND ARE FOR DESCRIBING ANGLES ONLY. IRON PINS WERE FOUND OR SET AS INDICATED. C. E. RICHARDS REGISTERED SURVEYOR INDICATES IRON PINS FOUND OR SET.

THIS IS TO CERTIFY THAT AUGUST BRANDT, OWNER OF LAND AS BOUNDED BY HEAVY LINES, ACCEPTS THIS PLAT AS CORRECT AND DEDICATES TO PUBLIC USE SHADY DRIVE. AUGUST W. BRANDT

SURVEYORS SEAL

STATE OF OHIO
LORAIN COUNTY

BEFORE ME, A NOTARY PUBLIC IN AND FOR SAID COUNTY AND STATE, PERSONALLY APPEARED AUGUST BRANDT WHO ACKNOWLEDGED THAT HE DID SIGN THIS PLAT AND THAT THE SAME IS HIS FREE ACT AND DEED. HE DID SIGN THIS PLAT AND THAT THE SAME IS HIS FREE ACT AND DEED, AT THIS 15 DAY OF MAY AD 1956

W.M. ROBERTSON
NOTARY PUBLIC
MY COMMISSION EXPIRES JAN. 12, 1959

THIS IS TO CERTIFY THAT THE ABOVE PLAT WAS ACCEPTED BY THE COUNCIL OF THE VILLAGE OF AMHERST, OHIO, BY MOTION PASSED THE 17TH DAY OF APRIL 1956

I HEREBY CERTIFY THAT THE LAND HEREIN DEDICATED IS COVERED BY PROPER CERTIFICATE OF TITLE, AND DEDICATION IS HEREBY APPROVED AS TO FORM.

JACK KOONTZ MAYOR
ROBERT RENOARD CLERK

TRANSFERRED MAY 22, 1956 FRANK AYRES AUDITOR
TRANSFERRED SEPT. 26, 1956 FRANK AYRES AUDITOR

APPROVED
THIS IS TO CERTIFY THAT THE ABOVE PLAT IS HEREBY APPROVED BY THE PLANNING COMMISSION OF THE VILLAGE OF AMHERST, OHIO, ON THIS 2ND DAY OF FEBRUARY 1956

F. H. HOGREFE SECRETARY

RECEIVED FOR RECORD THIS 22ND DAY OF MAY 1956
AT 1:50 O'CLOCK P.M. RECORDED IN VOLUME 19
PAGE 7A OF THE LORAIN COUNTY RECORDS RECORDED MAY 22 1956
LEOTA B. MITCHELL RECORDER
M.C. RECORDING FEE \$14.90

SECOND RECORDING OF THIS PLAT
SEPTEMBER 11, 1956
CHANGED DIMENSIONS OF DEPTH OF FOUR SUBLOTS -
NAMESLY: SUBLOTS NOS 6, 7, 8 AND 9 BECAUSE OF
SURVEYORS REVISION AUGUST W. BRANDT.

THIS IS TO CERTIFY THAT THIS PLAT SHOWING REVISION ON THE SIZE OF SUBLOTS 6-7-8-9 IS APPROVED BY PLANNING COMMISSION F.H. HOGREFE DATE 9-24-56

THIS IS TO CERTIFY THAT THIS PLAT SHOWING REVISION ON THE SIZE OF SUBLOTS 6-7-8-9 IS APPROVED BY SURVEYOR C.E. RICHARDS DATE 9-24-56

RECEIVED FOR RECORD SEPT. 26 1956 AT 2:43 P.M.
RECORDED SEPT. 26 1956 IN RECORD VOL. 19 PAGE 26
LEOTA B. MITCHELL
LORAIN COUNTY RECORDER
M.C.
RECORDING FEE \$14.90

SHADY DRIVE SUBDIVISION

ORIGINAL TWP. LOT 23 AMHERST VILLAGE