Lorain County Auditor's Office
Geodetic Survey Marker

Station Name: 2003-40 | Alias: None
USGS Quad: Avon | Township: Elyria
Type of Mark: Bronze Disk | Set By: KS Associates, Inc.
Stamping on Mark: 2003-40 | Survey By: KS Associates, Inc.
Horizontal Datum: NAD83(NSRS2007) | Horizontal Order: First | Method: GPS
Latitude: 41-23-36.91562 | Longitude: 82-06-59.80630
North (y) Meters: 191840.043 | East (x) Meters: 632062.166
North (y) USFeet: 629395.207 | East (x) USFeet: 2073690.623
Convergence: 0-15-06.72 | Combined Scale Factor: 0.99992706
State Plane Coordinate System Zone: Ohio North (3401)
Vertical Datum: NAVD88 | Vertical Order: Second
Elevation (z) Meters: 214.411 | Elevation (z) USFeet: 703.45

Location: To reach the monument, commence at the intersection of State Route 113 and State Route 57 in Elyria and travel North on State Route 57 0.7 miles more or less to the station in the median. The station is a bronze disk in concrete.
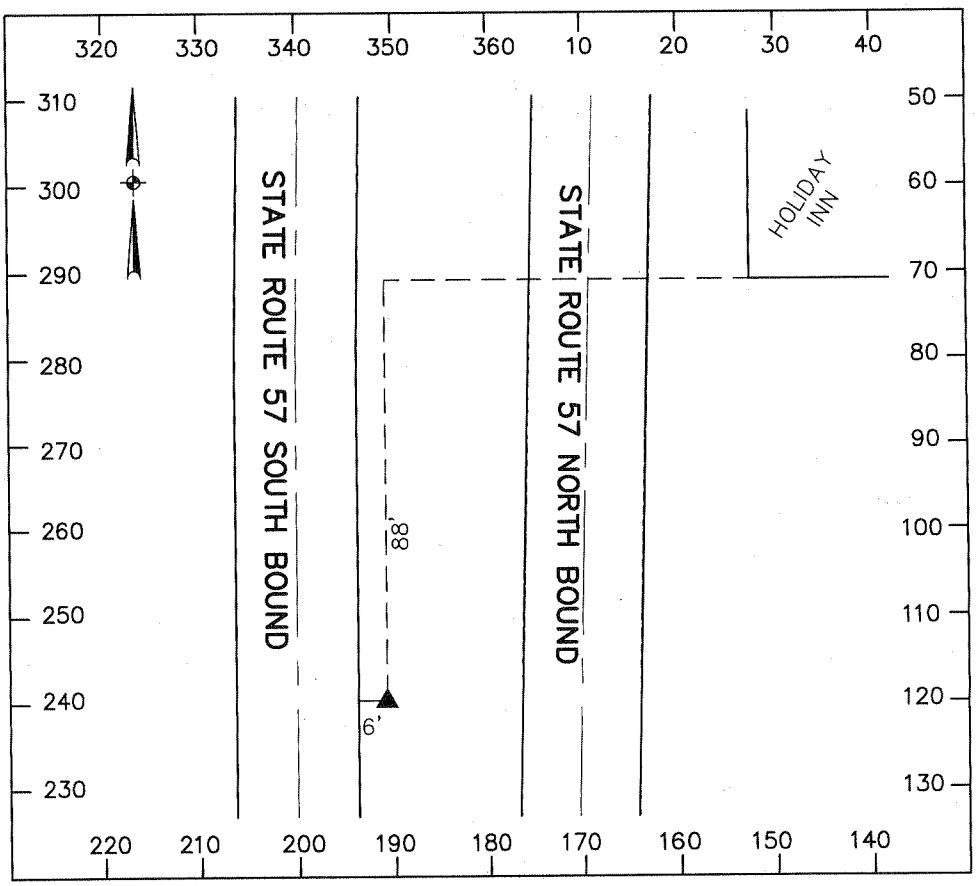
Readjusted March 2007