Lorain County Auditor's Office
Geodetic Survey Marker

Station Name: 2005-32 | Alias: None
USGS Quad: Wellington | Township: Pittsfield
Type of Mark: Bronze Disk | Set By: KS Associates, Inc.
Stamping on Mark: 2005-32 | Survey By: KS Associates, Inc.
Horizontal Datum: NAD83(NSRS2007) | Horizontal Order: First | Method: GPS
Latitude: 41-14-12.92673 | Longitude: 82-13-43.18373
North (y) Meters: 174406.788 | East (x) Meters: 622745.795
North (y) USFeet: 572199.603 | East (x) USFeet: 2043125.163
Convergence: 0-10-41.72 | Combined Scale Factor: 0.99990969
State Plane Coordinate System Zone: Ohio North (3401)
Vertical Datum: NAVD88 | Vertical Order: Second
Elevation (z) Meters: 249.778 | Elevation (z) USFeet: 819.48

Location: To reach the monument, commence at the intersection of S.R. 303 and S.R. 58 in Pittsfield Township and travel West on S.R. 303 0.6 miles more or less to the station on the left. The station is a bronze disk in concrete.
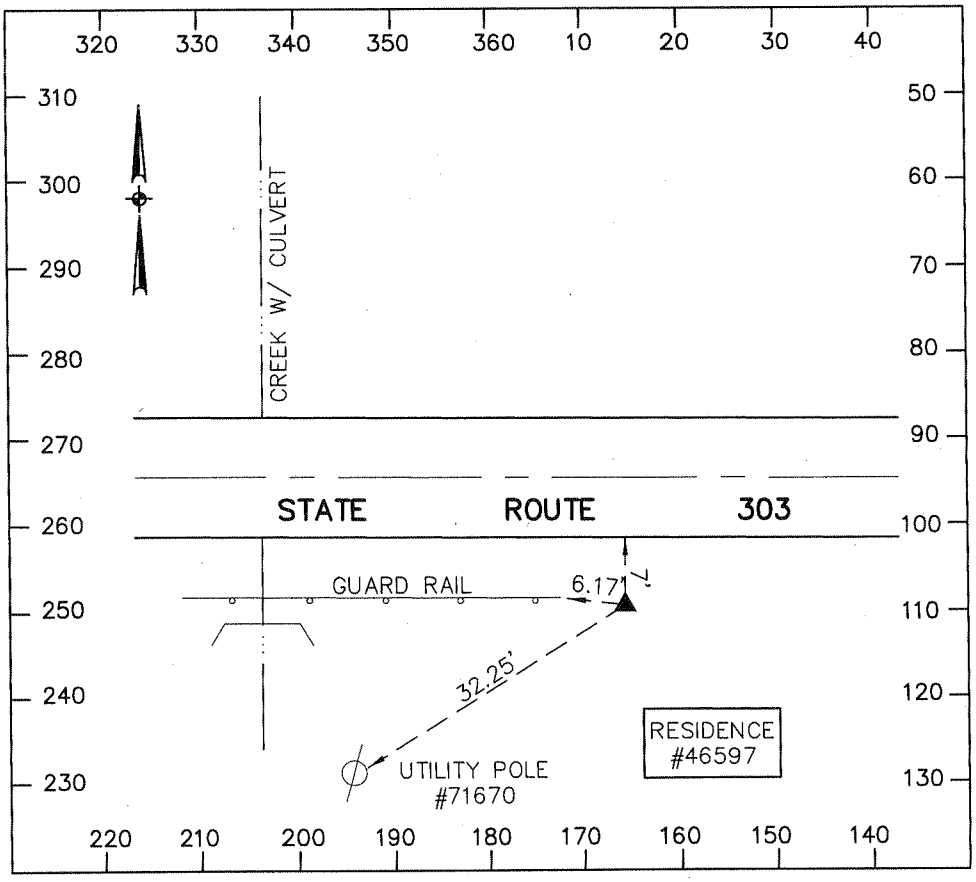
Readjusted March 2007