



Cresthaven Subdivision No. 2

Part of; Original Lot # 45 & 46
West of Black River, Elyria
Twp., Lorain County, Ohio
by Ray E. Hollis, registered surveyor

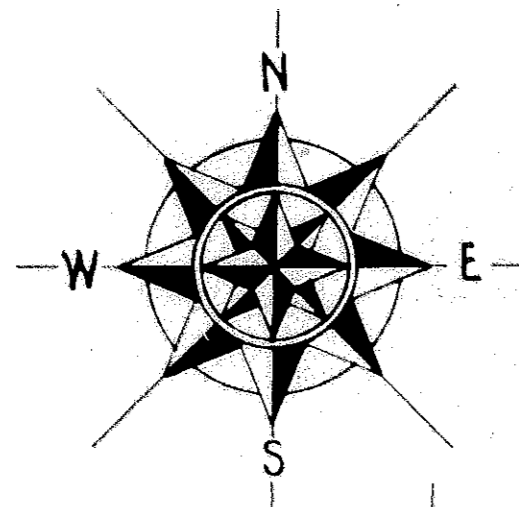

NOVEMBER 1958
SCALE 1" = 100'

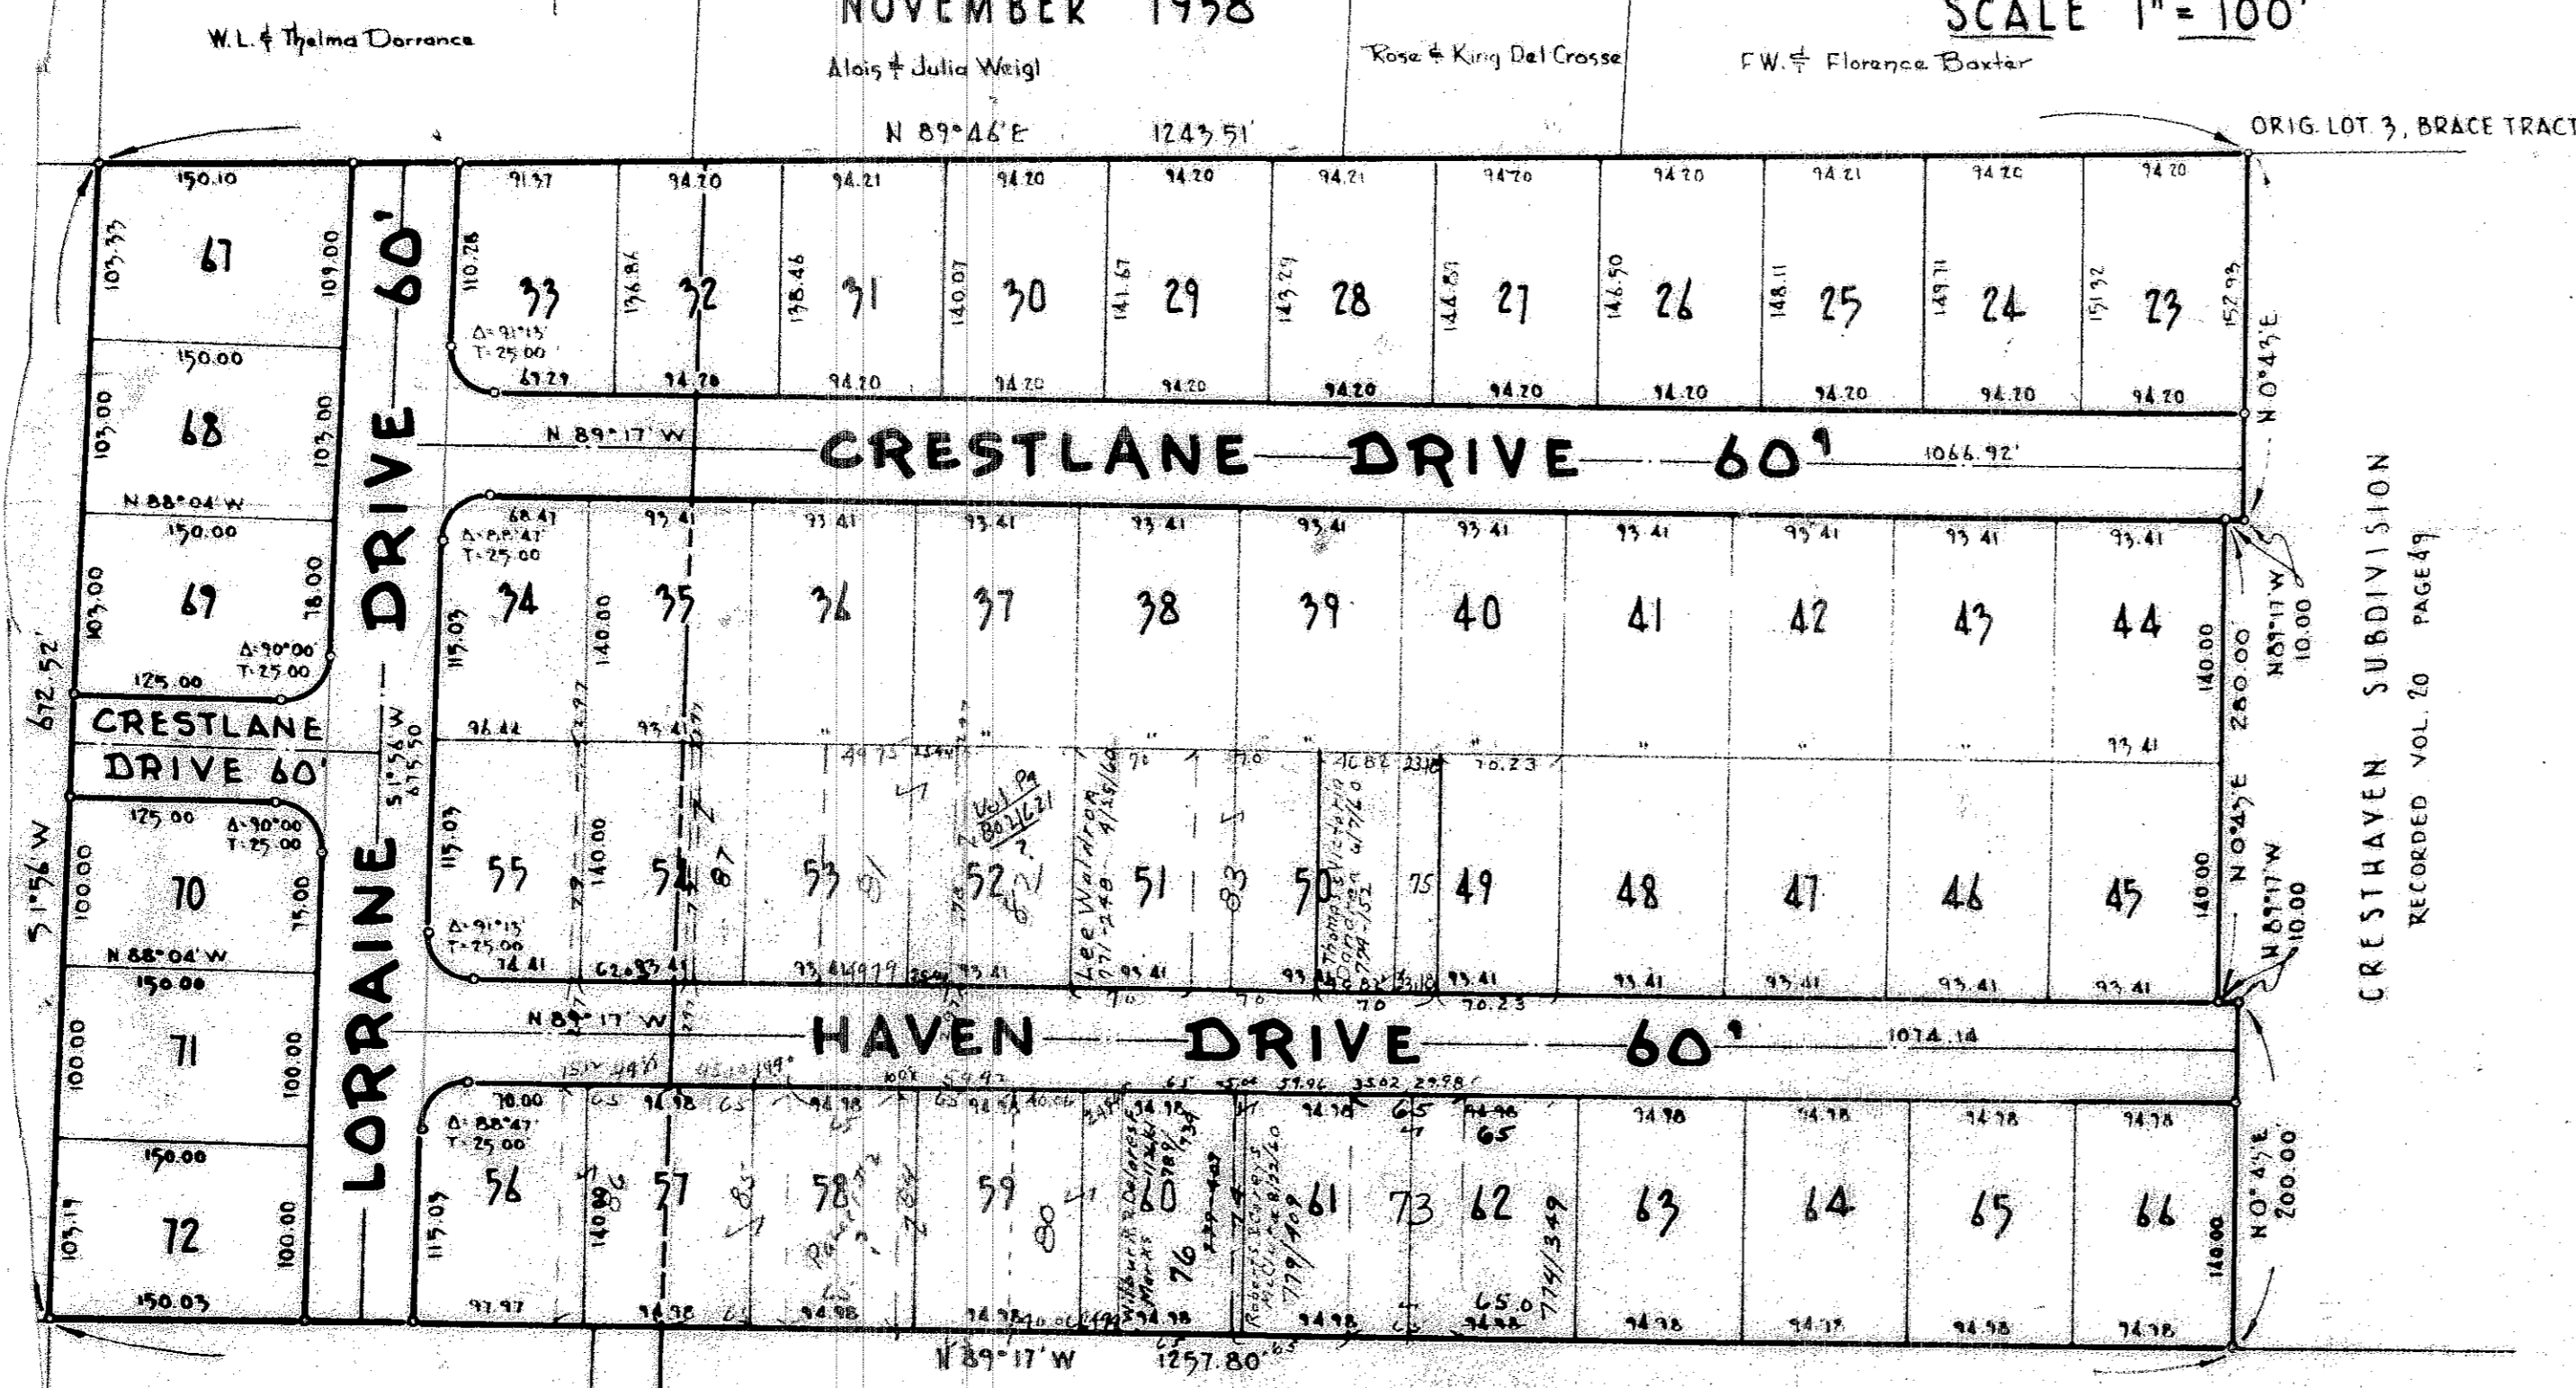

SURVEYOR'S CERTIFICATE:
THIS IS TO CERTIFY THAT AT THE REQUEST OF RUSSELL H. STANG AND LORRAINE STANG, OWNERS OF LANDS CONTAINED WITHIN THIS FOREGOING PLAT OF CRESTHAVEN SUBDIVISION NO. 2, I HAVE SURVEYED AND PLATTED THE SAME AS SHOWN HEREON, EMBRACING 19.5904 ACRES OF ORIGINAL TOWNSHIP LOTS 45 & 46, WEST OF BLACK RIVER, ELYRIA TOWNSHIP, AT ALL POINTS SO INDICATED. IRON PIN MONUMENTS WERE EITHER FOUND OR SET. DISTANCES SHOWN ARE IN FEET AND DECIMAL PARTS THEREOF. BEARINGS USED ARE ASSUMED AND FOR PURPOSES OF DESCRIBING ANGLES ONLY, ALL OF WHICH I CERTIFY TO BE CORRECT.

OWNER'S CERTIFICATE:
THIS IS TO CERTIFY THAT WE THE UNDERSIGNED RUSSELL H. STANG AND LORRAINE STANG, OWNERS OF LANDS CONTAINED WITHIN CRESTHAVEN SUBDIVISION NO. 2, HAVING EXAMINED THIS FOREGOING PLAT, DO HEREBY ACCEPT THE SAME TO BE CORRECT AND DEDICATE TO PUBLIC USE CRESTLANE DRIVE, HAVEN DRIVE, AND LORRAINE DRIVE AS SHOWN HEREON.

COUNTY OF LORAIN } 55:
STATE OF OHIO }
THIS IS TO CERTIFY THAT BEFORE ME, A NOTARY PUBLIC IN AND FOR SAID COUNTY AND STATE, DID PERSONALLY APPEAR RUSSELL H. STANG AND LORRAINE STANG, OWNERS OF LANDS CONTAINED WITHIN CRESTHAVEN SUBDIVISION NO. 2, WHO ACKNOWLEDGED THE SIGNING OF THIS PLAT TO BE THEIR OWN FREE ACT AND DEED. IN TESTIMONY WHEREOF I HAVE HERETO SET MY HAND AND OFFICIAL SEAL THIS 3rd DAY OF 1958.

MY COMMISSION EXPIRES: _____ NOTARY PUBLIC

THIS IS TO CERTIFY THAT THE ABOVE PLAT OF CRESTHAVEN SUBDIVISION NO. 2 IS HEREBY ACCEPTED AND APPROVED BY THE PLANNING COMMISSION OF THE CITY OF ELYRIA, OHIO, ON THIS _____ DAY OF _____ 1958.

PRESIDENT _____ CITY ENGINEER, ELYRIA, O.
SECRETARY _____

See Exhibit
No. # 551855
Misc. V. 20-185

10:00 A.M. Feb 24, 59
Plat 21
Lester B. Westchell, Lorain County Recorder

Reading fee 5.00