


PLAZA HEIGHTS ALLOTMENT REPLAT
 PART OF O.L. 26 AMHERST TWP, NOW AMHERST VILLAGE LORAIN CO., O.
 SEPTEMBER 15, 1959
 SCALE 1"=100'

BY ARNOLD F. KOEPP REG. SURVEYOR NO. 4306

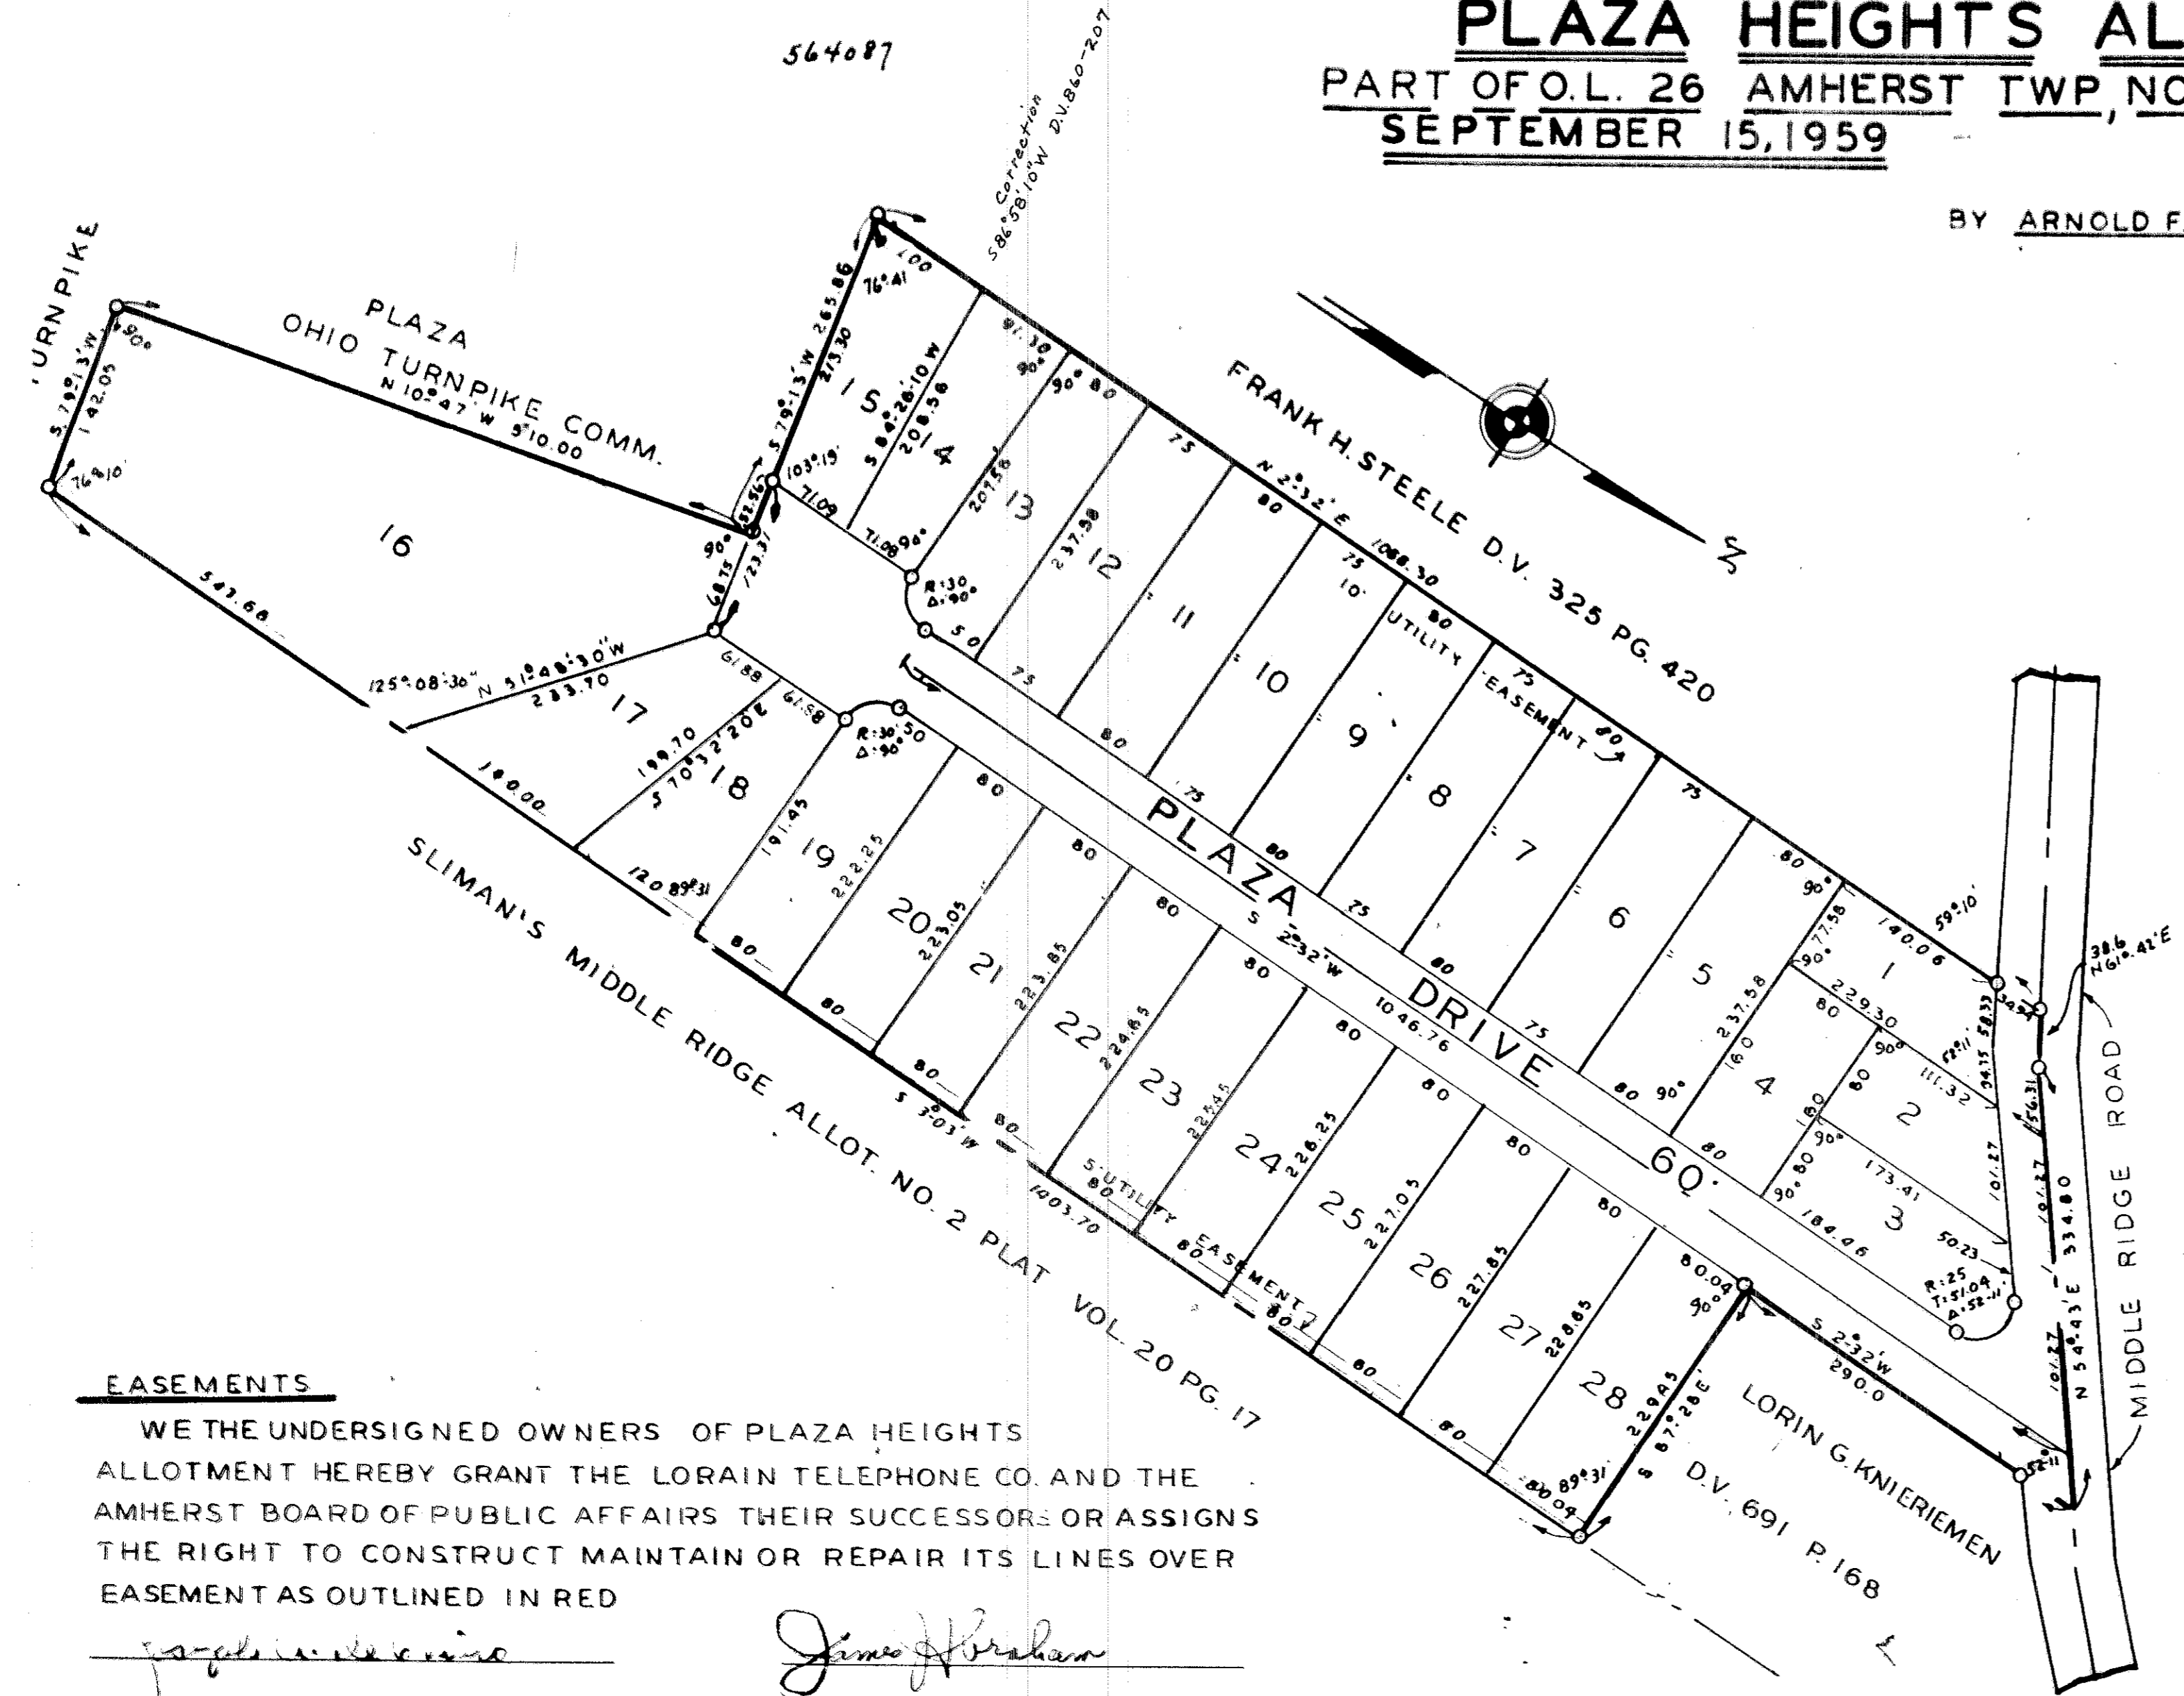

EASEMENTS

WE THE UNDERSIGNED OWNERS OF PLAZA HEIGHTS ALLOTMENT HEREBY GRANT THE LORAIN TELEPHONE CO. AND THE AMHERST BOARD OF PUBLIC AFFAIRS THEIR SUCCESSORS OR ASSIGNS THE RIGHT TO CONSTRUCT MAINTAIN OR REPAIR ITS LINES OVER EASEMENT AS OUTLINED IN RED

Joseph DeChiaro *James J. Abraham*

THIS REVISED PLAT IS FILED IN PLACE OF THE ORIGINAL FILED IN PLAT VOL. 20 PAGE 29 OF LORAIN COUNTY PLAT RECORDS. THE CHANGES ARE IN WIDTHS OF LOTS LENGTHS OF LOTS AND THE ADDITION OF 6 MORE LOTS

COUNTY RECORDER

RECEIVED FOR RECORD October 6, 1959 AT 8:07 AM O'CLOCK
 RECORDED October 6, 1959 IN PLAT VOL. 22 PAGE 12

Leta B. Mitchell
 LORAIN COUNTY RECORDER *for \$20*

SURVEYORS CERTIFICATE:

THIS PLAT MADE AT THE REQUEST OF JAMES J. ABRAHAM & JOSEPH A. DECHIARO EMBRACES 12.6 AC OF LAND IN ORIGINAL LOT NO. 26 AMHERST TWP. NOW AMHERST VILLAGE, LORAIN COUNTY, OHIO MONUMENTS WERE FOUND OR SET AT ALL POINTS INDICATED THUS MEASUREMENTS ARE IN FEET AND DECIMAL PARTS THEREOF. BEARINGS USED ARE TO DENOTE ANGLES ONLY. MIDDLE RIDGE ROAD CONTAINS 0.26 AC. PLAZA DRIVE CONTAINS 1.82 AC OF LAND. EASEMENTS ARE AS NOTED

Arnold F. Koopp
 REGISTERED SURVEYOR

OWNERS CERTIFICATE:

THE UNDERSIGNED OWNERS OF PLAZA HEIGHTS ALLOTMENT HEREBY ACCEPT THE SAME TO BE CORRECT AND DEDICATE TO PUBLIC USE FOR STREET PURPOSES PLAZA DRIVE AND MIDDLE RIDGE ROAD AS SHOWN HEREON.

Joseph DeChiaro *James J. Abraham*
 COUNTY OF LORAIN STATE OF OHIO S.S. BEFORE ME, A NOTARY PUBLIC, IN AND FOR SAID COUNTY AND STATE, PERSONALLY APPEARED BEFORE ME, JAMES J. ABRAHAM AND JOSEPH A. DECHIARO, OWNERS OF PLAZA HEIGHTS ALLOTMENT, AS OUTLINED BY HEAVY BLACK LINES WHO ACKNOWLEDGED THAT THEY DID SIGN THE FOREGOING PLAT AND THAT IT WAS THEIR FREE ACT AND DEED, IN TESTIMONY WHEREOF, I HAVE HEREUNTO SET MY HAND AND OFFICIAL SEAL AT AMHERST, OHIO. THIS 18 DAY OF Sept 1959






 VILLAGE ENGINEER