
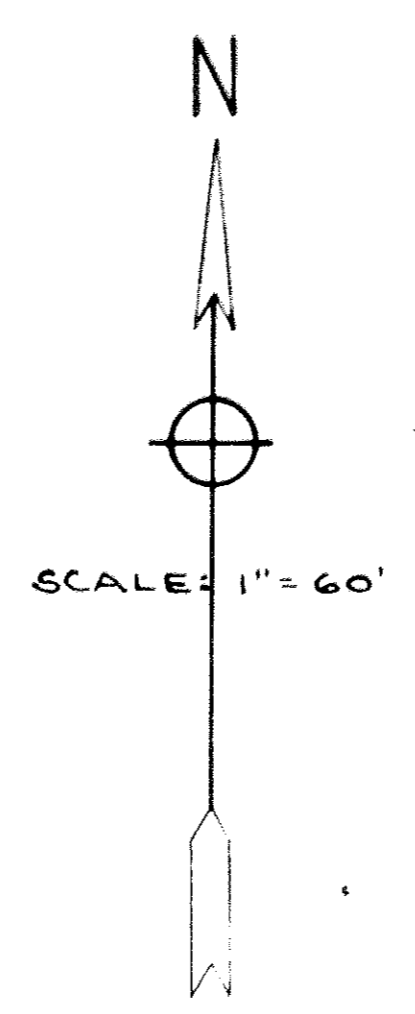


572112
NORTHERN COURT ALLOTMENT
PART OF ORIGINAL ELYRIA TOWNSHIP LOT NO. 4
EAST OF THE EAST BRANCH OF THE BLACK RIVER
ELYRIA CITY, LORAIN COUNTY, STATE OF OHIO

572112

42

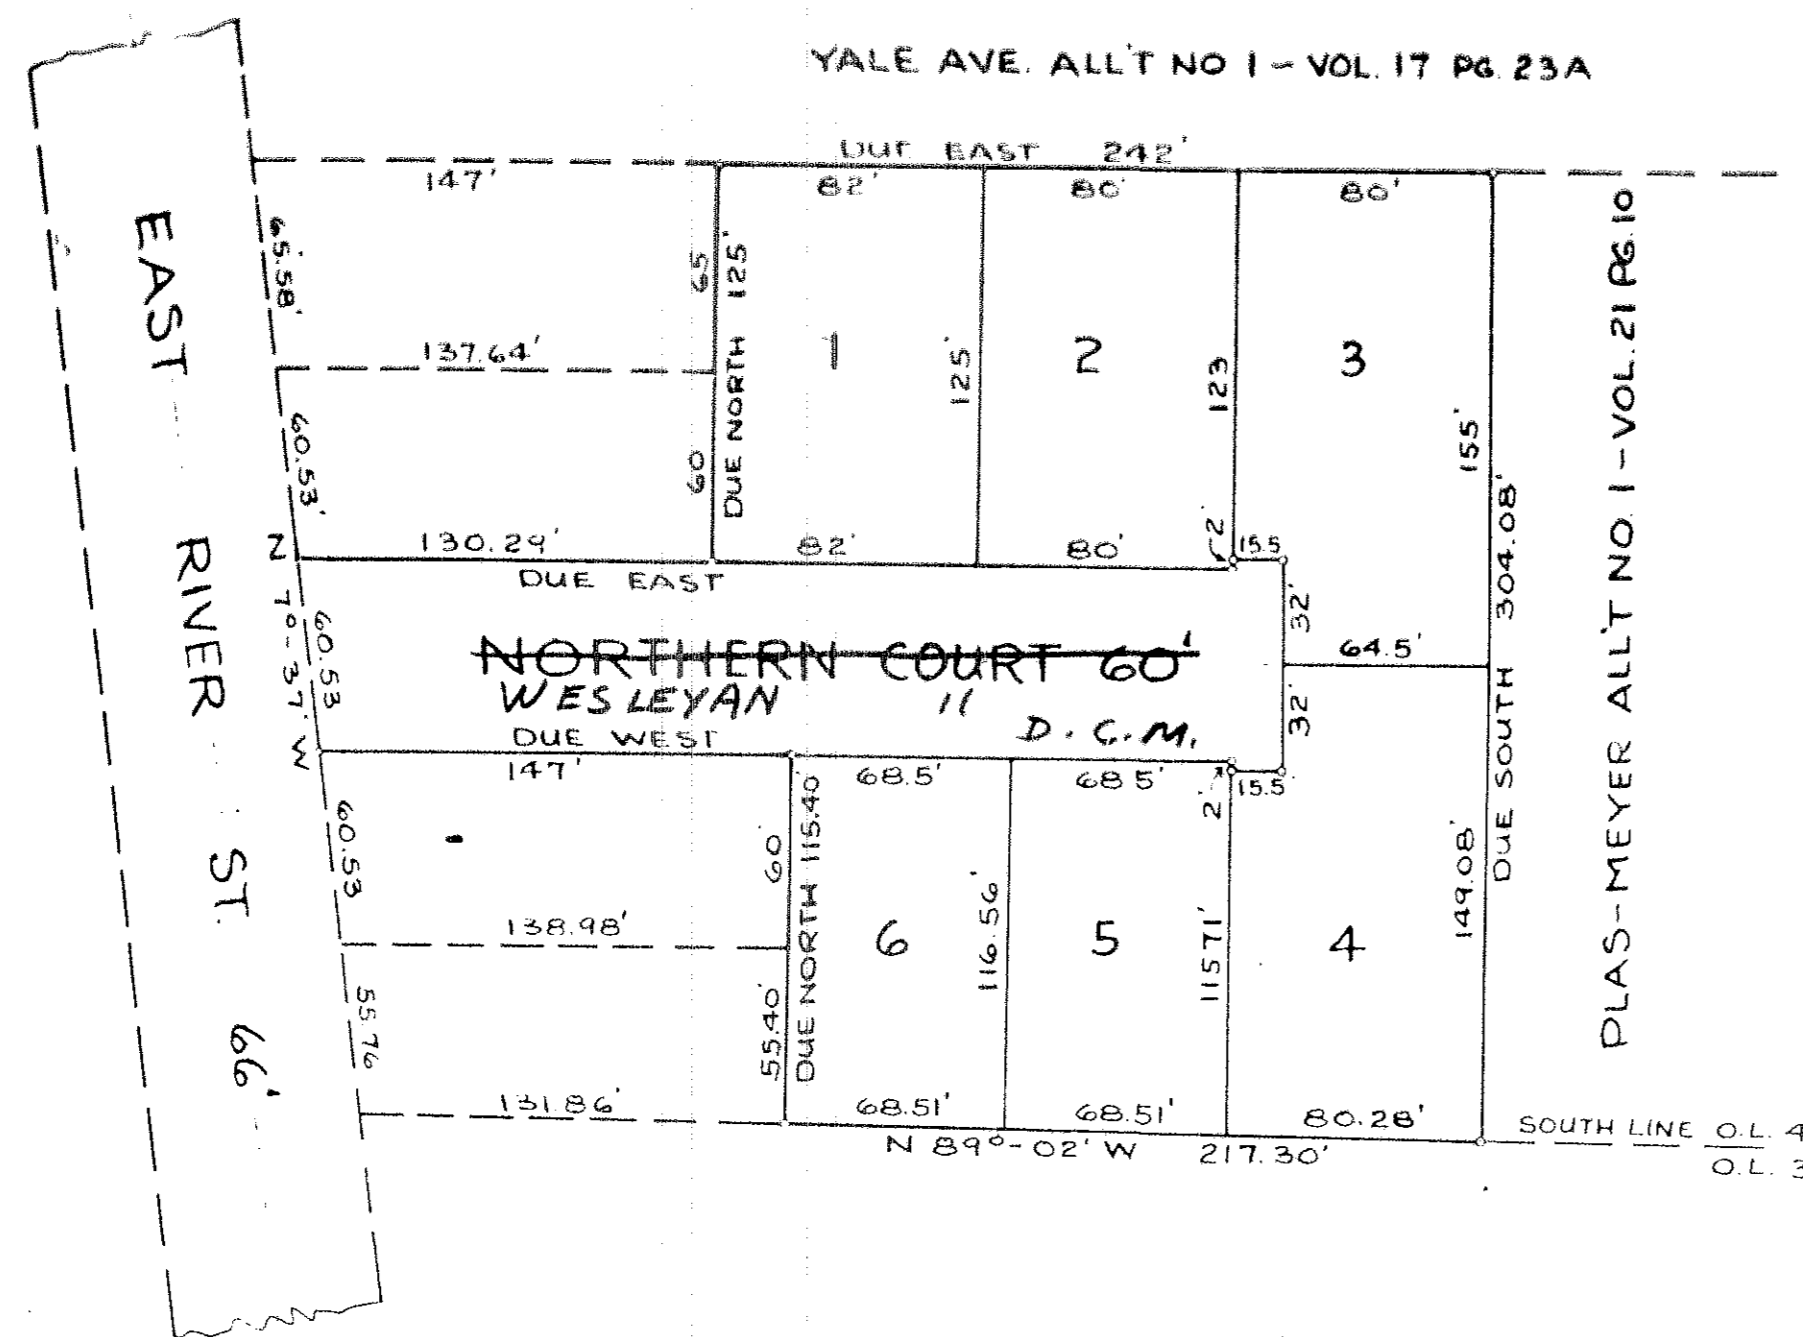

STATE OF OHIO
LORAIN COUNTY
S. S.

BEFORE ME, A NOTARY PUBLIC, IN AND FOR SAID COUNTY AND STATE PERSONALLY CAME EDWARD DEMETER, PRESIDENT AND JACK L. PIPER, VICE PRESIDENT OF THE K. D. CONSTRUCTION COMPANY, WHO DID ACKNOWLEDGE THE SIGNING OF THE ABOVE PLAT TO BE THEIR FREE ACT AND DEED.

IN WITNESS WHEREOF I HAVE SET MY HAND AND CAUSED MY OFFICIAL SEAL TO BE AFFIXED AT ELYRIA, OHIO THIS 21ST DAY OF OCTOBER, 1959

[Signature]
NOTARY PUBLIC

SURVEYOR'S CERTIFICATE:

THIS PLAT OF NORTHERN COURT ALLOTMENT MADE AT THE REQUEST OF K. D. CONSTRUCTION COMPANY OWNER OF LAND EMBRACED BY THE ABOVE PLAT SITUATED IN ORIGINAL LOT 4, EAST OF THE EAST BRANCH OF BLACK RIVER, ELYRIA TOWNSHIP, ELYRIA CITY, LORAIN COUNTY, STATE OF OHIO AND CONTAINS 1.786 ACRES OF LAND. ACERAGE IN LOTS - 1.370

I HAVE SURVEYED AND PLATTED SAID PREMISES AND HAVE FOUND OR SET IRON PINS AT ALL POINTS INDICATED THUS — DISTANCES ARE SHOWN IN FEET AND DECIMAL PARTS THEREOF.

ALL OF WHICH I CERTIFY TO BE CORRECT. OCTOBER 21, 1959

[Signature]
LAND SURVEYOR

OWNER'S CERTIFICATE:

WE THE UNDERSIGNED, OWNER'S OF LAND EMBRACED BY THE ABOVE PLAT, HEREBY ACCEPT THE SAME TO BE CORRECT AND DEDICATE TO PUBLIC USE FOR STREET PURPOSES, NORTHERN COURT 60 FEET IN WIDTH AND AS SHOWN HEREON.

IN TESTIMONY WHEREOF WE HAVE HEREUNTO SET OUR HANDS AT ELYRIA, OHIO - OCTOBER 21, 1959

WITNESS K. D. CONSTRUCTION COMPANY

PRESIDENT

VICE PRESIDENT

CITY ENGINEER'S CERTIFICATE:

THIS IS TO CERTIFY THAT I HAVE EXAMINED THE ABOVE PLAT AND I FIND THE SAME TO BE CORRECT AND SUFFICIENT MONUMENTS HAVE BEEN SET.

DATED: OCTOBER 21, 1959

[Signature]
CITY ENGINEER

THE ABOVE PLAT OF NORTHERN COURT ALLOTMENT WAS DULY APPROVED BY THE PLANNING COMMISSION OF THE CITY OF ELYRIA, OHIO, _____ 1959.

CLERK

[Signature]
PRESIDENT

THIS IS TO CERTIFY THAT THE ABOVE PLAT WAS APPROVED AND THE DEDICATION OF THE ABOVE NORTHERN COURT WAS ACCEPTED BY THE COUNCIL OF THE CITY OF ELYRIA, OHIO, BY ORDINANCE NO. _____ DULY PASSED FOR THAT PURPOSE ON THE _____ DAY OF _____ 1959

CLERK

[Signature]
MAYOR

10:42A.
Plat RECORD VOL 22
Lester R. Mitchell
m.e. 5
March 31 60
March 31 60
36
22-36

22/36