

SECTION "A"

THIS IS TO CERTIFY THAT THIS PLAT OF HIGHLAND ACRES No. 2 SECTION "A" ONLY, OUTLINED BY HEAVY LINE AND INCLUDING LOTS 31 THRU 56 INCLUSIVE LOTS 110 THRU 106 INCLUSIVE AMOUNTING TO 8.02 ACRES, WAS ACCEPTED AND APPROVED FOR RECORDING BY THE COUNCIL OF THE CITY OF ELYRIA, OHIO, BY ORDINANCE No. 41-101 PASSED THIS 20 DAY OF November 1961.

ACRES IN LOTS 5.767
ACRES IN STREETS 2.253

NOTE: THE BALANCE OF PLAT IS PROPOSED ONLY FOR FUTURE ACCEPTANCE.

Robert J. Horton Mayor
Robert J. Horton Clerk Of Council

HIGHLAND ACRES SUBD'N No. 2

PART OF O.L. No. 24, WEST OF RIVER
ELYRIA TWP. - ELYRIA CITY - LORAIN
COUNTY, OHIO
JUNE 1960
SCALE 1"=60'

BY
RAY E. HOLLIS
REG. ENG. AND SURVEYOR



OWNERS CERTIFICATE:

THIS IS TO CERTIFY THAT THE UNDERSIGNED, JOHN A. & MARY LOUISE THORNTON - ANTHONY J. & STELLA KUFKA - ROY E. & MARY A. WRAY - THOMAS J. & CAROL L. BLANCO - JOHN & HELEN L. KURPELY OWNERS OF LAND CONTAINED WITHIN THE ABOVE PLAT OF HIGHLAND ACRES SUBD'N No. 2, HEREBY ACCEPT THE SAME TO BE CORRECT.

- John A. Thornton* } SUB Lot No. 33
JOHN A. THORNTON } 2.056 Ac.
- Mary Louise Thornton*
- Anthony J. Kufka* } SUB Lot No. 51
ANTHONY J. KUFKA } 1.763 Ac.
- Stella Kufka*
- Roy E. Wray* } SUB Lot No. 45
ROY E. WRAY } 1.791 Ac.
- Mary A. Wray*
- Thomas J. Blanco* } SUB Lot No. 110
THOMAS J. BLANCO } 2.224 Ac.
- Carol L. Blanco*
- John Kurpely* } SUB Lot No. 41
JOHN KURPELY } 1.779 Ac.
- Heleen L. Kurpely*

STATE OF OHIO } ss.
COUNTY OF LORAIN }
BEFORE ME, A NOTARY PUBLIC IN AND FOR SAID COUNTY AND STATE DID PERSONALLY APPEAR JOHN A. & MARY LOUISE THORNTON ANTHONY J. & STELLA KUFKA - ROY E. & MARY A. WRAY - THOMAS J. & CAROL L. BLANCO - JOHN & HELEN L. KURPELY, OWNERS OF LANDS EMBRACED BY HIGHLAND ACRES SUB. No. 2 WHO ACKNOWLEDGED THAT THEY DID SIGN THE FOREGOING PLAT AND THAT WAS OF THEIR OWN FREE ACT AND DEED IN TESTIMONY WHEREOF I HAVE HEREUNTO SET MY HAND AND OFFICIAL SEAL ON THIS 16th DAY OF November 1961

Joseph E. Coughlione
NOTARY PUBLIC.
My Commission expires January 7, 1961.

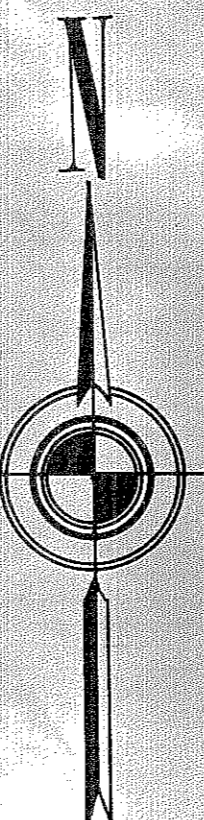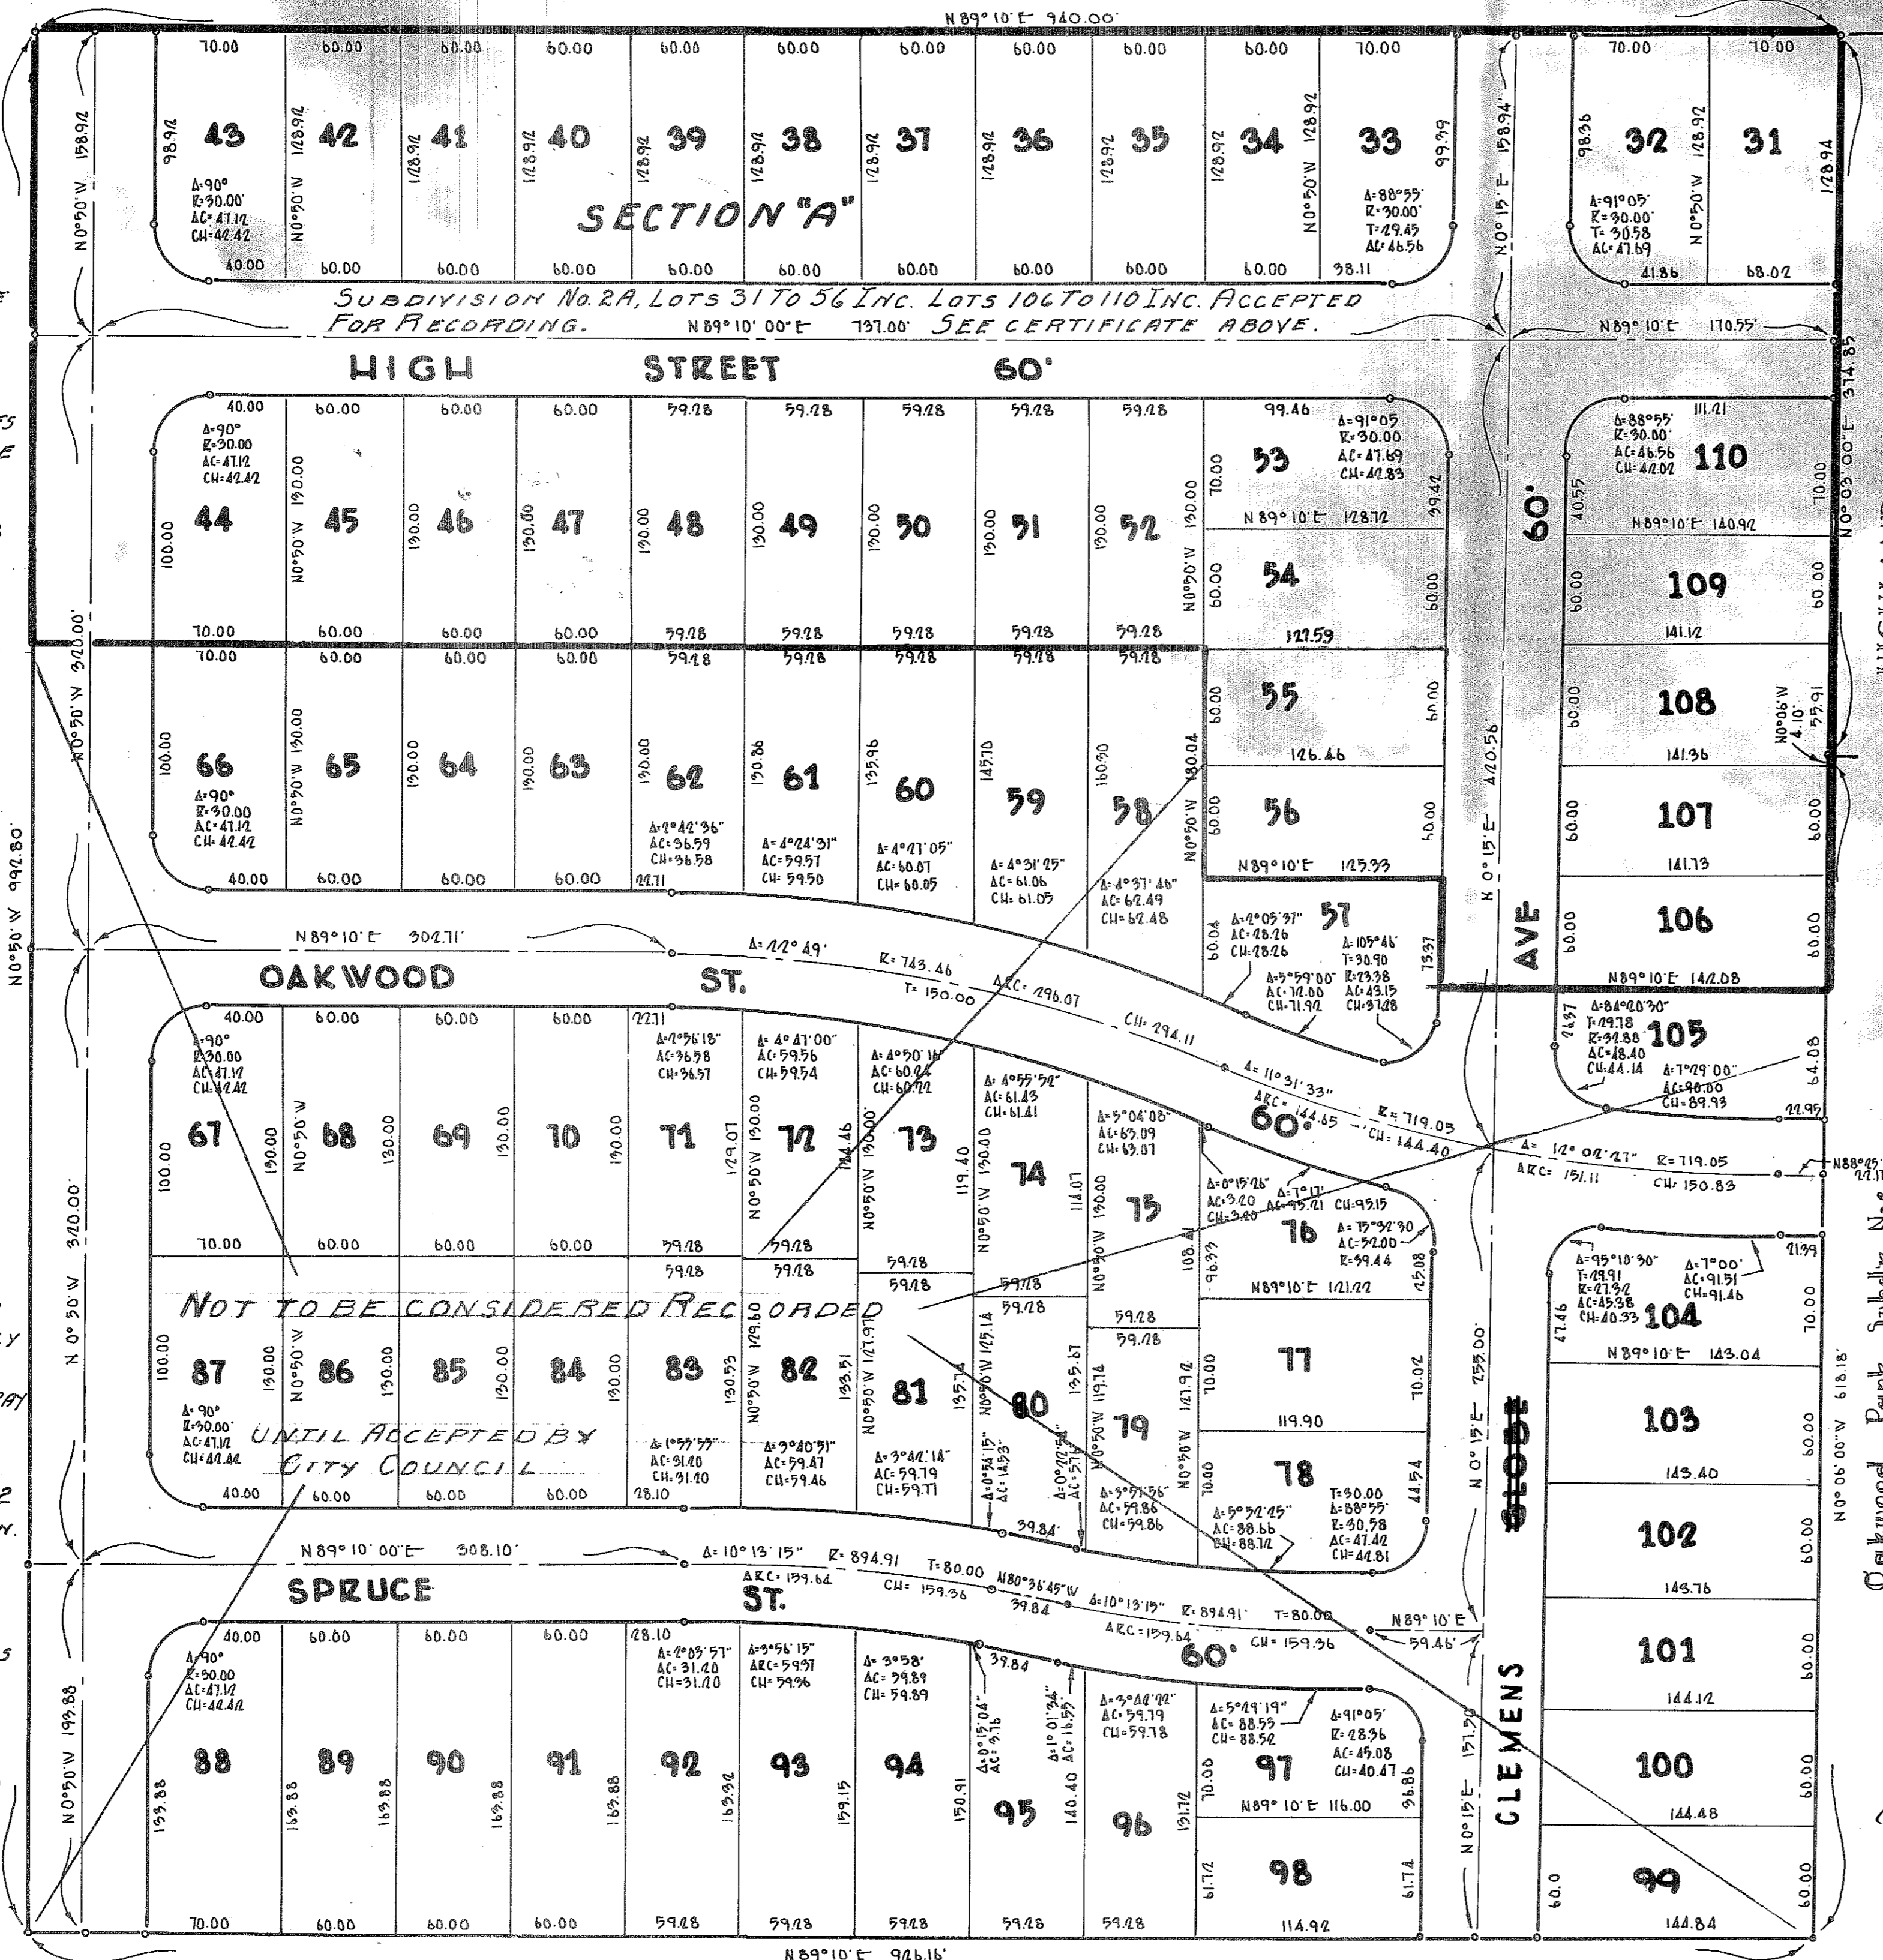

ENGINEERS CERTIFICATE:
THIS IS TO CERTIFY THAT AT THE ABOVE PLAT OF HIGHLAND ACRES SUBD'N No. 2 WAS MADE AT THE REQUEST OF THE OWNERS, HARRY A. DEMAS AND ANN M. DEMAS AND EMBRACING A TOTAL OF 8.02 ACRES IN O.L. No. 24, WEST OF RIVER ELYRIA TWP., ELYRIA CITY, LORAIN COUNTY, OHIO. AT ALL POINTS SO INDICATED IRON PIN MONUMENTS WERE FOUND OR SET. ALL DISTANCES ARE IN FEET AND DECIMAL PARTS THEREOF. ALL OF WHICH I CERTIFY TO BE CORRECT.

Ray E. Hollis
REG. ENG. AND SURVEYOR

2.253 - ACRES IN STREETS }
4.799 - ACRES IN LOTS } DEMAS

OWNERS CERTIFICATE:
THIS IS TO CERTIFY THAT WE THE UNDERSIGNED, HARRY A. DEMAS AND ANN M. DEMAS, OWNERS OF LANDS EMBRACED BY THE ABOVE PLAT OF HIGHLAND ACRES SUBD'N No. 2 HEREBY ACCEPT THE SAME TO BE CORRECT AND DEDICATE THE FOLLOWING TO PUBLIC USE, HIGH ST., AVE., AS SHOWN HEREON.

Harry A. Demas
HARRY A. DEMAS, OWNER

Ann M. Demas
ANN M. DEMAS, OWNER

STATE OF OHIO } ss.
COUNTY OF LORAIN }
BEFORE ME, A NOTARY PUBLIC IN AND FOR SAID COUNTY AND STATE PERSONALLY APPEARED THE ABOVE NAMED, HARRY A. DEMAS, AND ANN M. DEMAS, OWNERS OF LANDS CONTAINED WITHIN HIGHLAND ACRES SUBD'N No. 2 WHO ACKNOWLEDGED THAT THEY DID SIGN THE FOREGOING PLAT AND THAT IT WAS OF THEIR OWN FREE ACT AND DEED, IN TESTIMONY WHEREOF I HAVE UNTO SET MY HAND AND OFFICIAL SEAL AT Elyria, OHIO, ON THIS 16th DAY OF Nov 1961

Joseph E. Coughlione
NOTARY PUBLIC

MY COMMISSION EXPIRES January 7, 1962

THIS IS TO CERTIFY THAT THE ABOVE PLAT OF HIGHLAND ACRES No. 2 IS APPROVED ON THIS 14 DAY OF NOV 1961 BY THE PLANNING COMMISSION OF ELYRIA

J. J. Sereal
PRESIDENT

J. J. Sereal
SECRETARY

THIS IS TO CERTIFY THAT I HAVE EXAMINED THE FOREGOING PLAT AND HEREBY APPROVE THE SAME. I FIND THE MONUMENTS SET ARE SUFFICIENT TO DEFINE THE STREETS AS SHOWN.

R. C. Kinoshita
MUNICIPAL ENG. CITY OF ELYRIA

Frank Ague
Auditor

RECEIVED FOR RECORD
AT 12:50 P.M.
Nov 24 1961
Lorain County Recorder

ENTERED FOR TRANSFER
LORAIN COUNTY AUDITOR