


606055

CORRECTION DEED VOL. 821-223

606055

23/20

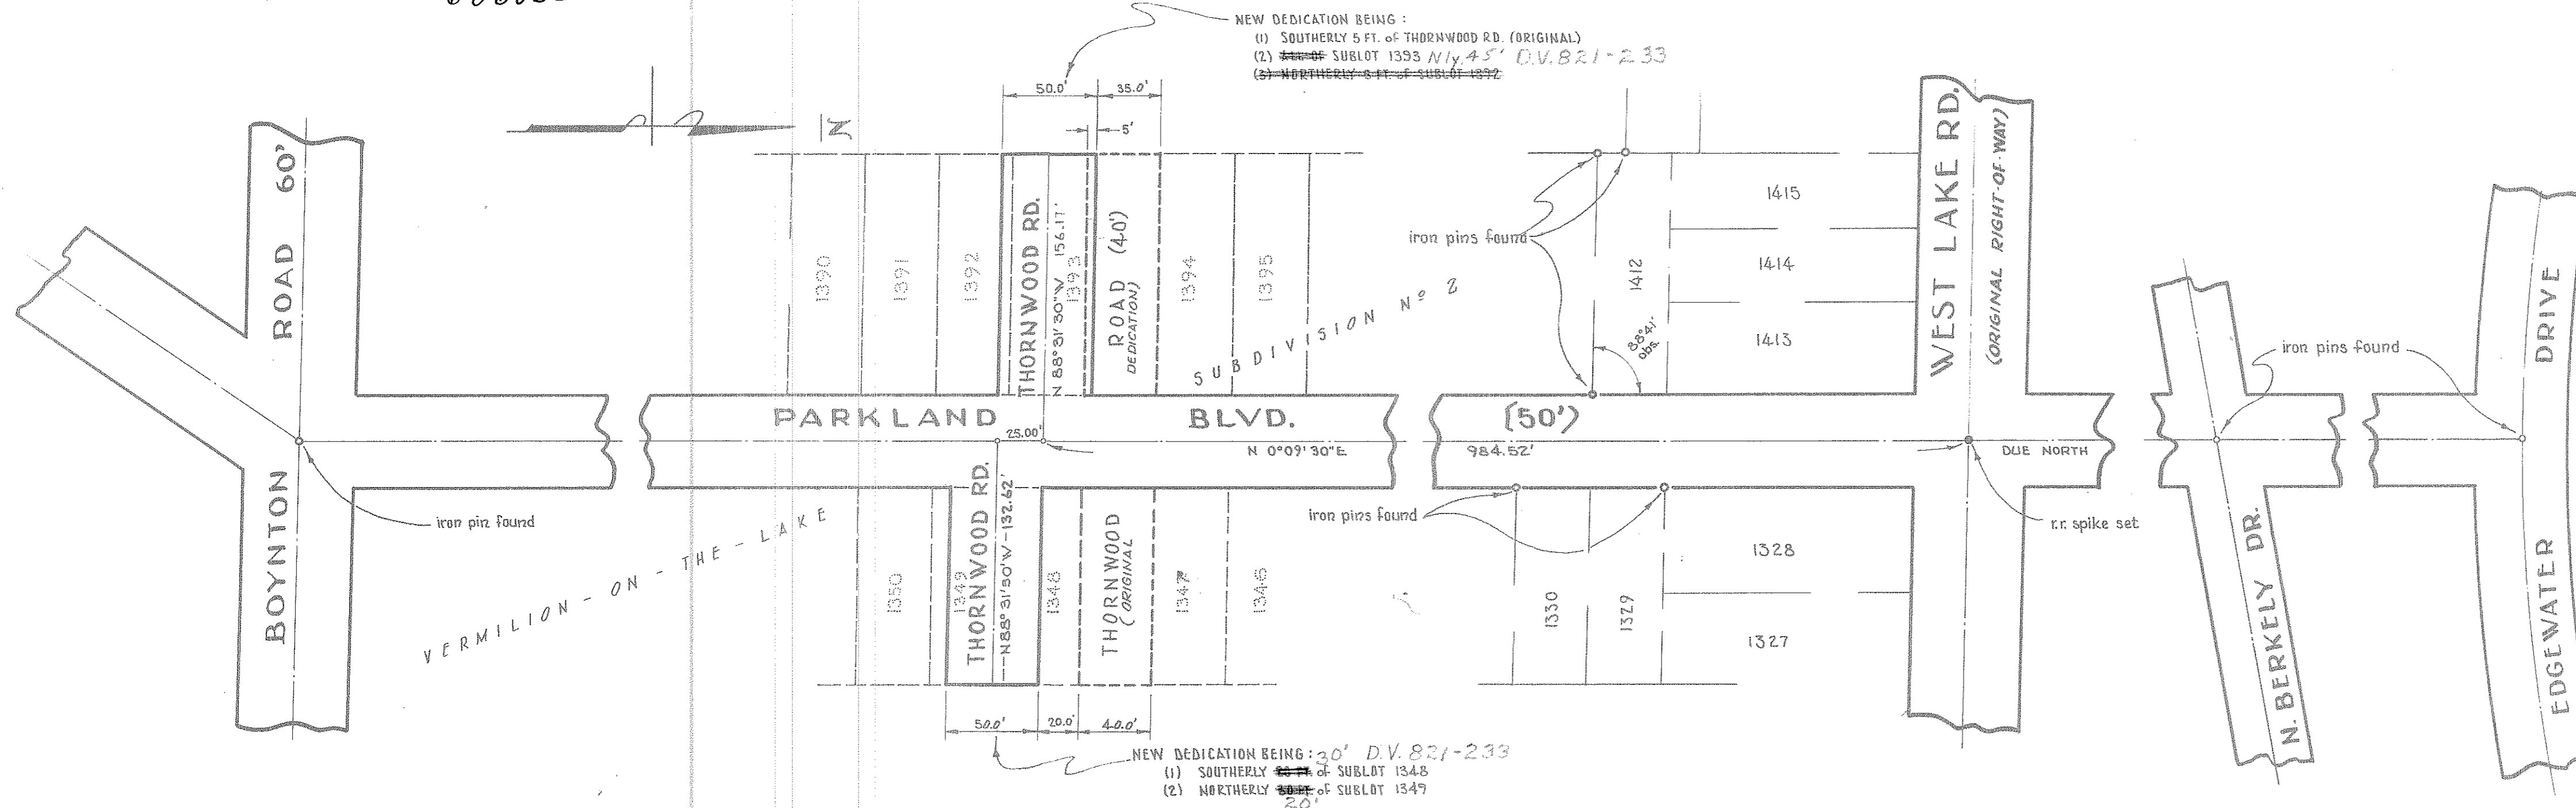

MORTGAGE RELEASE:

THIS IS TO CERTIFY THAT LANE PARK DEVELOPMENT INC., AS REPRESENTED BY GILBERT H. KINCHEN, PRESIDENT, AND ARTHUR M. KLIGLER, SECRETARY, HAVING EXAMINED THIS FOREGOING PLAT OF STREET DEDICATION DOES HEREBY DEDICATE FOREVER TO PUBLIC USE THORNWOOD ROAD AS SHOWN HEREON.

LANE PARK DEVELOPMENT, INC.

PRESIDENT

SECRETARY

COUNTY OF } SS:  
STATE OF OHIO

THIS IS TO CERTIFY THAT BEFORE ME, A NOTARY PUBLIC IN AND FOR SAID COUNTY AND STATE, DID PERSONALLY APPEAR THE ABOVE SIGNED OFFICERS OF LANE PARK DEVELOPMENT, INC., WHO ACKNOWLEDGED THE SIGNING OF THIS PLAT TO BE THEIR OWN FREE ACT AND DEED AND THE EXPRESSED WISHES OF THEIR COMPANY. IN TESTIMONY WHEREOF I HAVE HEREUNTO SET MY HAND AND OFFICIAL SEAL THIS 11th DAY OF July, 1961.

NOTARY PUBLIC

MY COMMISSION EXPIRES 10-25-1965

MORTGAGE RELEASE:

THIS IS TO CERTIFY THAT I, EPHREIM HOROWITZ, MORTGAGEE OF LANDS EMBRACED WITHIN THIS PLAT OF STREET DEDICATION, HAVING EXAMINED THIS FOREGOING PLAT, DO HEREBY ACCEPT THE SAME TO BE CORRECT AND DEDICATE FOREVER TO PUBLIC USE THORNWOOD ROAD AS SHOWN HEREON.

MORTGAGEE

COUNTY OF } SS:  
STATE OF OHIO

THIS IS TO CERTIFY THAT BEFORE ME, A NOTARY PUBLIC IN AND FOR SAID COUNTY AND STATE, DID PERSONALLY APPEAR THE ABOVE SIGNED EPHREIM HOROWITZ, MORTGAGEE OF LANDS EMBRACED WITHIN THIS FOREGOING PLAT OF STREET DEDICATION, AND THAT HE DID KNOWLEDGE THE SIGNING OF THIS PLAT TO BE HIS OWN FREE ACT AND DEED. IN TESTIMONY WHEREOF I HAVE HEREUNTO SET MY HAND AND OFFICIAL SEAL THIS 14th DAY OF July, 1961.

NOTARY PUBLIC

MY COMMISSION EXPIRES 1962

MORTGAGE RELEASE:

THIS IS TO CERTIFY THAT I, RUBY HAFF, MORTGAGEE OF LANDS EMBRACED WITHIN THIS PLAT OF STREET DEDICATION, HAVING EXAMINED THIS FOREGOING PLAT, DO HEREBY ACCEPT THE SAME TO BE CORRECT AND DEDICATE FOREVER TO PUBLIC USE THORNWOOD ROAD AS SHOWN HEREON.

MORTGAGEE

COUNTY OF } SS:  
STATE OF ILLINOIS

THIS IS TO CERTIFY THAT BEFORE ME, A NOTARY PUBLIC IN AND FOR SAID COUNTY AND STATE, DID PERSONALLY APPEAR THE ABOVE SIGNED RUBY HAFF, MORTGAGEE OF LANDS EMBRACED WITHIN THIS FOREGOING PLAT OF STREET DEDICATION, AND THAT SHE DID ACKNOWLEDGE THE SIGNING OF THIS PLAT TO BE HER OWN FREE ACT AND DEED. IN TESTIMONY WHEREOF I HAVE HEREUNTO SET MY HAND AND OFFICIAL SEAL THIS 2nd DAY OF July, 1961.

NOTARY PUBLIC

MY COMMISSION EXPIRES 1961

23/20

SURVEYOR'S CERTIFICATE:

THIS IS TO CERTIFY THAT AT THE REQUEST OF THE OWNER OF THOSE PARTS OF VERMILION-ON-THE-LAKE SUBDIVISION No 2 CONCERNED, WE HAVE PREPARED THIS FOREGOING PLAT FOR DEDICATION. MEASUREMENTS AND BEARINGS SHOWN ARE BASED ON INFORMATION RECORDED BY THE PLAT OF SAID SUBDIVISION No 2, RECORDED IN VOLUME 10, PAGE 20 OF LORAIN COUNTY PLAT RECORDS, AND ADDITIONAL FIELD OBSERVATIONS MADE BY US.

R. E. WARNER AND ASSOCIATES

Michael S. Warner

REGISTERED SURVEYOR

PLANNING COMMISSION:

APPROVED BY THE VILLAGE PLANNING COMMISSION FOR RECORDING PURPOSES ONLY ON THIS 21st DAY OF July, 1961.

SECRETARY

PRESIDENT

VILLAGE ENGINEER:

APPROVED BY THE VILLAGE ENGINEER FOR RECORDING PURPOSES ONLY ON THIS 7th DAY OF July, 1961.

John N. Ochs

VILLAGE ENGINEER

VILLAGE COUNCIL:

THIS IS TO CERTIFY THAT THIS PLAT OF STREET DEDICATION OF THORNWOOD ROAD BEING WITHIN THAT AREA KNOWN AS VERMILION-ON-THE-LAKE SUBDIVISION No 2, BROWNHELM TOWNSHIP, NOW WITHIN THE CORPORATE LIMITS OF THE VILLAGE OF VERMILION, OHIO, WAS APPROVED AND ACCEPTED BY THE VILLAGE COUNCIL OF VERMILION FOR RECORDING PURPOSES ONLY ON THIS 16th DAY OF OCTOBER 1961.

VILLAGE MAYOR

VILLAGE COUNCIL CLERK

OWNER'S CERTIFICATE:

THIS IS TO CERTIFY THAT THE SHORE PARK BUILDING COMPANY, OWNER OF LANDS CONTAINED WITHIN THIS PLAT FOR STREET DEDICATION, AS REPRESENTED BY THE UNDER-SIGNED OFFICERS, DOES HEREBY ACCEPT THIS FOREGOING PLAT TO BE CORRECT AND DEDICATE FOREVER TO PUBLIC USE THORNWOOD DRIVE AS SHOWN HEREON.

SHORE PARK BUILDING COMPANY

PRESIDENT

COUNTY OF } SS:  
STATE OF OHIO

THIS IS TO CERTIFY THAT BEFORE ME, A NOTARY PUBLIC IN AND FOR SAID COUNTY AND STATE, DID PERSONALLY APPEAR THE ABOVE SIGNED OFFICERS OF THE SHORE PARK BUILDING COMPANY, WHO ACKNOWLEDGED THE SIGNING OF THIS PLAT TO BE THEIR OWN FREE ACT AND DEED AND THE EXPRESSED WISHES OF THEIR COMPANY. IN TESTIMONY WHEREOF I HAVE HEREUNTO SET MY HAND AND OFFICIAL SEAL THIS 17th DAY OF July, 1961.

NOTARY PUBLIC

MY COMMISSION EXPIRES 10-15-1962

RECEIVED FOR RECORD February 1, 1962  
AT 2:15 P. M. RECORDED Feb 1, 1962  
IN Plat RECORD, VOL. 23 PAGE 20  
Leta B. Mitchell  
LORAIN COUNTY RECORDER

Fee 6.00 m.c.

ENTERED FOR TRANSFER ON \_\_\_\_\_, 196\_. TRANSFERRED ON \_\_\_\_\_, 196\_.

LORAIN COUNTY AUDITOR

RECEIVED FOR RECORDING THIS \_\_\_\_\_ DAY OF \_\_\_\_\_, 196\_ AT \_\_\_\_\_ O'CLOCK \_\_\_\_\_ M. RECORDED IN VOLUME \_\_\_\_\_, PAGE \_\_\_\_\_ OF LORAIN COUNTY RECORD OF PLATS.

LORAIN COUNTY RECORDER

STREET DEDICATION

— THORNWOOD ROAD —

PART OF VERMILION-ON-THE-LAKE SUBDIVISION 2 ORIGINAL LOTS No's 2 & 3 OF BROWNHELM TOWNSHIP LORAIN COUNTY, OHIO

SCALE: 1"=60' JULY, 1961

BY

R. E. WARNER & ASSOC.  
ENGINEERS AND SURVEYORS