


QUAN	STATION	LOCATION	IDENTIFICATION
1	1262.00		
1	1270.00		
1	1277.19.07		Lot Corner
1	1285.87.65		(E. Prop. S.R. 254 & 26 INT.)
1	1294.00		
1	1301.35.81		(E.G. S.R. 254 & 26 INT.)
1	1309.00		
1	1318.44.59		PCC
1	1328.24.45		PCC
1	1332.84.45		PCC
1	1337.85.21		PT
1	1339.19.06		PCC
1	1341.94.57		PCC
1	1346.61.00		PCC
1	1349.61.01		PCC
1	1350.44.54		PCC
1	1353.11.07		PT
1	1362.00		
1	1370.00		
1	1379.72		S. Survey (EX. P.I.)
1	1383.00		S. Survey
1	1391.90.44		A-35 LY (EX. P.I.)
1	1391.90.59		P.I.
1	1400.00		S. Survey
1	1410.00		S. Survey
1	1420.00		S. Survey
1	1429.25.78		MONUMENT ASSEMBLY
1	1439.59.81		MONUMENT ASSEMBLY
1	1463.38.04		MONUMENT ASSEMBLY
1	1472.00		MONUMENT ASSEMBLY

QUAN	STATION	LOCATION	IDENTIFICATION
1	1348.46.29	P.I. OF C	3.0 FT. PI E. OF EX. R/W
1		REFERENCE MONUMENTS	(AS PER PLAN) (SEE SHEET 2)














NOTE:
SPECIAL MONUMENT ASSEMBLIES AS SHOWN ON SHEET NO. 11 OF THE CONSTRUCTION PLAN ARE TO BE PLACED DURING CONSTRUCTION IN THE 1571 PARCELS & OFFICE THE LEVELING COURSE & PEGS TO PLACING THE SURFACE COURSE ON THE PARCELS.
ALL MONUMENTS ARE TO BE PLACED UNDER THE DIRECTION OF THE PROJECT ENGINEER.

LOCATION PLAN
LEAVITT ROAD
LOR-58-(23.81-24.66) 649704
CITY OF AMHERST AND LORAIN
AMHERST TWP. ORIGINAL LOTS 39, 40, 41 & 42.
BLACK RIVER TWP. ORIGINAL LOTS 3, 7, 8, 13, 14, 17, 18, 23 & 24.
LORAIN COUNTY

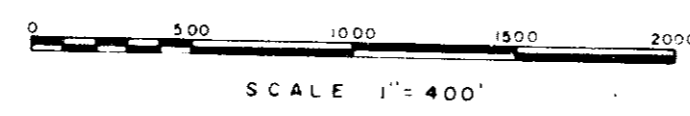

RECEIVED April 27 1964
RECORDED April 27 1964
BOOK 23 PAGE 94
Leta B. Mitchell
LORAIN COUNTY RECORDER
m.c. 900

SIGNED *D.A. Commey*
DIVISION DEPUTY DIRECTOR
DATE 4-14-64

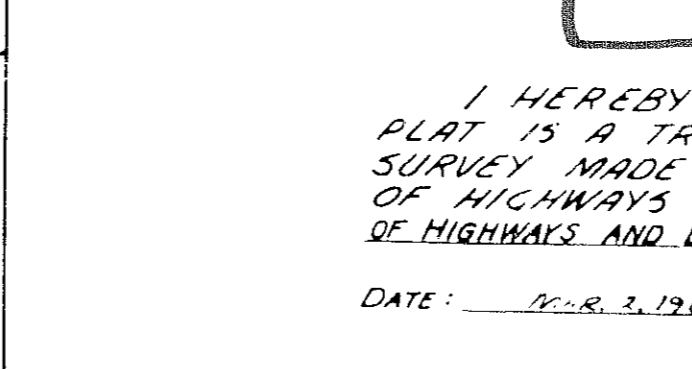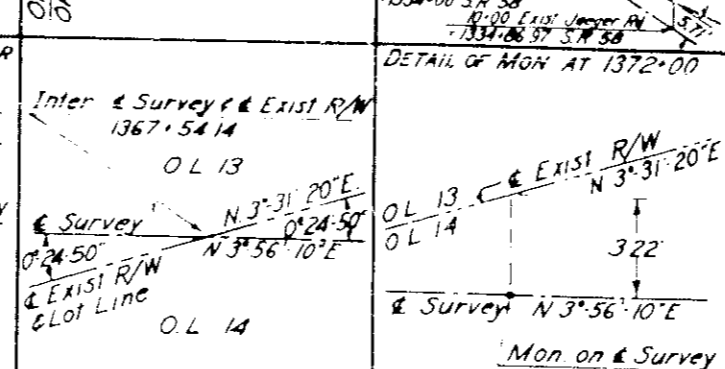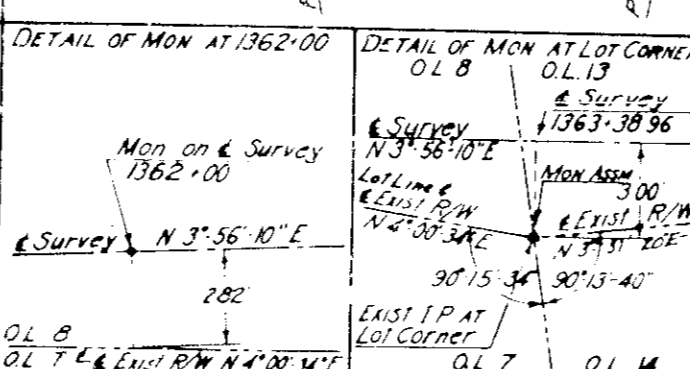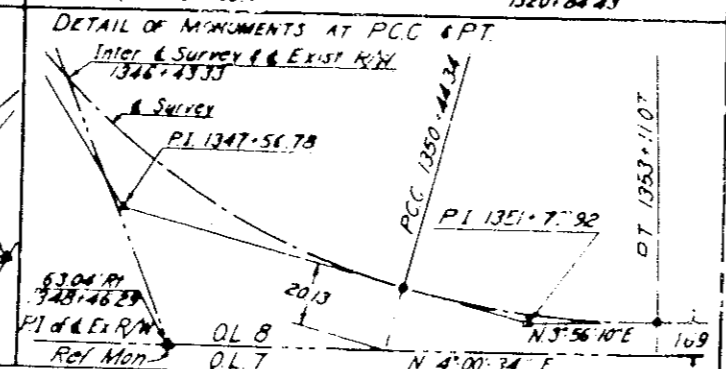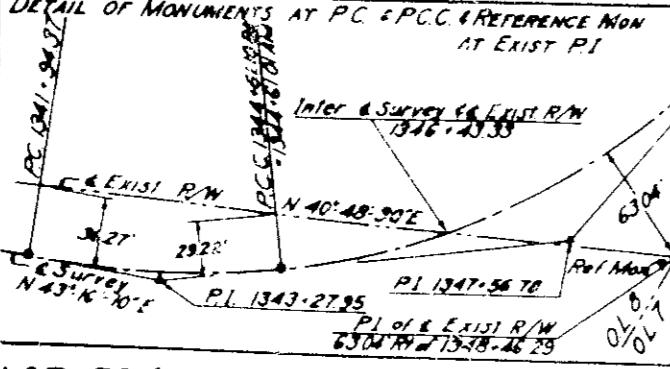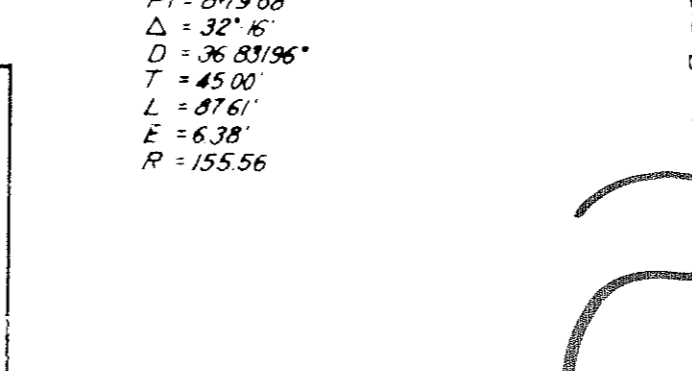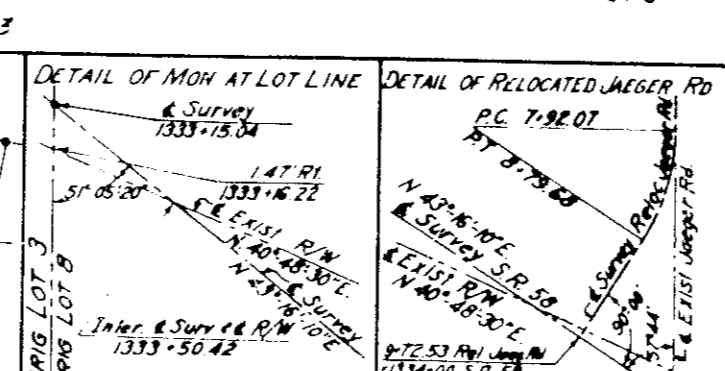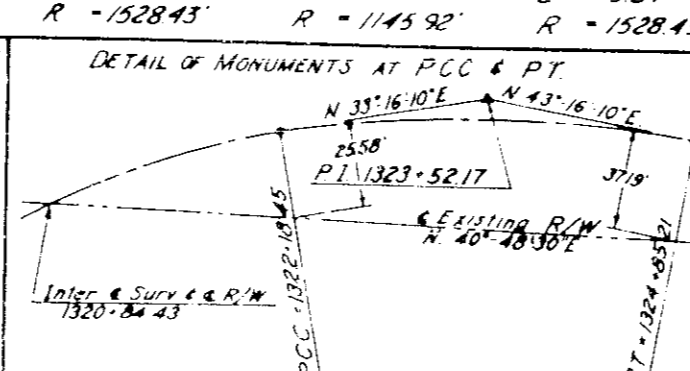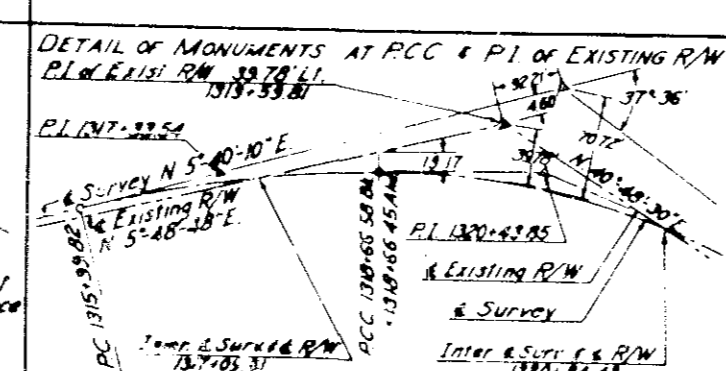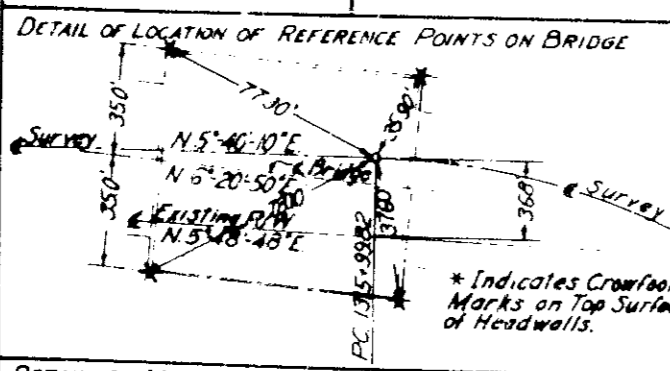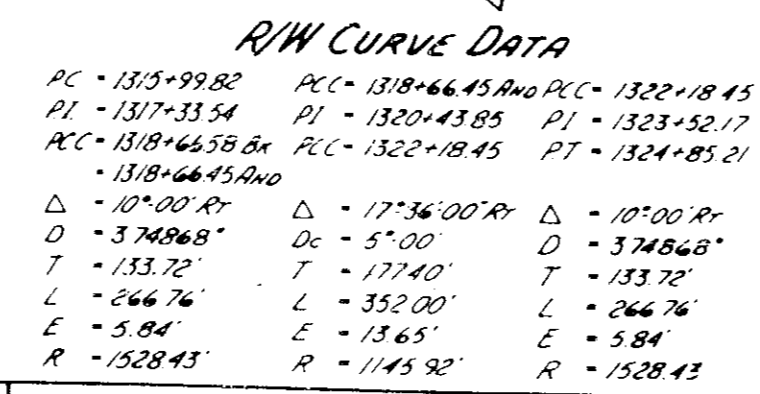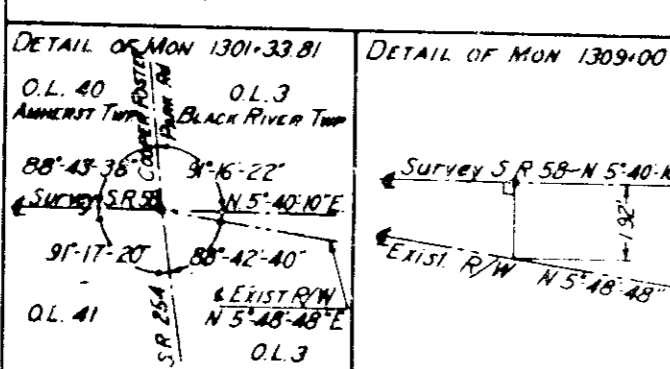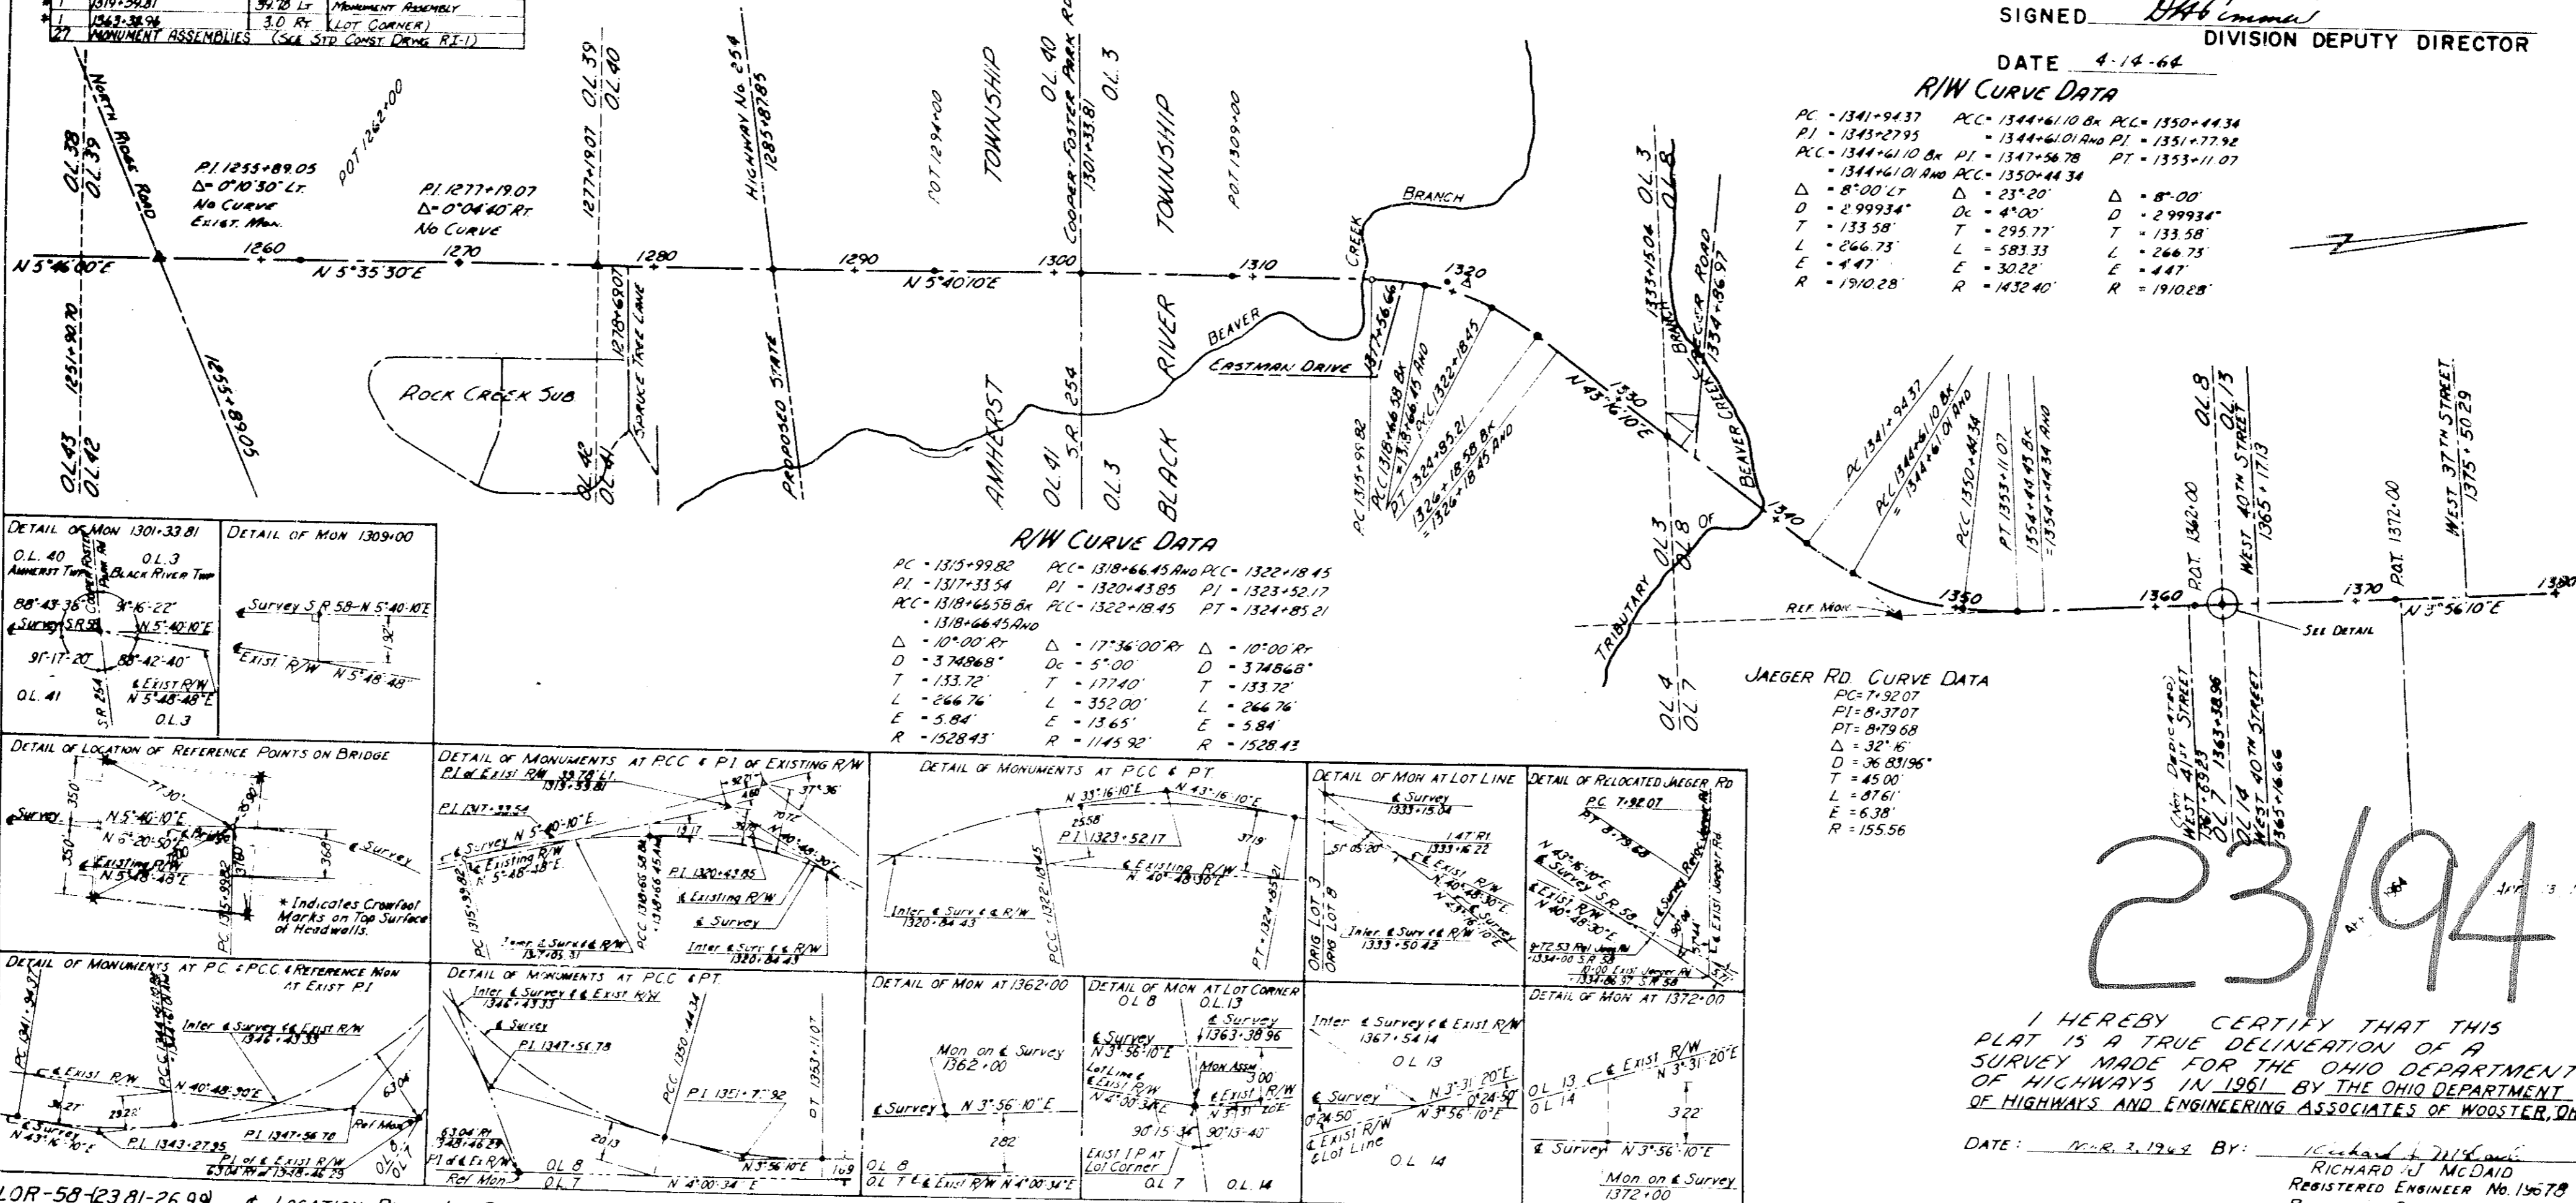

23/94

I HEREBY CERTIFY THAT THIS PLAT IS A TRUE DELINEATION OF A SURVEY MADE FOR THE OHIO DEPARTMENT OF HIGHWAYS IN 1961 BY THE OHIO DEPARTMENT OF HIGHWAYS AND ENGINEERING ASSOCIATES OF WOOSTER, OHIO.
RICHARD H. MCDAID
REGISTERED ENGINEER No. 15678
REGISTERED SURVEYOR No. 5009

LOR-58-(23.81-26.99) & LOCATION PLAN 1 of 2

COPY

23/94



2	OHIO	
---	------	--

143
156

LORAIN COUNTY
LOR 58-(23.81-24.66)

649704

LOCATION PLAN
LEAVITT ROAD
LOR-58-(23.81-24.66)
CITY OF AMHERST AND LORAIN
AMHERST TWP ORIGINAL LOTS 39, 40, 41 & 42.
BLACK RIVER TWP ORIGINAL LOTS 3, 7, 8, 13, 14, 17, 18, 23 & 24.
LORAIN COUNTY

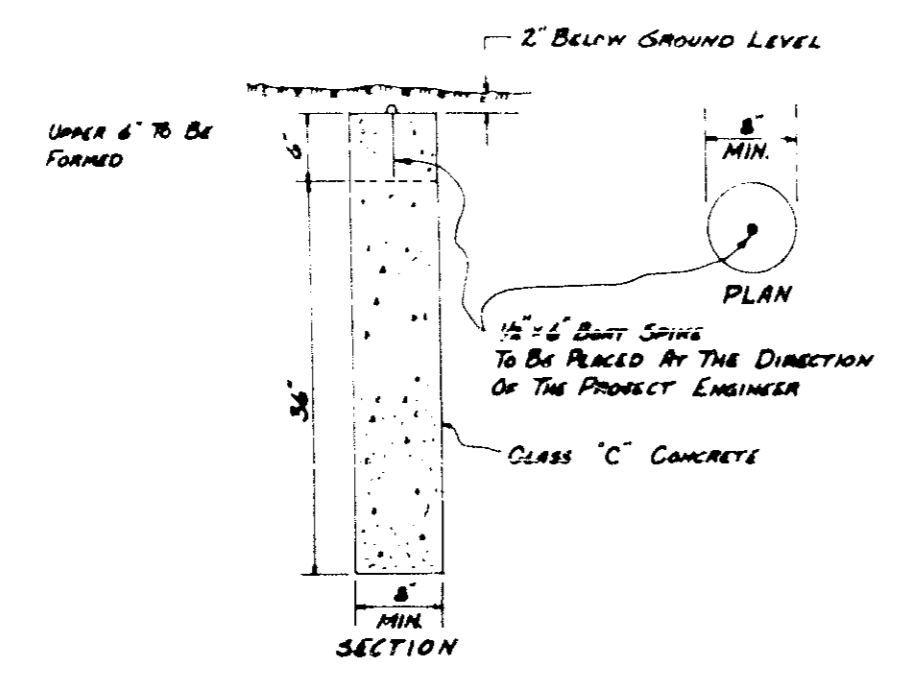
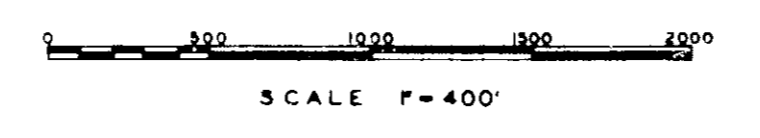


RECEIVED April 27 1964
RECORDED April 27 1964
BOOK 23 PAGE 94
Leota B. Mitchell
LORAIN COUNTY RECORDER

SIGNED [Signature]
DIVISION DEPUTY DIRECTOR
DATE 4-14-64

R/W CURVE DATA
PI = 1420+14.50
PT = 1422+55.12
Δ = 1° 17' 41"
D = 0° 16'
T = 240.63'
L = 481.25'
E = 1.35'
R = 21,485.92'

R/W CURVE DATA
PC = 1389+57.96
PI = 1391+98.59
PT = 1394+39.21
Δ = 1° 17' 41"
D = 0° 16'
T = 240.63'
L = 481.25'
E = 1.35'
R = 21,485.92'

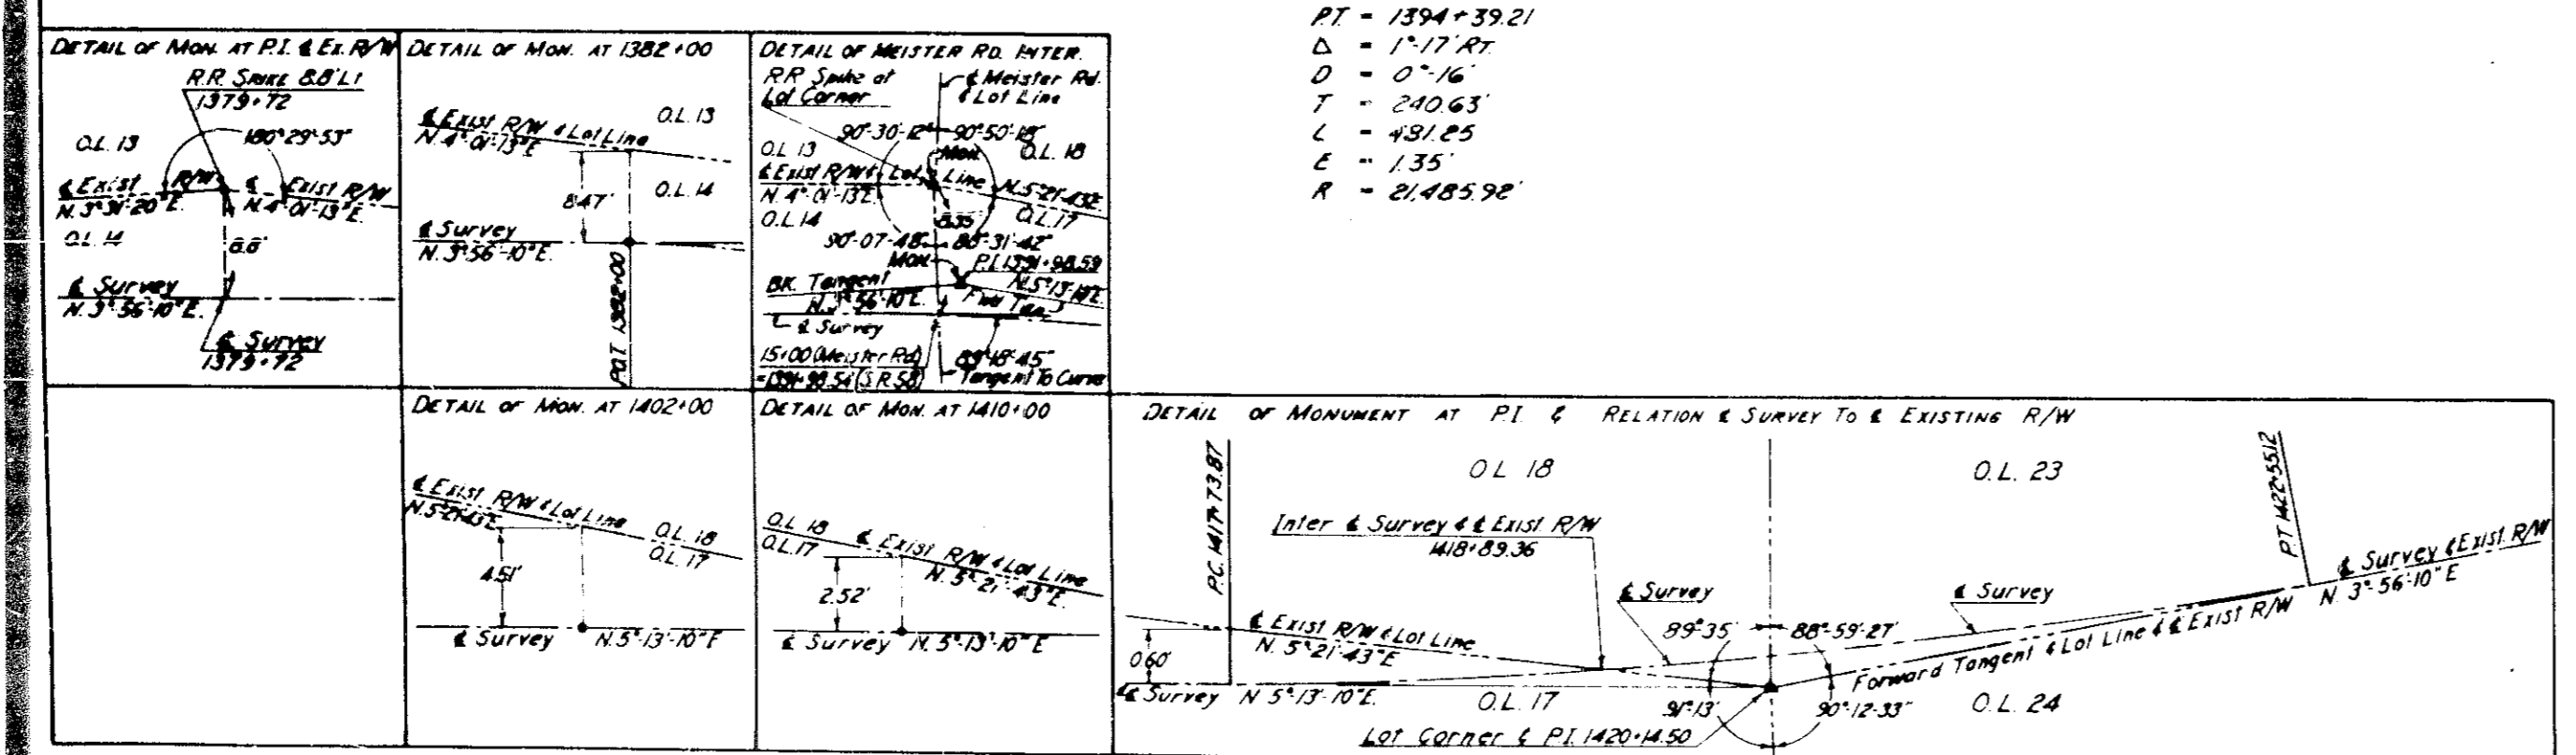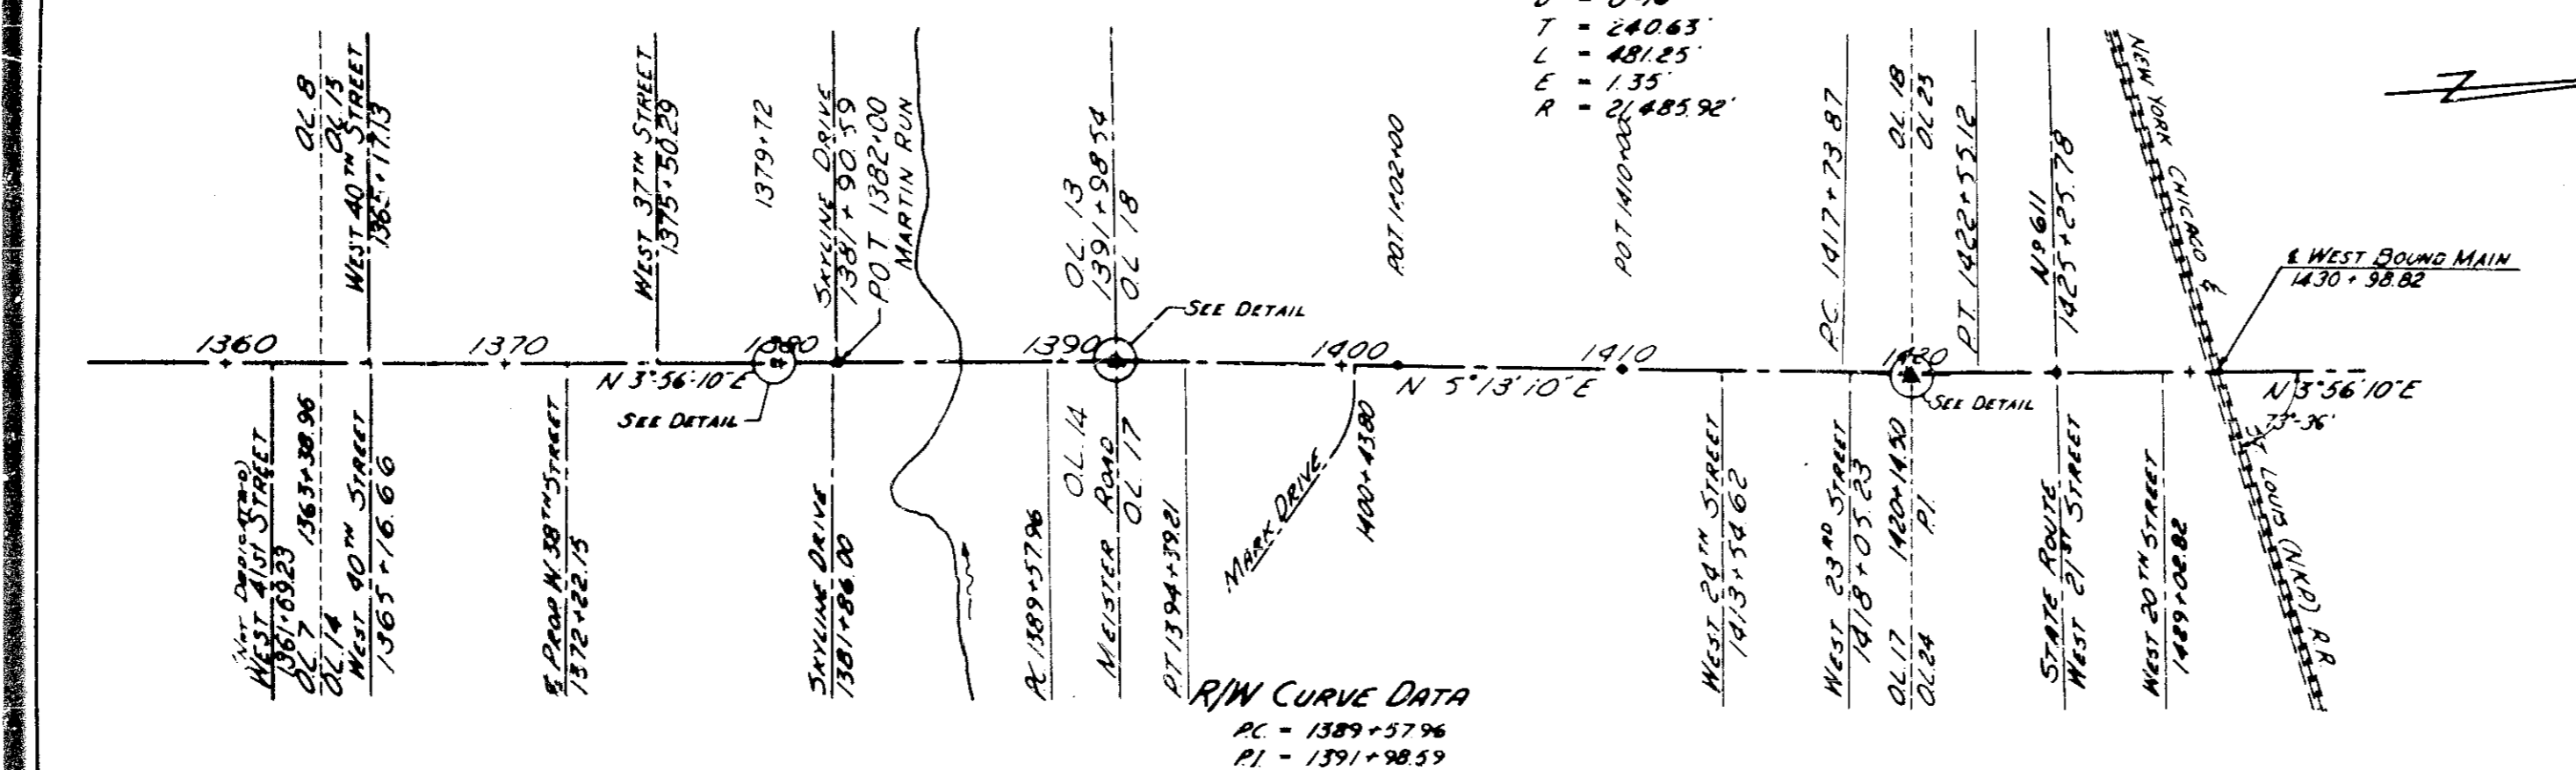

LOR-58-23.81 & LOCATION PLAN 2 OF 2

23/94

I HEREBY CERTIFY THAT THIS PLAT IS A TRUE DELINEATION OF A SURVEY MADE FOR THE OHIO DEPARTMENT OF HIGHWAYS IN 1961 BY THE OHIO DEPARTMENT OF HIGHWAYS AND ENGINEERING ASSOCIATES OF WOOSTER, OHIO
DATE: MAR 2 1964 BY: [Signature]
RICHARD J. MC DAID
REGISTERED ENGINEER NO. 19678...
REGISTERED SURVEYOR NO. 5003

COPY

23/94