


741344

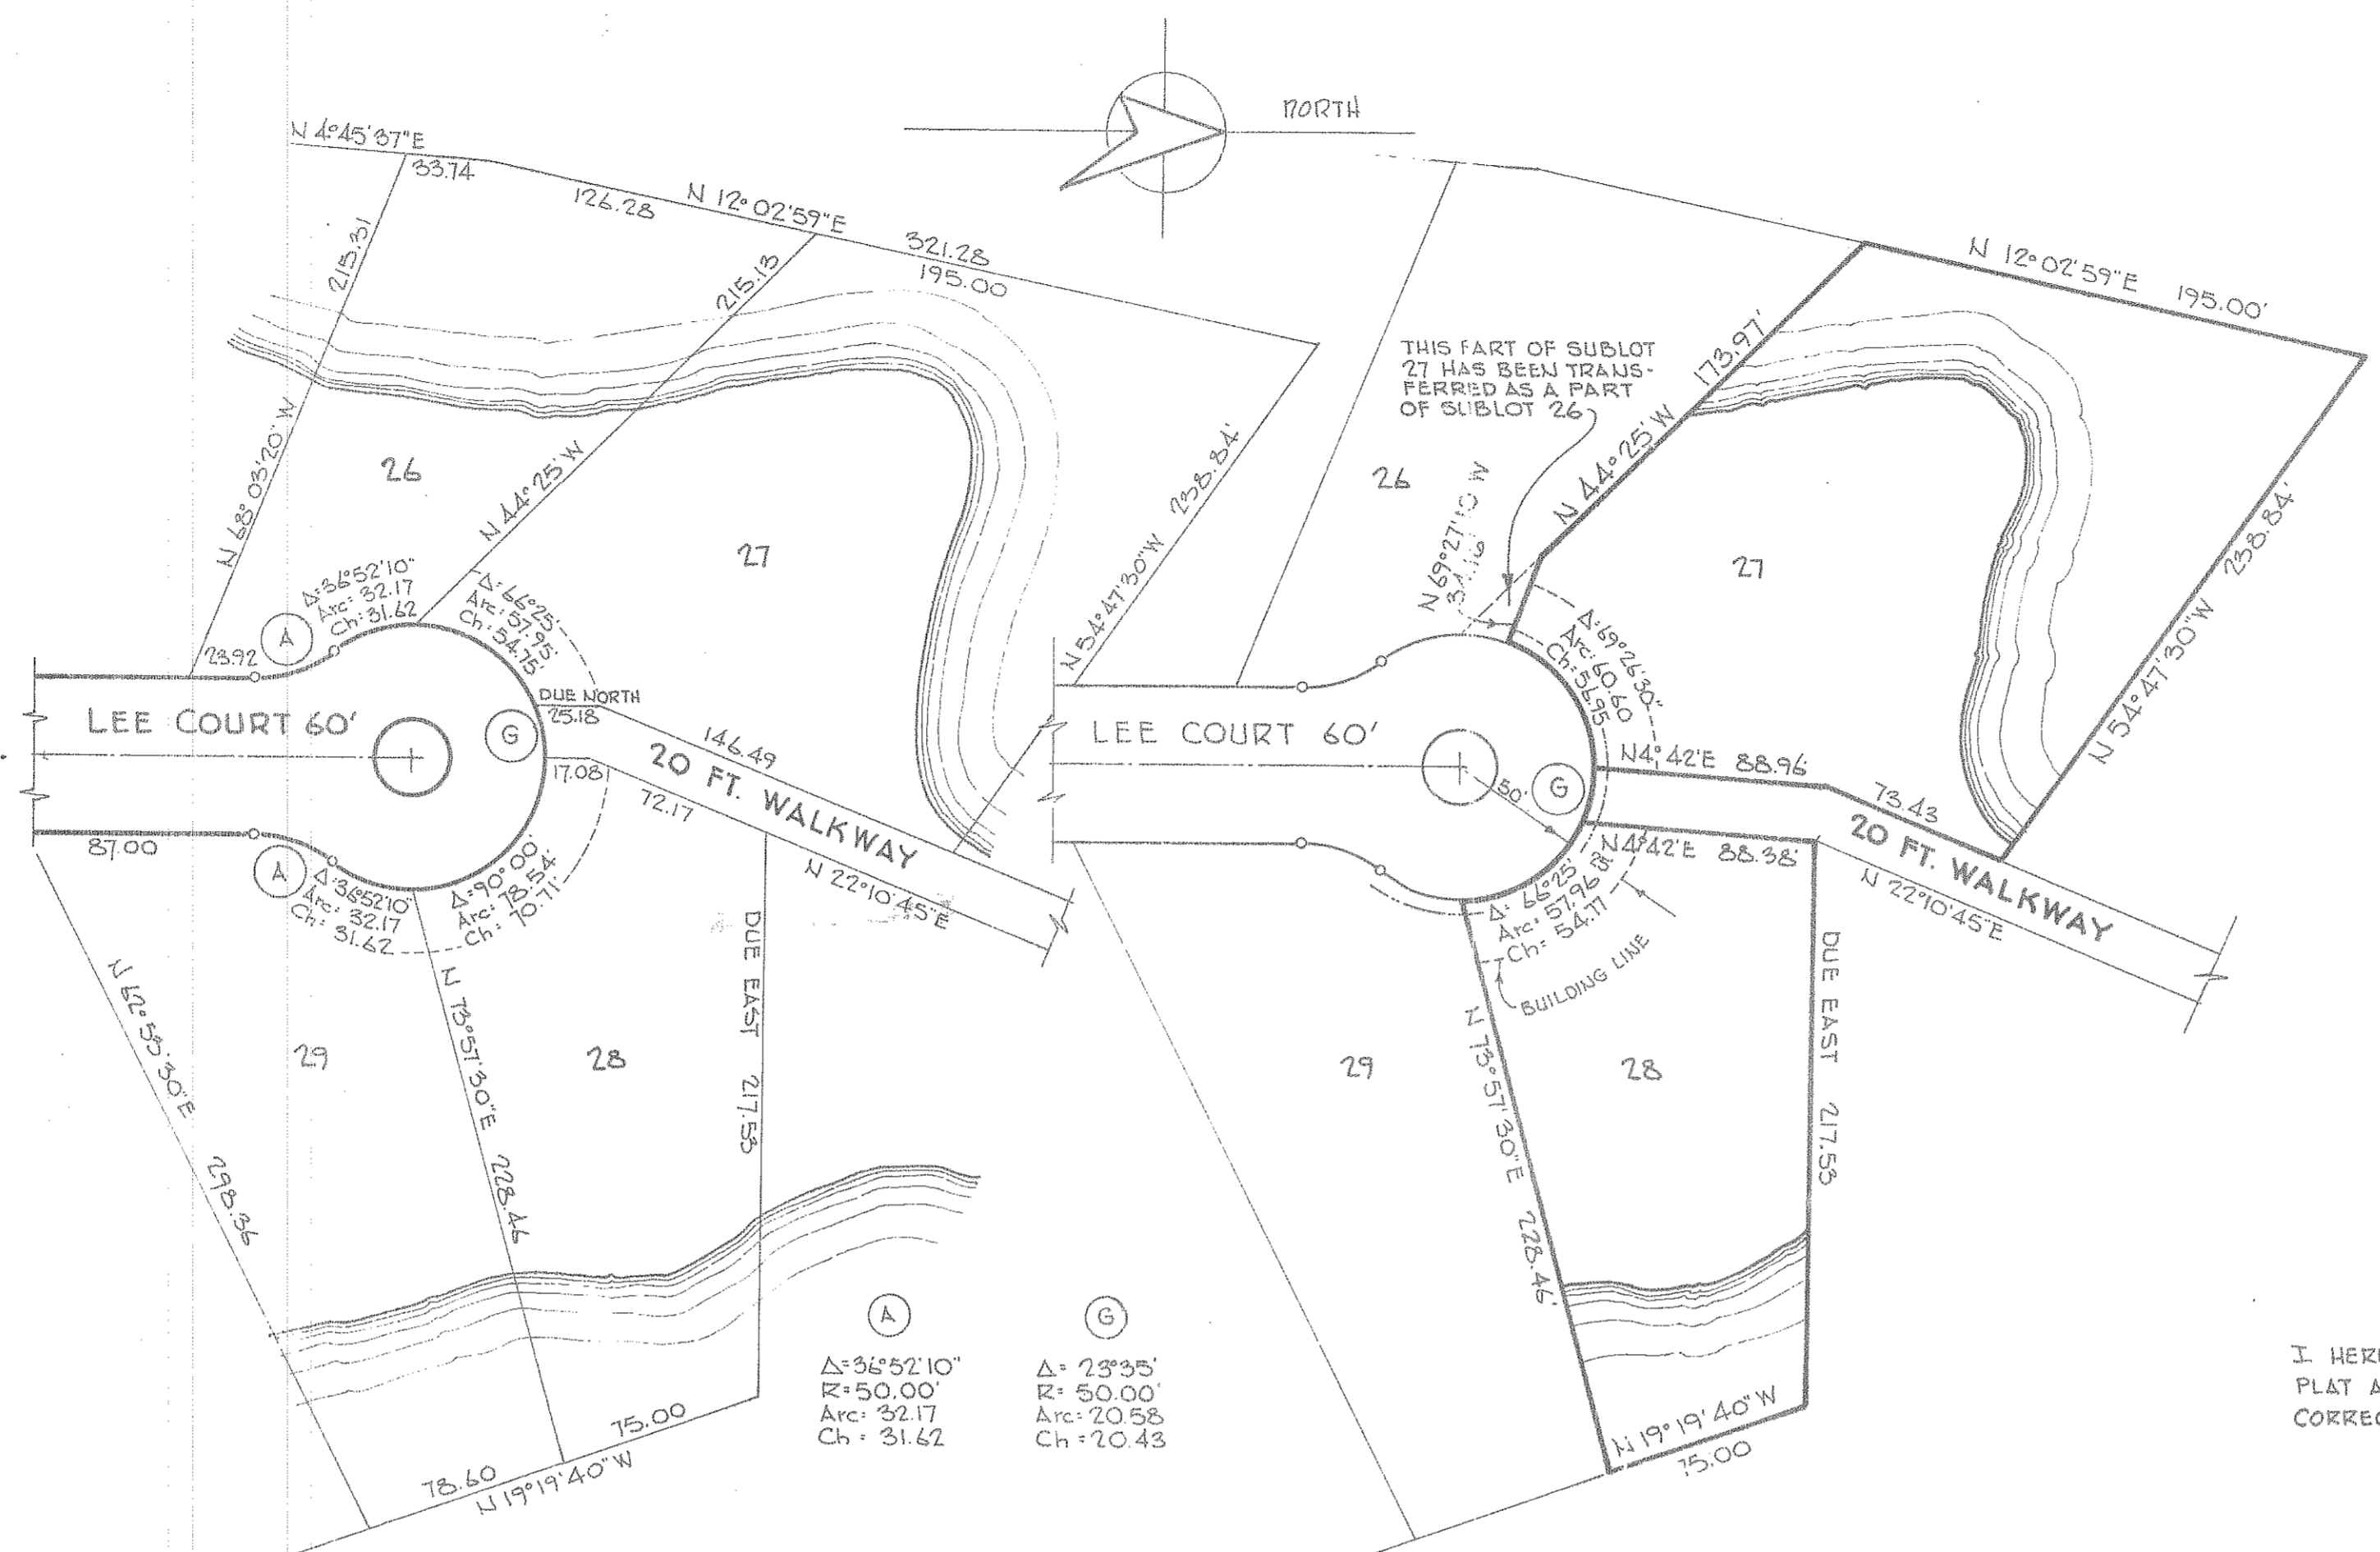

THIS IS TO CERTIFY THAT, AS PETITIONED TO THE COUNCIL OF THE CITY OF VERMILION, OHIO, IN ORDER TO MAKE THE DIMENSIONS ALONG THE BUILDING LINES OF SUBLOTS 27 AND 28 OF LAKE HAVEN ESTATES NO. 1 MORE NEARLY EQUAL AND MORE SUITABLE FOR CONSTRUCTION, THE RELOCATION OF THE 20 FT. WALKWAY IS NECESSARY. THE COUNCIL, IN GRANTING PERMISSION TO RELOCATE SAID WALKWAY, HAS CAUSED US TO EFFECT THIS PLAT OF THE SAME, ALONG WITH THE ESTABLISHMENT OF THE REVISED DIMENSIONS FOR SUBLOTS 27 AND 28.

OWNER: L & K, INC.

LeRoy DeLoe
PRESIDENT
Kenneth Rosenbush
SECRETARY

I HEREBY CERTIFY THAT I HAVE PLATTED THIS FOREGOING PLAT AND THAT THE BEARINGS AND DISTANCES SHOWN ARE CORRECT.

Michael G. Hura
REGISTERED SURVEYOR

WALKWAY, SUBLOTS 27 & 28
AS RECORDED

WALKWAY, SUBLOTS 27 & 28
AS REVISED BY THIS PLAT

PLANNERS
REGISTERED SURVEYORS

RECORD OF ORDINANCES
ORDINANCE NO. 68-35 PASSED MAY 20, 1968
AN ORDINANCE TO ACCEPT FOR RECORDING PURPOSES ONLY A CHANGE TO THE PLAT OF THE LAKE HAVEN ESTATES SUBDIVISION NO. 1 WHICH WAS ORIGINALLY ACCEPTED BY THE COUNCIL OF THE CITY OF VERMILION ON DECEMBER 6, 1965, THE SAME BEING ORDINANCE NO. 65-105.
BE IT ORDAINED THAT THE CITY OF VERMILION, STATE OF OHIO, SECTION I., THAT THE PLAT OF LAKE HAVEN ESTATES SUBDIVISION NO. 1 OF A PART OF ORIGINAL BROWNHELM TOWNSHIP LOT NO. 5 WHICH WAS ACCEPTED FOR RECORDING PURPOSES ONLY BY THE COUNCIL OF THE CITY OF VERMILION, OHIO ON DECEMBER 6, 1965, THE SAME BEING ORDINANCE NO. 65-105 WHICH IS HEREBY AMENDED PER EXHIBITS "A" AND "B" ATTACHED HERETO, SECTION II., THIS ORDINANCE SHALL GO INTO FULL FORCE FROM AND IMMEDIATELY AFTER THE EARLIEST PERIOD ALLOWED BY LAW.
PASSED 5/20/68 ARTHUR CROW, JR. PRESIDENT OF COUNCIL
ATTEST MAY 20, 1968 K. KYLE KONNERTH CLERK OF COUNCIL
APPROVES 5/20/68 JOHN W. MAIDEN MAYOR

THIS IS TO CERTIFY THAT THE TEXT OF THE ORDINANCE SHOWN HEREON IS A TRUE AND ACCURATE REPRESENTATION OF ORDINANCE NO. 68-35, PASSED BY THE COUNCIL OF THE CITY OF VERMILION, OHIO ON MAY 20, 1968.

PRESIDENT OF COUNCIL *Arthur Crow, Jr.*
CLERK OF COUNCIL *K. Kyle Konnerth*
DIRECTOR OF LAW *Samuel J. Gellert*

RECEIVED FOR RECORDING ON THIS 10 DAY OF February 1969 AT 2:44 o'clock P.M. RECORDED ON 5-10-69 IN VOLUME 25 PAGE 88 OF LORAIN COUNTY PLAT RECORDS.

Edna B. Mitchell
LORAIN COUNTY RECORDER

#432

A PLAT TO RELOCATE THE PUBLIC WALKWAY AND ESTABLISH NEW LOT DIMENSIONS OF A PART OF LAKE HAVEN ESTATES

No. 1

(RECORDED IN PLAT VOL. 24, PAGE 49)

PART OF ORIGINAL LOT 5 OF BROWNHELM TOWNSHIP NOW WITHIN THE CORPORATE LIMITS OF THE CITY OF VERMILION, LORAIN COUNTY, OHIO SCALE 1"=60' - OCTOBER, 1968

By MICHAEL G. HURA, REGISTERED SURVEYOR

#741344