25/89

25/89

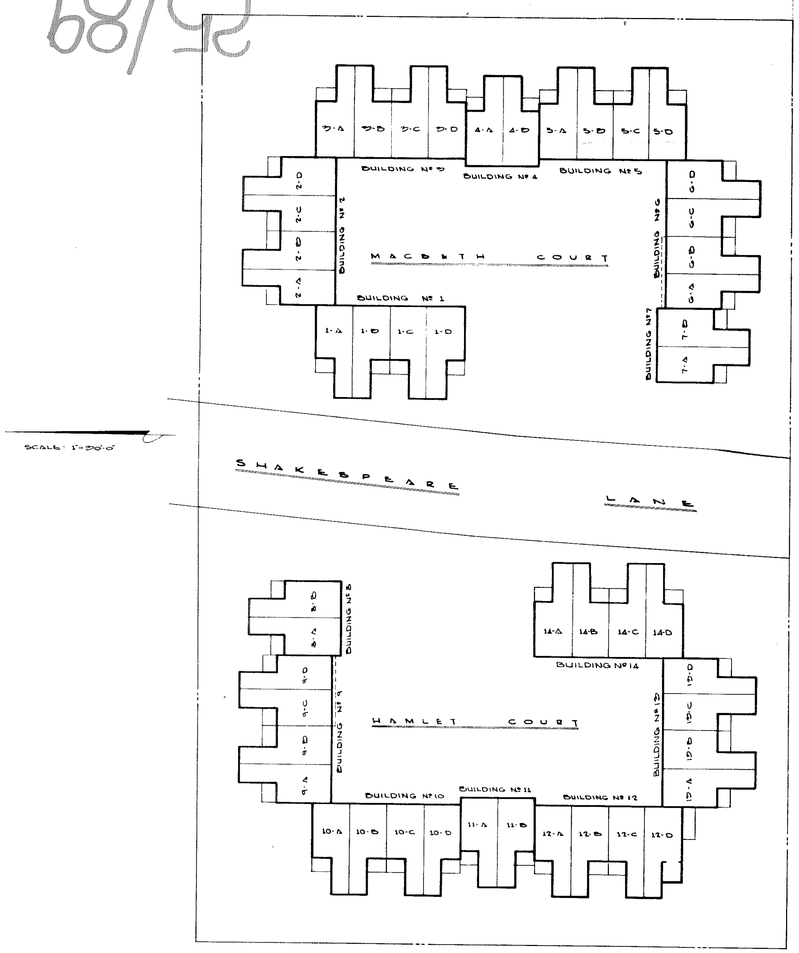

BUILDING DESIGNATION

NOTE: PATIOS ARE LIMITED COMON AREAS.

NOTE:
ALL PATIOS ARE TO BE 8" BELOW FIRST FLOOR AT BUILDING LINE. PITCH 2" DOWN FROM BUILDING

Plat Vol 25 Pg 89 #765768

BLDG.	SUITE	FINISHED FLOOR EL.	CLEAR CEILING HEIGHT 1ST FLOOR	CLEAR CEILING HEIGHT 2ND FLOOR
1	A	685.44	7'-11"	7'-10"
	B	685.44	7'-11"	7'-10"
	C	686.04	7'-11"	7'-10"
	D	686.05	7'-11"	7'-10"
2	A	684.14	7'-11"	7'-10"
	B	684.12	7'-11"	7'-10"
	C	684.10	7'-11"	7'-10"
	D	684.10	7'-11"	7'-10"
3	A	684.14	7'-11"	7'-10"
	B	684.14	7'-11"	7'-10"
	C	684.11	7'-11"	7'-10"
	D	684.13	7'-11"	7'-10"
4	A	684.75	7'-11"	7'-10"
	B	684.75	7'-11"	7'-10"
5	A	686.12	7'-11"	7'-10"
	B	686.12	7'-11"	7'-10"
	C	686.75	7'-11"	7'-10"
	D	686.70	7'-11"	7'-10"
6	A	687.45	7'-11"	7'-10"
	B	687.46	7'-11"	7'-10"
	C	687.45	7'-11"	7'-10"
	D	687.44	7'-11"	7'-10"
7	A	688.06	7'-11"	
	B	688.11	7'-11"	
8	A	689.12	7'-11"	8'-0½"
	B	689.12	7'-11"	8'-0½"
9	A	687.86	7'-11"	7'-10"
	B	687.52	7'-11"	7'-10"
	C	686.84	7'-11"	7'-10"
	D	686.80	7'-11"	7'-10"
10	A	688.84	7'-11"	7'-10"
	B	688.84	7'-11"	7'-10"
	C	690.14	7'-11"	7'-10"
	D	690.12	7'-11"	7'-10"
11	A	691.48	7'-11"	7'-10"
	B	691.50	7'-11"	7'-10"
12	A	692.14	7'-11"	7'-10"
	B	692.10	7'-11"	7'-10"
	C	693.40	7'-11"	7'-10"
	D	693.42	7'-11"	7'-10"
13	A	693.38	7'-11"	7'-10"
	B	693.38	7'-11"	7'-10"
	C	692.01	7'-11"	7'-10"
	D	692.01	7'-11"	7'-10"
14	A	690.05	7'-11"	7'-10"
	B	690.07	7'-11"	7'-10"
	C	691.38	7'-11"	7'-10"
	D	691.38	7'-11"	7'-10"

STATEMENT OF CERTIFICATION:
I CERTIFY THAT THE ATTACHED DRAWINGS CORRECTLY REPRESENT THE BUILDINGS AS CONSTRUCTED AND THAT THERE ARE NO ENCROACHMENTS ON ANY ABUTTING PREMISES.

STATE OF OHIO
ANDRE B. BUEHLER
1234
REGISTERED
ARCHITECT

ANDRE B. BUEHLER
REGISTERED ARCHITECT

STATEMENT OF CERTIFICATION:
I CERTIFY THAT THE ATTACHED DRAWINGS CORRECTLY REPRESENT THE DIMENSIONS OF THE BUILDINGS AS CONSTRUCTED AND THAT THERE ARE NO ENCROACHMENTS ON ANY ABUTTING PREMISES.

JAMES H. SCHMIDT
REGISTERED SURVEYOR

STRATFORD VILLAGE CONDOMINIUM NO. 1 FOR AVON REALTY INVESTMENT CO EXHIBIT "A"		BUILDING DESIGNATION	JOB NO. G991
SCALE: AS SHOWN	DATE: JUNE 29, 1970	PREPARED BY JAMES H. SCHMIDT REGISTERED SURVEYOR ELYRIA, OHIO	SHEET 3 OF
DESIGN:	CHECKED:		

25/89